


addendum

600140903

AK
U

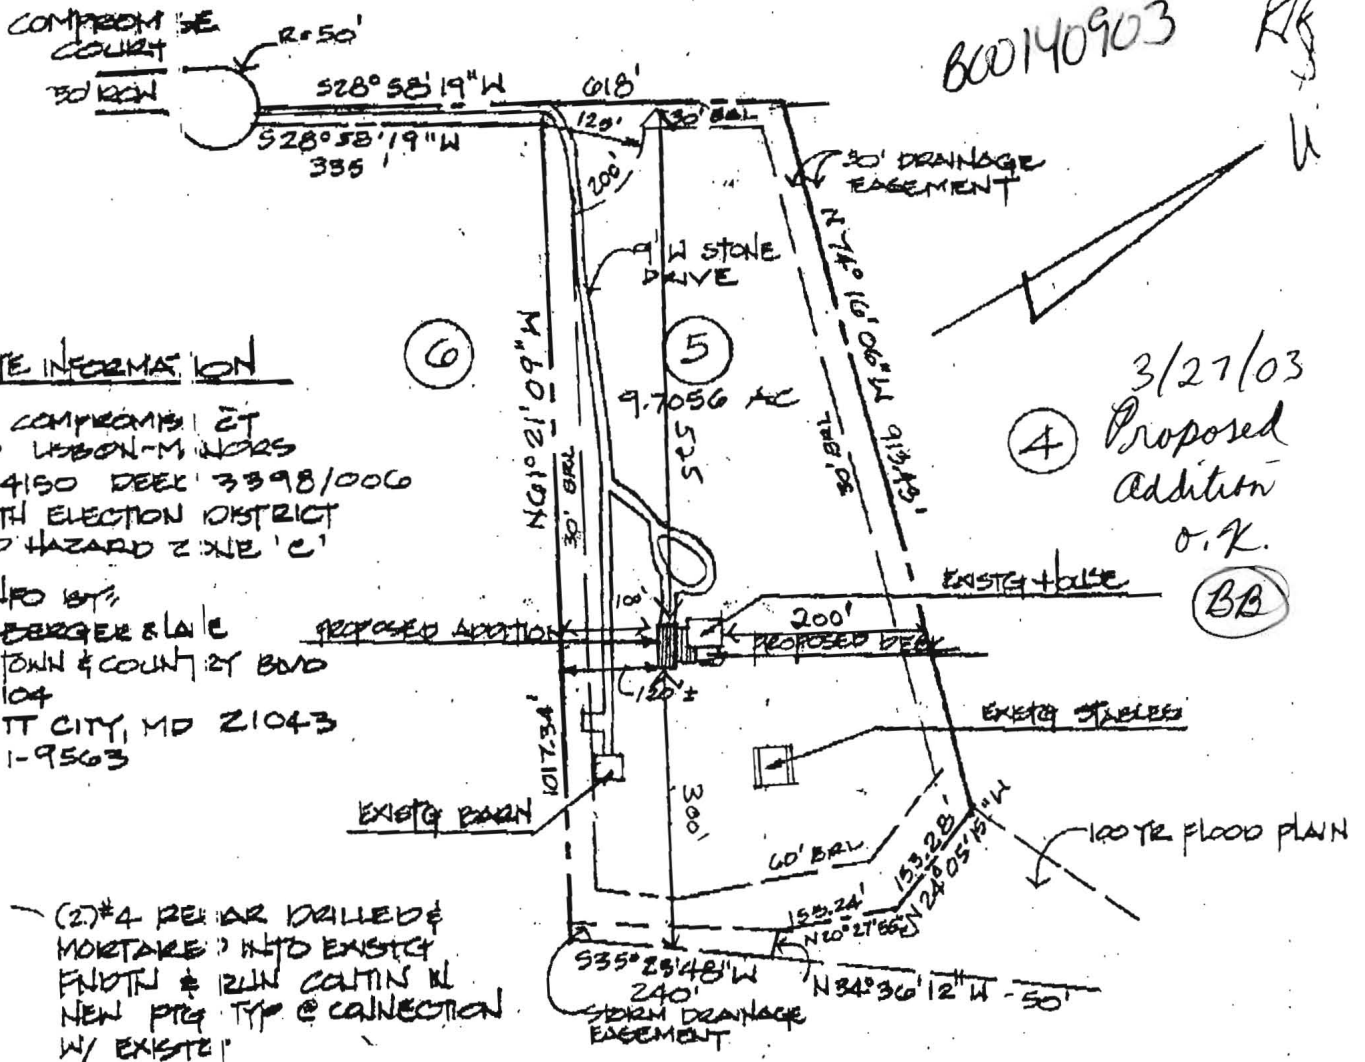


NOTE INFORMATION

COMPROMISE ET
 LEBON-MINORS
 4150 DEEL 3398/000
 TH ELECTION DISTRICT
 HAZARD ZONE 'C'
 TO BY
 BERGER & LAIC
 TOWN & COUNTY OF BMD
 104
 TT CITY, MD 21043
 1-9563

3/27/03
 Proposed Addition
 O.K.
 BB

(2) #4 REBAR DRILLED & MORTARED INTO EXISTING FOOTING & RUN CONTIN W/ NEW PTG TYP @ CONNECTION W/ EXISTING
 NEW CONDENSER SER & HP W/ DISCONNECTS

SITE PLAN 1"=20'

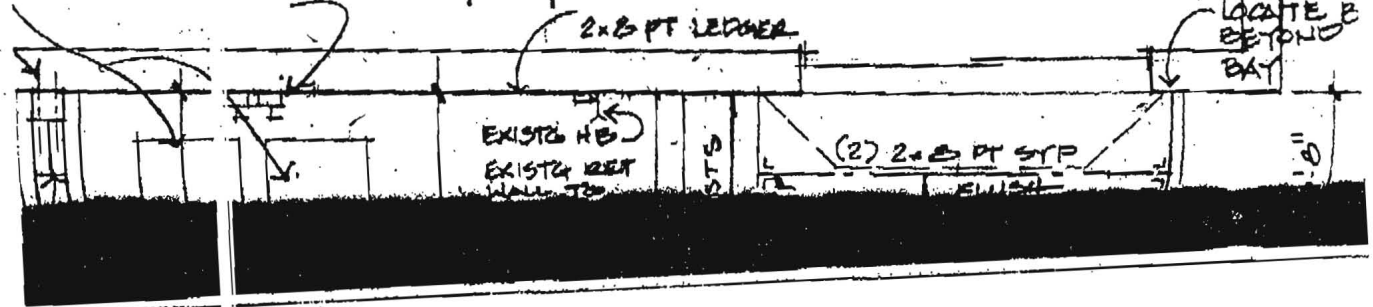

1140

545

8101

NEW PROPOSED
BARR 24X32

