

7/16/02.  
1:00

INDEXED

OWNER: Helen Foster

DATE REQUESTED: \_\_\_\_\_

PHONE #: 410-799-7194

CONTRACTOR: \_\_\_\_\_

ADDRESS: 7326 Cedar Ave

WELL TAG #: \_\_\_\_\_


Jessup -- 20794

COUNTY #: \_\_\_\_\_

PROPOSAL: support for County-financed H<sub>2</sub>O connection requested

INDEXED

06-401546

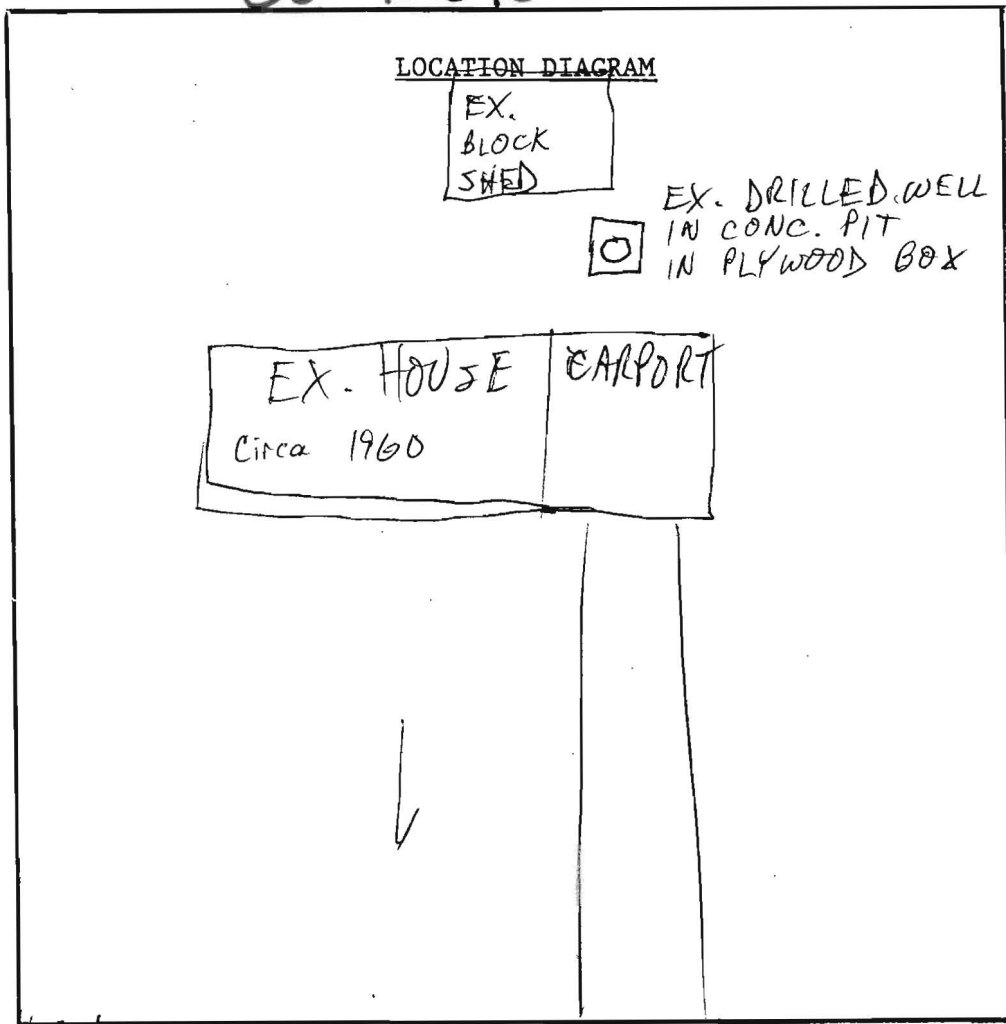

COMMENTS: 7/16/02 MET OWNER AT SITE; OWNER REPORTS SEDIMENT, ODOR AND QUANTITY PROBLEMS; ADVISED OWNER OF WELL AB. REQ'MENTS (NO STANDBY STATUS REQUESTED); ~~NO~~ LETTER TO BE SENT W/WELL DRILLER'S LIST

DATE: \_\_\_\_\_

INSPECTOR: \_\_\_\_\_

A518600-D



## HOWARD COUNTY HEALTH DEPARTMENT

Bureau of Environmental Health  
3525-H Ellicott Mills Drive, Ellicott City, Maryland 21043-4544  
(410) 313-2640 Fax (410) 313-2648  
TDD (410) 313-2323 Toll Free 1-877-4MD-DHMH

*Penny E. Borenstein, M.D., M.P.H., Acting County Health Officer*

July 17, 2002

### MEMORANDUM

TO: Mrs. Helen Foster  
7326 Cedar Lane  
Jessup, MD 20794

FROM: Mark Rifkin *MR*  
Well and Septic Program

RE: Request for County Financing of Water Connection  
7326 Cedar Lane

The Health Department recommends approval of County financing of the public water connection for the referenced property.

During an inspection conducted July 16, 2002, an existing concrete well pit was observed in the rear yard. Consistent with the history of such wells, you have reported sediment and odor problems as well as quantity problems. Remediation or treatment of the existing water supply is not likely to be successful and cost-effective.

The Health Department supports provision of an alternate water supply to the referenced property.

Once the public water connection is complete, please arrange for proper filling of the existing well by a well driller. A list of well drillers is enclosed.

MR  
cc: Charlotte Dryden, Office of Real Estate Services  
File