

A 578600-E



**TRINITY
HOMES**

*dedicated to excellence
and service*

TIM KEANE

7320 GRACE DRIVE
COLUMBIA, MD 21044



410-707-5739

FAX: 410-531-9467

10/8/99
1:30

SITE INSPECTION SHEET

Tim Keane

OWNER: Trinity Homes 707-5739 DATE REQUESTED: _____

PHONE #: _____ prev. owner Childs CONTRACTOR: _____


ADDRESS: 3143 Bethany Lane WELL TAG #: _____

INDEX!

COUNTY #: _____

PROPOSAL: demo of ex. house (on pub w/s), primary issue is old well

02-200597

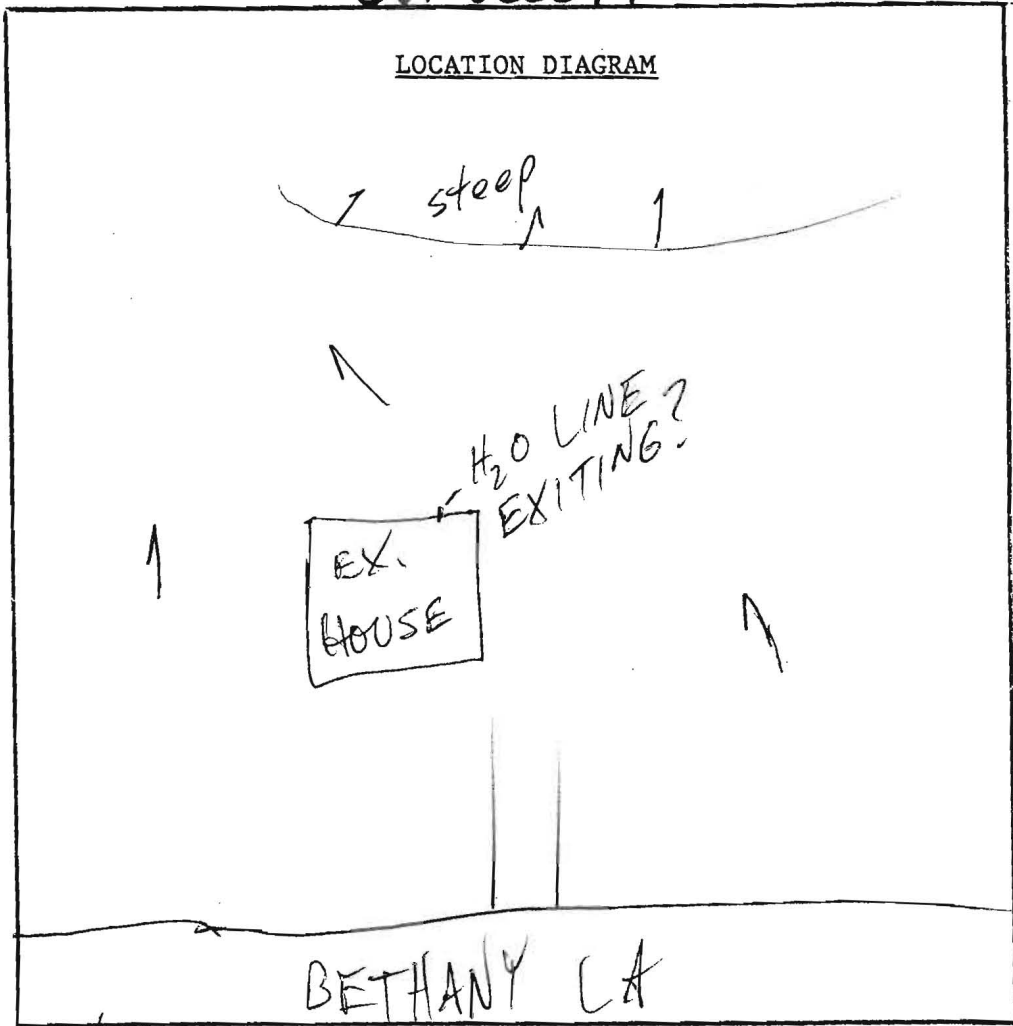

COMMENTS: 10/8/99 OLD HOUSE, WELL NOT LOCATED, BELIEVED TO BE IN REAR YARD; INSP OPPORTUNITY REQUESTED @ INITIAL DEMO STAGE (42)

DATE: _____ INSPECTOR: _____

518000-K



HOWARD COUNTY HEALTH DEPARTMENT

Diane L. Matuszak, M.D., M.P.H., County Health Officer

October 12, 1999

MEMORANDUM

TO: Tim Keane
c/o Trinity Homes
7320 Grace Drive
Columbia, MD 21044

FROM: Mark Rifkin, R.S. *MR*
Water & Sewerage Program
Bureau of Environmental Health

RE: 3143 Bethany Lane

This is to advise that the Howard County Health Department recommends issuance of the requested demolition permit for the above-referenced property.

You have advised that, during the initial stages of demolition, appropriate steps will be taken to locate the well which previously served the existing dwelling.

It is believed that the septic system which previously served the existing dwelling was properly abandoned at the time of connection to public utilities. If any septic system is located on the property during demolition, it is expected that an inspection will be requested.

MR