

C1 3804

SEQUENCE NO. (MDE USE ONLY)

STATE OF MARYLAND WELL COMPLETION REPORT

THIS REPORT MUST BE SUBMITTED WITHIN 45 DAYS AFTER WELL IS COMPLETED.

COUNTY NUMBER AS18602

(THIS NUMBER IS TO BE PUNCHED IN COLS. 3-6 ON ALL CARDS)

ST/CO USE ONLY DATE Received

DATE WELL COMPLETED 9 30 04 Depth of Well 22 200 (TO NEAREST FOOT)

PERMIT NO. FROM "PERMIT TO DRILL WELL" HO-44-4025

OWNER Trinity Homes Inc. STREET OR RFD Day Rd TOWN Sykesville SUBDIVISION Talley Prop SECTION LOT 4

WELL LOG table with columns: DESCRIPTION, FEET (FROM, TO), check if water bearing. Includes entries for Top Soil, Sandy, Sand Stone, MICKA, etc.

GROUTING RECORD WELL HAS BEEN GROUTED (Y) TYPE OF GROUTING MATERIAL (CM) BENTONITE CLAY (BC) NO. OF BAGS 9 NO. OF POUNDS 900

CASING RECORD MAIN CASING TYPE (PL) Nominal diameter top (main) casing (nearest inch) 6 Total depth of main casing (nearest foot) 22

OTHER CASING (if used) diameter inch depth (feet) from to

SCREEN RECORD screen type or open hole (HO) insert appropriate code below

NUMBER OF UNSUCCESSFUL WELLS: 0 WELL HYDROFRACTURED (Y) (N)

CIRCLE APPROPRIATE LETTER A A WELL WAS ABANDONED AND SEALED WHEN THIS WELL WAS COMPLETED

I HEREBY CERTIFY THAT THIS WELL HAS BEEN CONSTRUCTED IN ACCORDANCE WITH COMAR 26.04.04 "WELL CONSTRUCTION"

DRILLERS LIC. NO. M SD 112 DRILLERS SIGNATURE (MUST MATCH SIGNATURE ON APPLICATION)

LIC. NO. D

SITE SUPERVISOR (sign. of driller or journeyman responsible for sitework if different from permittee)


DEPTH (nearest ft.) 170 20 200 21 23 24 26 30 32 36 38 39 41 45 47 51

GRAVEL PACK IF WELL DRILLED WAS FLOWING WELL INSERT F IN BOX 68

MDE USE ONLY (NOT TO BE FILLED IN BY DRILLER) T (E.R.O.S.) W Q 70 72 74 75 76 TELESCOPE CASING LOG INDICATOR OTHER DATA

PUMPING TEST HOURS PUMPED (nearest hour) 3 PUMPING RATE (gal. per min.) 7.5 METHOD USED TO MEASURE PUMPING RATE Bucket WATER LEVEL (distance from land surface) BEFORE PUMPING 30 ft. WHEN PUMPING 49 ft. TYPE OF PUMP USED (for test) S submersible

PUMP INSTALLED DRILLER INSTALLED PUMP (YES) (NO) IF DRILLER INSTALLS PUMP, THIS SECTION MUST BE COMPLETED FOR ALL WELLS. TYPE OF PUMP INSTALLED PLACE (A,C,J,P,R,S,T,O) IN BOX 29. CAPACITY: GALLONS PER MINUTE (to nearest gallon) 31 35 PUMP HORSE POWER 37 41 PUMP COLUMN LENGTH (nearest ft.) 43 47 CASING HEIGHT (circle appropriate box and enter casing height) (+) above LAND SURFACE (-) below 2 (nearest foot)

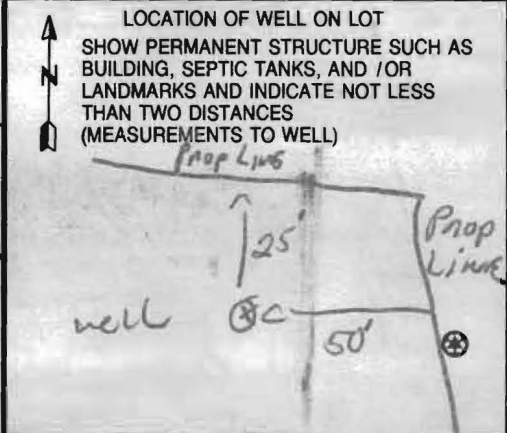

B 1 2348

SEQUENCE NO. (MDE USE ONLY)

STATE OF MARYLAND APPLICATION FOR PERMIT TO DRILL WELL please type W520873 +520878

STATE PERMIT NUMBER HO-94-4025 fill in this form completely

OWNER INFORMATION Date Received (APA) 8 MM DD YY 13 TRINITY QUALITY HOMES INC 15 Last Name Owner First Name 34 3675 PARK AVE. Suite 301 36 Street or RFD 55 ELLICOTT CITY MD. 21043 57 Town 70 State 72 Zip 76

LOCATION OF WELL B 3 HOWARD COUNTY 8 21 TALLEY PROPERTY 23 SUBDIVISION 42 SECTION 44 46 LOT 4 48 50 SYKESVILLE 52 NEAREST TOWN 71 MILES FROM TOWN (enter 0 if in town) 2 MI 73 76 77 78

DRILLER INFORMATION RALPH E. MAYNE MSD 117 76 License No. 81 RALPH E. MAYNE INC Firm Name 17024 HANDY ROAD MT. AIRY MD. 21071 Address R. E. Mayne Set 5 2004 Signature Date

DIRECTION OF WELL FROM TOWN (CIRCLE BOX) DAY ROAD 11 NEAR WHAT ROAD 30 ON WHICH SIDE OF ROAD (CIRCLE APPROPRIATE BOX) NORTH 32 EAST 34 600 37 DISTANCE FROM ROAD 38 39 ENTER FT OR MI 38 39 TAX MAP: 9 BLK: 4 PARCEL 316

WELL INFORMATION B 2 APPROX. PUMPING RATE 5 GAL. PER MIN. 8 12 AVERAGE DAILY QUANTITY NEEDED 500 GAL. PER DAY 14 20

USE FOR WATER (CIRCLE APPROPRIATE BOX) D DOMESTIC POTABLE SUPPLY & RESIDENTIAL IRRIGATION F FARMING (LIVESTOCK WATERING & AGRICULTURAL IRRIGATION) I INDUSTRIAL, COMMERCIAL, DEWATERING P PUBLIC WATER SUPPLY WELL T TEST, OBSERVATION, MONITORING G GEO-THERMAL

NOT TO BE FILLED IN BY DRILLER HEALTH DEPARTMENT APPROVAL HOWARD COUNTY 1518602 COUNTY NAME COUNTY NO. STATE SIGNATURE INSERT S DATE ISSUED 9/17/04 CO SIGNATURE EXP. DATE 9/17/05 43 MM DD YY 48 50 55 57 63

APPROXIMATE DEPTH OF WELL 150 FEET 24 28 APPROXIMATE DIAMETER OF WELL 6" NEAREST INCH

SHOW MAJOR FEATURES OF BOX & LOCATE WELL WITH AN X SOURCES OF DRILLING WATER 1. well 2. 3. WRITE THE BOX NUMBER FROM THE MAP HERE E 54051 N 810 000 000

METHOD OF DRILLING (circle one) BORED (or Augered) JETTED Jetted & DRIVEN AIR-ROTary AIR-PERCussion ROTARY (Hydraulic Rotary) 30 CABLE REVERSE-ROTary DRIVE-POINT 37 other

REPLACEMENT OR DEEPEMED WELLS (CIRCLE APPROPRIATE BOX) N THIS WELL WILL NOT REPLACE AN EXISTING WELL Y THIS WELL WILL REPLACE A WELL THAT WILL BE ABANDONED AND SEALED S THIS WELL WILL REPLACE A WELL THAT WILL BE USED AS A STANDBY-CONTACT LOCAL APPROVING AUTHORITY FOR POLICY ON STANDBY WELLS D THIS WELL WILL DEEPEN AN EXISTING WELL PERMIT NUMBER OF WELL TO BE REPLACED OR DEEPEMED (IF AVAILABLE) 41 52

DRAW A SKETCH BELOW SHOWING LOCATION OF WELL IN RELATION TO NEARBY TOWNS AND ROADS AND GIVE DISTANCE FROM WELL TO NEAREST ROAD JUNCTION DAY ROAD 1000' well MD 32

Not to be filled in by driller (MDE OR COUNTY USE ONLY) APPROX. PERMIT NUMBER PERMIT No. HO-94-4025 70 71 72 73 74 75 76 77 78 79

SPECIAL CONDITIONS NOTE APPROVING AUTHORITIES SHOULD USE SEPARATE SHEET IF NEEDED



\*\*\*\*\*  
 WATER WELL ABANDONMENT-SEALING REPORT FORM  
 \*\*\*\*\*

SUBMIT COPIES OF COMPLETED FORM TO:

- \* COUNTY ENVIRONMENT AGENCY (contact MDE, WMA if address needed)
- \* WELL OWNER
- \* MDE, WATER MANAGEMENT ADMINISTRATION, WELL PROGRAM

DATE WELL ABANDONED: JUNE 9 2006 (month/day/year)

\* PERMIT NUMBER OF ABANDONED WELL (if any)

91-  
 9/24/00  
 O.K. (CB)  
 HO-94-4025

\* PERMIT NUMBER OF REPLACEMENT WELL

HO-95-0384

\* PERSON ABANDONING WELL: Ralph E Mayne


WELL DRILLERS LICENSE NUMBER: \_\_\_\_\_

\* OWNER'S NAME: Trinity Fidelity Homes

CIRCLE: MWD/MSD/MGD

\* WELL LOCATION:

COUNTY: Howard  
 NEAREST TOWN: SYLKESVILLE  
 TAX MAP 9 BLOCK 4 PARCEL 316  
 SUBDIVISION: TALLEY Prop  
 SECTION: \_\_\_\_\_ LOT: 4

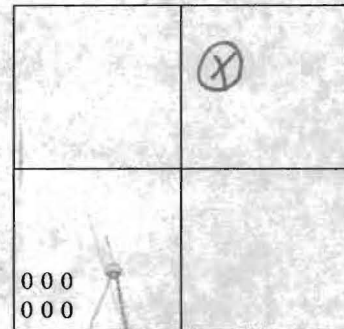

SHOW WELL LOCATION BY X WITHIN BOX

MARYLAND GRID COORDINATES

E 551  
 BOX NUMBER  
 N 810

\* TYPE OF WELL BEING ABANDONED:

- DRILLED
- BORED/AUGURED
- OTHER (specify) \_\_\_\_\_
- JETTED
- HAND DUG

\* USE CODE:

- DOMESTIC
- IRRIGATION
- TEST/OBSERVATION
- MUNICIPAL/PUBLIC INDUSTRIAL

\* TYPE OF CASING:

- STEEL
- CONCRETE
- PLASTIC
- OTHER (specify) \_\_\_\_\_

\* SIZE OF CASING: 6 7/8 INCHES IN DIAMETER

\* DEPTH OF WELL: 100 FEET DEEP

\* WAS ANY CASING REMOVED?  YES \_\_\_\_\_ NO  
 if yes, length removed, in feet: 2 ft.

\* WAS CASING RIPPED OR PERFORATED? \_\_\_\_\_ YES  NO

LOG OF SEALING MATERIAL

MATERIAL	FEET	
	FROM	TO
Cement	100	2
Top Soil	2	0

SIGNATURE-MASTER WELL DRILLER OR SUPERVISING SANITARIAN

LICENSE #


MWD/MSD/MGD June 9 2006

CIRCLE ONE

DATE





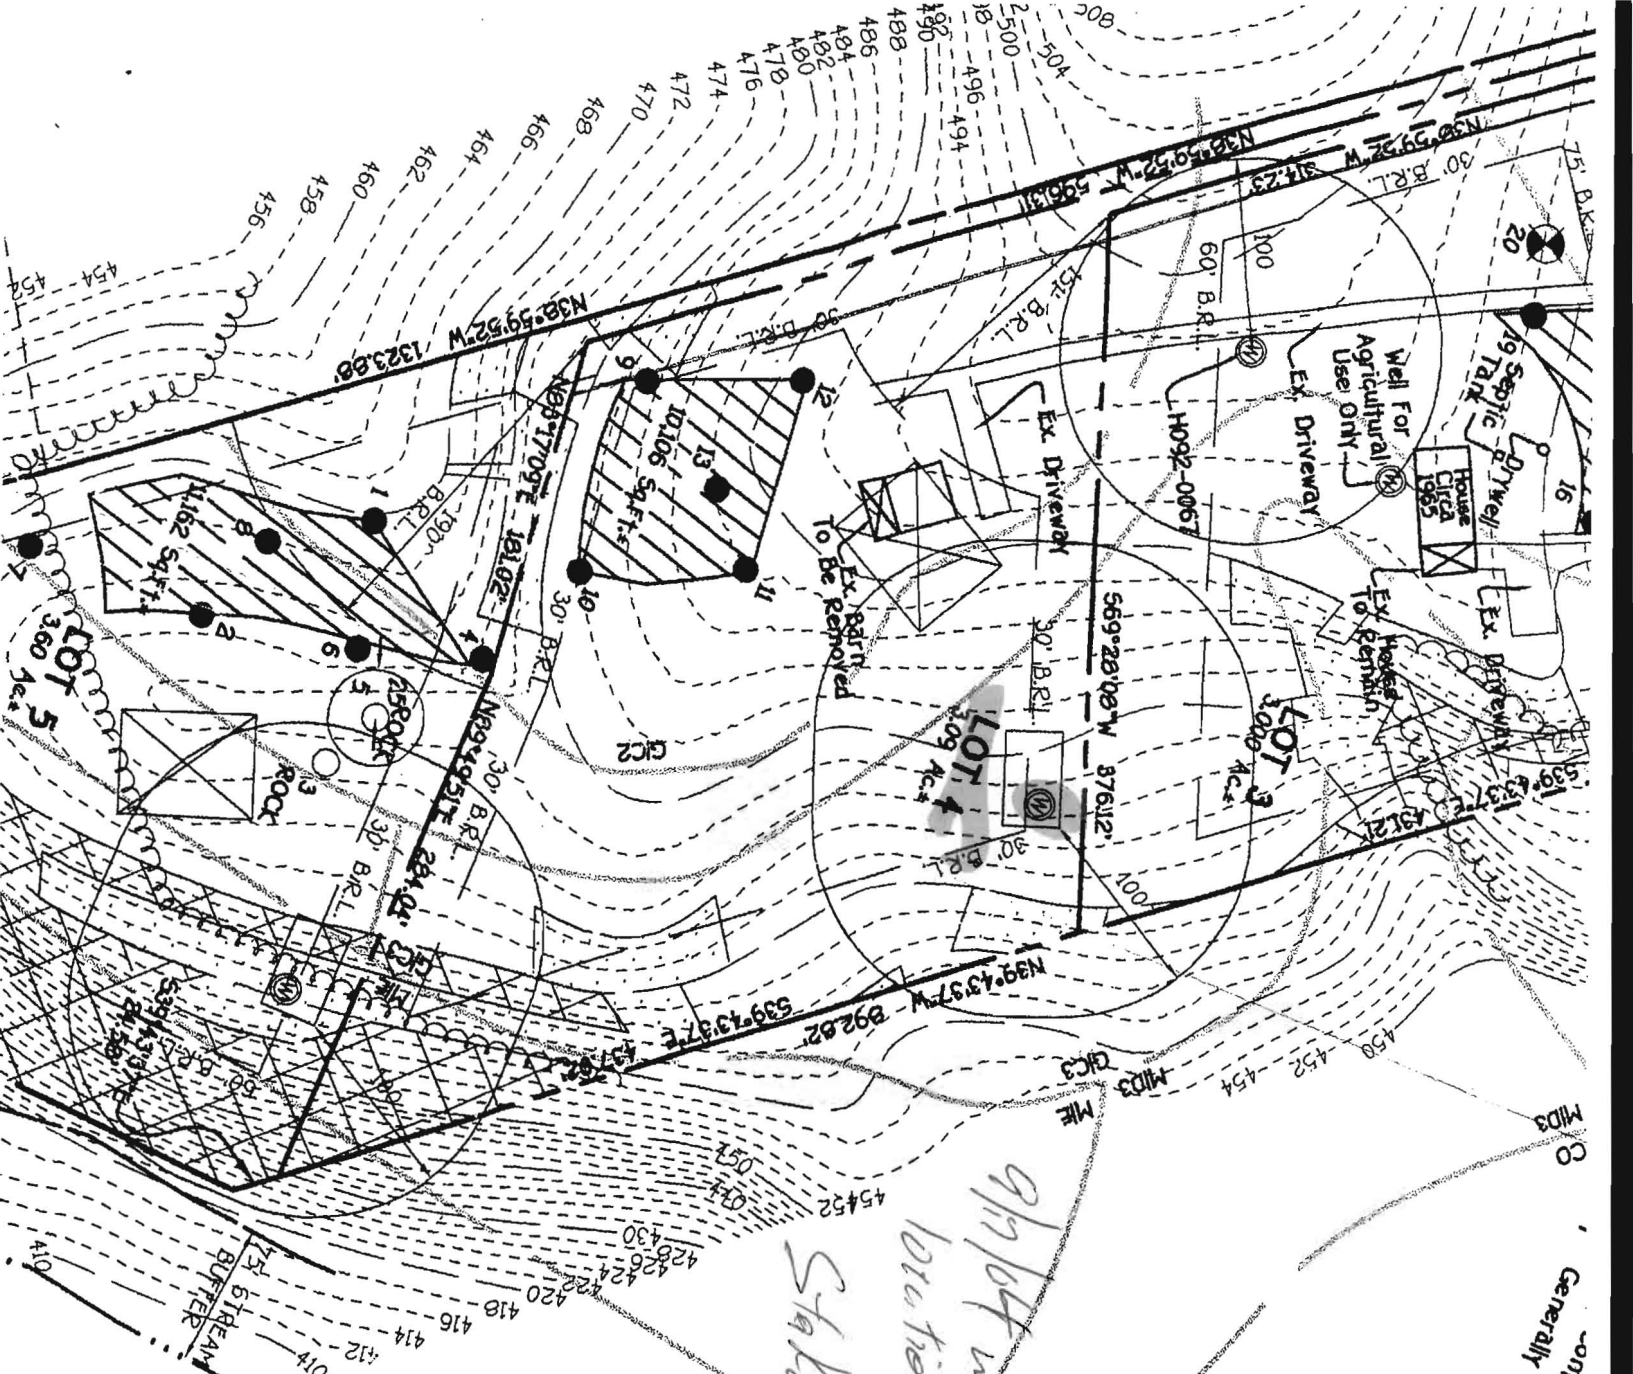

PROPERTY OF  
LIBER SALLY ROBY  
(4825 DAY ROAD 711)  
ZONED: RC-DEO

*Shaded by MDA  
Location of Well*

-dry eroded  
 -erely eroded  
 -slopes, severely eroded  
 -percent slopes, moderately eroded  
 -and/or contains hydric inclusions  
 -Generally only within 100-year floodplain areas

**GENERAL**

1. OF 10,000 SQ. FT. THIS DEPARTMENT SHALL RESTRICTED EASEMENTS TO A PUBLIC PRIVATE SEWERAGE SYSTEM THE LOT SK. DEPARTMENT EXISTING INFORMATION OF THE PROPERTY ALL HOUSE REGULATIONS TOPOGRAPHY INTERPRETATION BE CORRECT IN FIGURE COLL THE PIT WELL LOT 3 WELL THE EXISTING A NEW SW.
2. THE LOT SK. DEPARTMENT EXISTING INFORMATION OF THE PROPERTY ALL HOUSE REGULATIONS TOPOGRAPHY INTERPRETATION BE CORRECT IN FIGURE COLL THE PIT WELL LOT 3 WELL THE EXISTING A NEW SW.
3. THE LOT SK. DEPARTMENT EXISTING INFORMATION OF THE PROPERTY ALL HOUSE REGULATIONS TOPOGRAPHY INTERPRETATION BE CORRECT IN FIGURE COLL THE PIT WELL LOT 3 WELL THE EXISTING A NEW SW.
4. THE LOT SK. DEPARTMENT EXISTING INFORMATION OF THE PROPERTY ALL HOUSE REGULATIONS TOPOGRAPHY INTERPRETATION BE CORRECT IN FIGURE COLL THE PIT WELL LOT 3 WELL THE EXISTING A NEW SW.
5. THE LOT SK. DEPARTMENT EXISTING INFORMATION OF THE PROPERTY ALL HOUSE REGULATIONS TOPOGRAPHY INTERPRETATION BE CORRECT IN FIGURE COLL THE PIT WELL LOT 3 WELL THE EXISTING A NEW SW.
6. THE LOT SK. DEPARTMENT EXISTING INFORMATION OF THE PROPERTY ALL HOUSE REGULATIONS TOPOGRAPHY INTERPRETATION BE CORRECT IN FIGURE COLL THE PIT WELL LOT 3 WELL THE EXISTING A NEW SW.
7. THE LOT SK. DEPARTMENT EXISTING INFORMATION OF THE PROPERTY ALL HOUSE REGULATIONS TOPOGRAPHY INTERPRETATION BE CORRECT IN FIGURE COLL THE PIT WELL LOT 3 WELL THE EXISTING A NEW SW.
8. THE LOT SK. DEPARTMENT EXISTING INFORMATION OF THE PROPERTY ALL HOUSE REGULATIONS TOPOGRAPHY INTERPRETATION BE CORRECT IN FIGURE COLL THE PIT WELL LOT 3 WELL THE EXISTING A NEW SW.
9. THE LOT SK. DEPARTMENT EXISTING INFORMATION OF THE PROPERTY ALL HOUSE REGULATIONS TOPOGRAPHY INTERPRETATION BE CORRECT IN FIGURE COLL THE PIT WELL LOT 3 WELL THE EXISTING A NEW SW.