

APPLICATION

112100

A _____

P _____

SEWAGE DISPOSAL TESTING

MARYLAND STATE DEPARTMENT OF HEALTH

HOWARD COUNTY

ELLICOTT CITY

DISTRICT 3

DATE 8/17/66

TO: THE COUNTY HEALTH OFFICER
ELLICOTT CITY, MARYLAND

I, HEREBY, APPLY FOR THE NECESSARY TESTS IN ORDER TO CONSTRUCT (OR RECONSTRUCT) A SEWAGE DISPOSAL SYSTEM.

PROPERTY OWNER Carwell, Inc.

ADDRESS 177 Chatham Rd., Ellicott City, Md. PHONE HO 5-2642

PROPERTY LOCATION:

SUBDIVISION Green Henge LOT NO. 25, Sec. 4

ROAD AND DESCRIPTION Evergreen Way

OCCUPANT _____ PHONE _____

PERSON TO CONSTRUCT SYSTEM _____

ADDRESS _____ PHONE _____

SIZE OF LOT 258' x 132' x 150' x 340' x 90' x 65' TYPE BLDG. 3 or 4

NUMBER OF BEDROOMS

IF NOT SINGLE RESIDENCE DESCRIBE _____

SIGNATURE OF APPLICANT /s/ Mr. Sutherland

APPROVED BY _____ FOR _____ DATE _____

(KIND OF SYSTEM)


REJECTED BY F. Sherrin FOR conventional DATE 5/20/85

(KIND OF SYSTEM)

HOLD PENDING FURTHER TESTS 8/15/66 DATE 8/15/66

REASONS FOR REJECTION OR HOLDING 8/15/66 - no pipe - shallow - under at off - down

THIS IS NOT A PERMIT

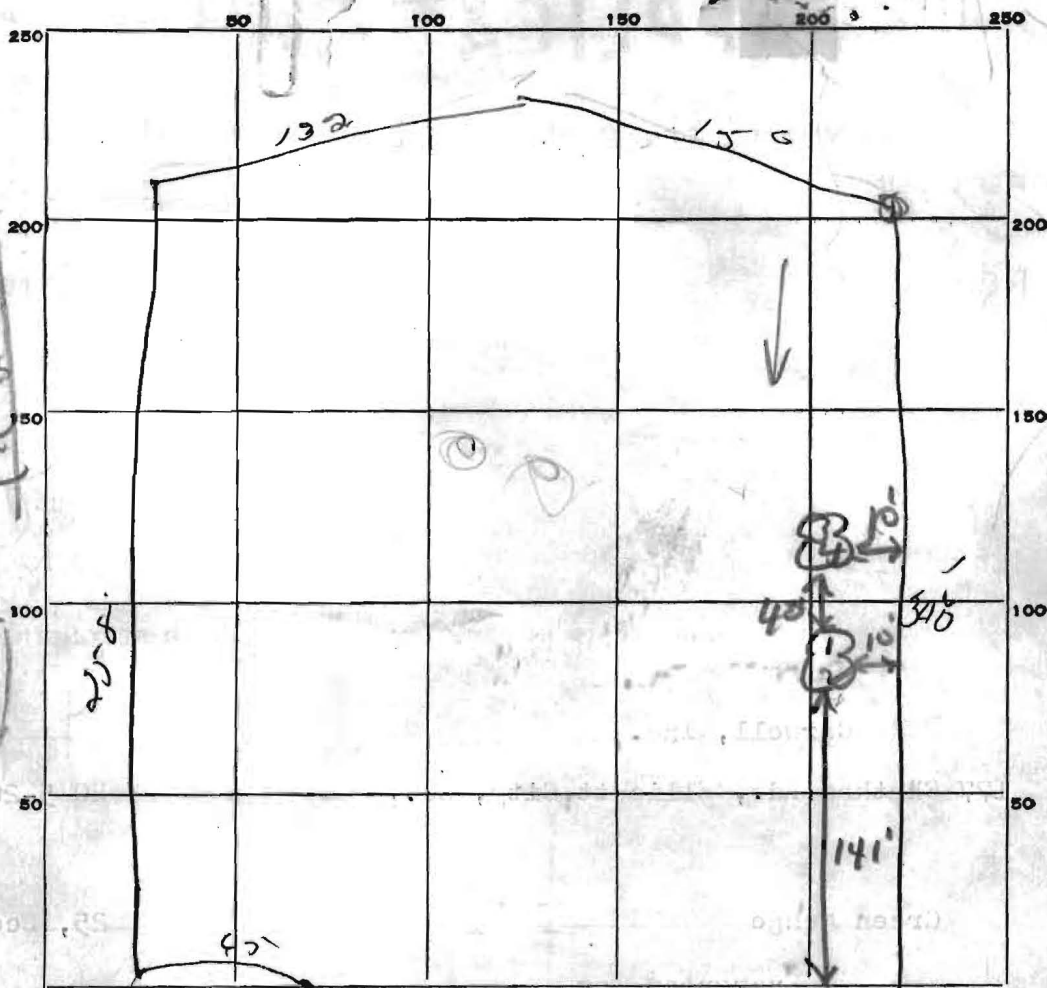

INDICATE NORTH - NAME ADJOINING ROADWAY AS BASE LINE

Evergreen Way

See attached
Drawings
Lot lines
changed

DATE	TEST NO.	DEPTH	PRE-WET		TEST - 1" DROP		TIME	
			START	STOP	START	STOP		
8/18/66	1	4'	1:59					
	2	9'	2:03	2:06	2:06	2:10	4 min	
	3	4'	} Water at 9'					
	4	9'						
8/27/85	5S	2 1/2	141	151	151	216	25	
	5X	12	WATER 11 1/2 FT					
	6S	2	146	206	206	239	33	
	6V	12	LOOKS DOUBTFUL					
	7S	2 1/2	156	219	219	307	47	
	7V	13	LOOKS DOUBTFUL					
	8V	12	SEE ELEVATION TOO HIGH					
	6M	4	310	400	1st inch	50 MIN		
	7M	4	319	347	347	417	30	
	9V		WATER					

SOIL AUGER FINDING

TESTED BY

REMARKS

8/18/66. Dig 6 more holes 6' shallow 12' deep.
 JHK + DM
 Ronald B Carter

Lot 25

103 Bilt

5
 1
 2
 CLAY
 HARD SAND
 FEW ROOTS
 1/2
 2
 WATER

6
 2
 CLAY SAND MIX
 4
 HARD SAND
 12

7
 2
 CLAY SAND MIX
 4
 HARD SAND

8
 5
 CLAY SAND
 SAND

9
 CLAY
 SAND
 11
 WATER

340

5
 9

Preliminary

APPLICATION

SEWAGE DISPOSAL TESTING

MARYLAND STATE DEPARTMENT OF HEALTH

HOWARD COUNTY

ELLICOTT CITY

DISTRICT 3

DATE 8/17/66

A 12100

P _____

TO: THE COUNTY HEALTH OFFICER
ELLICOTT CITY, MARYLAND

I, HEREBY, APPLY FOR THE NECESSARY TESTS IN ORDER TO CONSTRUCT (OR RECONSTRUCT) A SEWAGE DISPOSAL SYSTEM.

PROPERTY OWNER Carwell, Inc.

ADDRESS 177 Chatham Rd., Ellicott City, Md. PHONE HO 5-2642

PROPERTY LOCATION:

SUBDIVISION Green Henge LOT NO. 25, Sec. 4

ROAD AND DESCRIPTION Evergreen Way

OCCUPANT _____ PHONE _____

PERSON TO CONSTRUCT SYSTEM _____

ADDRESS _____ PHONE _____

SIZE OF LOT 258' x 132' x 150' x 340' x 90' x 65' TYPE BLDG. 3 or 4
NUMBER OF BEDROOMS

IF NOT SINGLE RESIDENCE DESCRIBE _____

SIGNATURE OF APPLICANT /s/ Mr. Sutherland


APPROVED BY _____ FOR _____ DATE _____
(KIND OF SYSTEM)

REJECTED BY _____ FOR _____ DATE _____
(KIND OF SYSTEM)

HOLD PENDING FURTHER TESTS Sum J #12 DATE 8/18/66

REASONS FOR REJECTION OR HOLDING 8/18/66 - on spec - shallow - water at eff during

THIS IS NOT A PERMIT

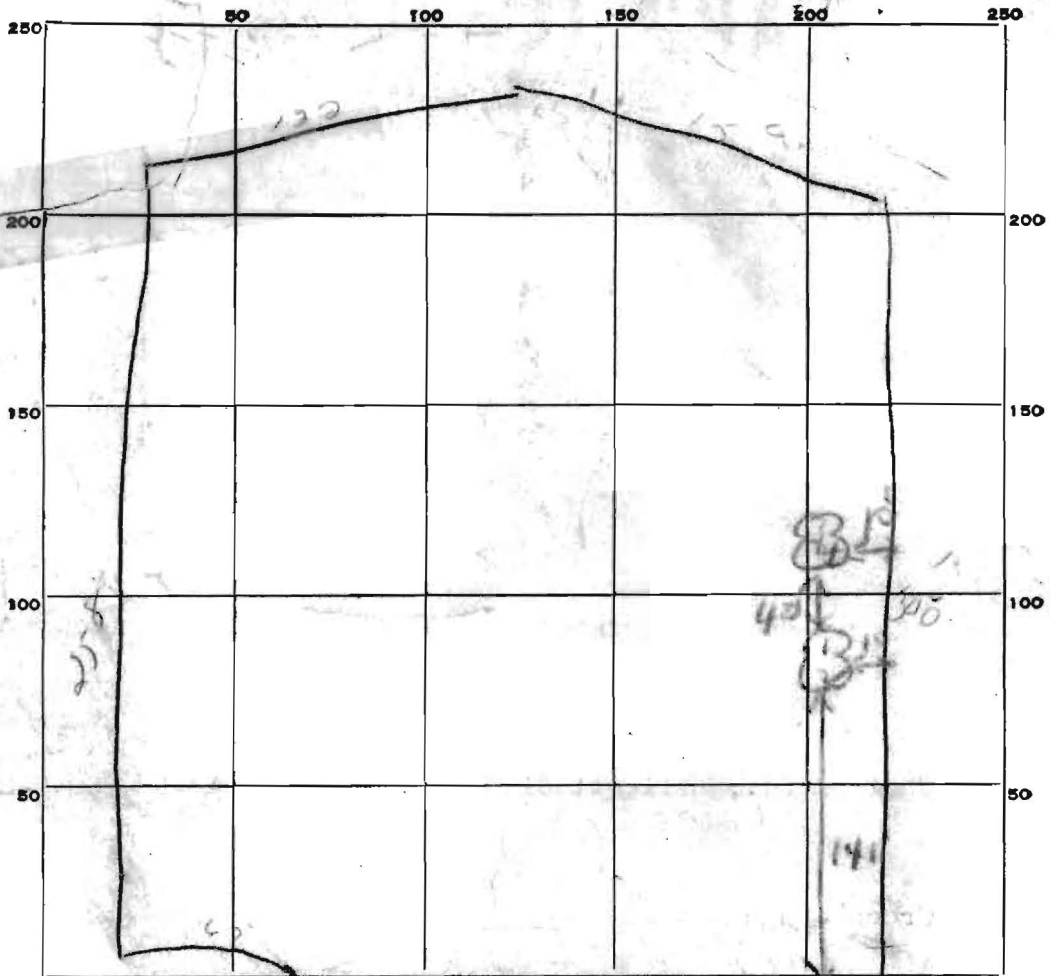

INDICATE NORTH - NAME ADJOINING ROADWAY AS BASE LINE.

Evergreen Way

DATE	TEST NO.	DEPTH	PRE-WET		TEST - 1" DROP		TIME
			START	STOP	START	STOP	
<i>8/14/60</i>	1	4'	1:59				
	2	9'	2:03	2:06	2:06	2:10	<i>4:00</i>
	3	4'	} Water at 9'				
	4	9'					

SOIL AUGER FINDING *8/14/60 by [unclear] 6' [unclear]*

TESTED BY *JHR DM*

REMARKS *Found [unclear]*

14
60
79
41
U

Loss

APPLICATION

11210

A 1210
P _____

SEWAGE DISPOSAL TESTING

MARYLAND STATE DEPARTMENT OF HEALTH

HOWARD COUNTY

ELLICOTT CITY

DISTRICT 3

DATE 8/19/66

TO: THE COUNTY HEALTH OFFICER
ELLICOTT CITY, MARYLAND

I, HEREBY, APPLY FOR THE NECESSARY TESTS IN ORDER TO CONSTRUCT (OR RECONSTRUCT) A SEWAGE DISPOSAL SYSTEM.

PROPERTY OWNER Carwell, Inc.

ADDRESS 177 Chatham Rd., Ellicott City, Md. PHONE HO 5-2642

PROPERTY LOCATION:

SUBDIVISION Green Henge LOT NO. 25, Sec. 4

ROAD AND DESCRIPTION Evergreen Way

OCCUPANT _____ PHONE _____

PERSON TO CONSTRUCT SYSTEM _____

ADDRESS _____ PHONE _____

SIZE OF LOT 258' x 132' x 150' x 340' x 90' x 65' TYPE BLDG. 3 or 4
NUMBER OF BEDROOMS

IF NOT SINGLE RESIDENCE DESCRIBE _____

SIGNATURE OF APPLICANT /s/ Mr. Sutherland

APPROVED BY _____ FOR _____ DATE _____
(KIND OF SYSTEM)

REJECTED BY F. Sherrin FOR converted DATE 5/20/85
(KIND OF SYSTEM)

HOLD PENDING FURTHER TESTS awaiting HIC DATE 8/15/66

REASONS FOR REJECTION OR HOLDING depth in pipe shall be under at 4ft above

THIS IS NOT A PERMIT

