

5/12/03 2:30pm

PUB. SEWER STATUS VERIFIED BY \_\_\_\_\_

ISSUE DATE: 4/9/03  
APPROVAL DATE: 5/12/03

# PERMIT

P 518620  
A REPAIR

## ON-SITE SEWAGE DISPOSAL SYSTEM HOWARD COUNTY HEALTH DEPARTMENT BUREAU OF ENVIRONMENTAL HEALTH

*Payment* → *Permit transferred from 7302 MEADOW WOOD WAY*  
*not bond*

Hatfield's Equipment IS PERMITTED TO INSTALL  ALTER

ADDRESS: 13785 Burntwoods Road, Glenelg PHONE NUMBER: 301-854-6172

SUBDIVISION: Linden Chapel Hills LOT NUMBER: 11, Bl D, S3

ADDRESS: 5000 Morning Star Drive PROPERTY OWNER: Lewis Cotton

SEPTIC TANK CAPACITY (GALLONS): FX 1000

PUMP CHAMBER CAPACITY (GALLONS): N/A

NUMBER OF BEDROOMS: 3

SQUARE FEET PER BEDROOM: 180'

LINEAR FEET OF TRENCH REQUIRED: 78'

TRENCHES:	Trench to be 2' feet wide. Inlet <sup>4 1/2'</sup> feet below original grade. Bottom maximum depth 10' feet below original grade. Effective area begins at 5' feet below original grade. 5.5' feet of stone below distribution pipe.
LOCATION:	<i>Place D.B between ST &amp; DW. Use speed level boxes &amp; set old D.W. higher</i>
PURPOSE:	Septic system has failed. Call for inspection when ground is opened so sanitarian can recommend repair.


PLANS APPROVED: *John [Signature]* DATE: 4/17/03

- NOTE: PERMIT VOID AFTER 2 YEARS
- NOTE: CONTRACTOR RESPONSIBLE FOR SCHEDULING A PRE-CONSTRUCTION INSPECTION FOR ALL INSTALLATIONS
- NOTE: WATERTIGHT SEPTIC TANKS REQUIRED
- NOTE: ALL PARTS OF SEPTIC SYSTEM SHALL BE 100 FEET FROM ANY WATER WELL
- NOTE: MANHOLE RISERS REQUIRED ON ALL SEPTIC TANKS AND PUMP CHAMBERS

**NEITHER THE HOWARD COUNTY COUNCIL NOR THE HEALTH DEPARTMENT IS RESPONSIBLE FOR THE SUCCESSFUL OPERATION OF ANY SYSTEM PERMITTEE RESPONSIBLE FOR OBTAINING FINAL APPROVAL ON THIS PERMIT CALL 410-313-2640 FOR INSPECTION OF SEPTIC SYSTEM**

P518620

NOT TO SCALE

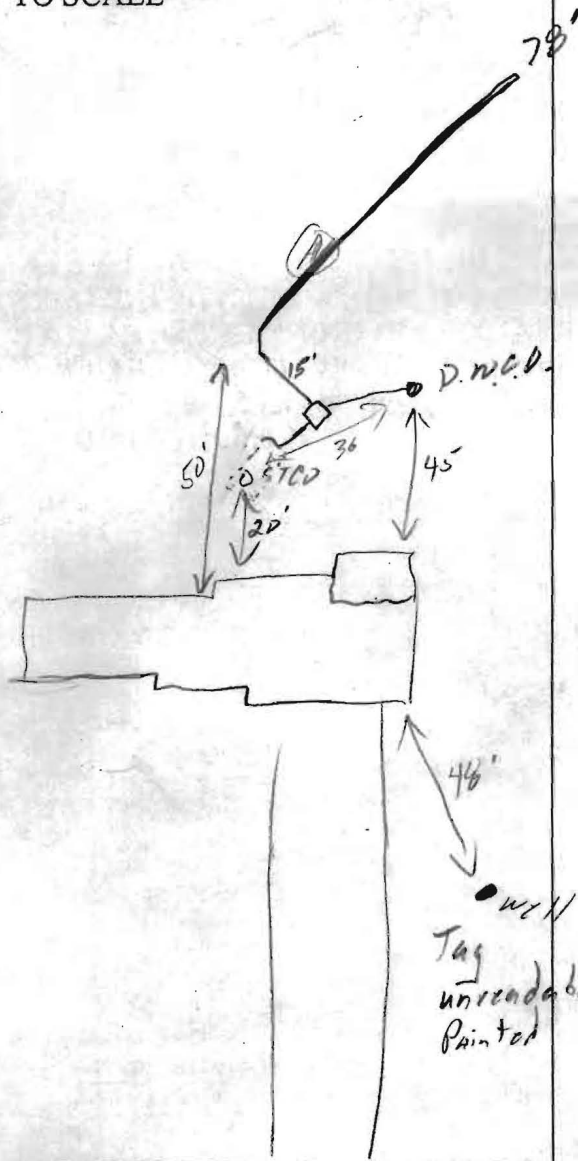

TRENCH/DRAINFIELD DATA		
WIDTH	INLET	BOTTOM
2'	5'	10.5'
NUMBER OF TRENCHES		1
TOTAL LENGTH		78'
ABSORPTION AREA _____		
DISTRIBUTION BOX LEVEL <input checked="" type="checkbox"/>		
DISTRIBUTION BOX BAFFLE <input checked="" type="checkbox"/>		
DISTRIBUTION BOX PORT _____		

SEPTIC TANK DATA	
SEPTIC TANK 1 LEVEL	No
CAPACITY	Ex 1000 GAL
SEAM LOC	Mid
TANK LID DEPTH	4'
BAFFLES	New outlet
BAFFLE FILTER	_____
MANHOLE LOC	_____
6" PORT LOC	_____
WATERTIGHT TEST	_____
SEPTIC TANK 2 LEVEL _____	
CAPACITY	_____ GAL
SEAM LOC	_____
TANK LID DEPTH	_____
BAFFLES	_____
BAFFLE FILTER	_____
MANHOLE LOC	_____
6" PORT LOC	_____
WATERTIGHT TEST	_____

Morming Star

ROAD

PRE-CONSTRUCTION 4/17/03 Dug PVC hole, see PVC sheet.

INSTALLATION 5/12/03 Couldn't get 4.5' in vent, tank out too low  
 5' inlet OK. OK to cover all work (50)

FINAL INSPECTOR [Signature]

DATE OF APPROVAL 5/12/03