

PRELIMINARY

APPLICATION

A 18009

SEWAGE DISPOSAL TESTING

STATE OF MARYLAND - DEPARTMENT OF HEALTH AND MENTAL HYGIENE

HOWARD COUNTY HEALTH DEPARTMENT
ENVIRONMENTAL HEALTH SERVICES
P. O. BOX 478, ELLICOTT CITY, MARYLAND 21043
TELEPHONE: 468-8688, EXT. 358

DISTRICT XXI 5th

DATE 2/23/73

TO: THE COUNTY HEALTH OFFICER
ELLICOTT CITY, MARYLAND

I, HEREBY, APPLY FOR THE NECESSARY TEST IN ORDER TO CONSTRUCT (OR RECONSTRUCT) A SEWAGE DISPOSAL SYSTEM.

PROPERTY OWNER Ashton Realty Company

ADDRESS Ashton, Maryland 20702

Call Mr. Johnson:
PHONE 924-4811

PROPERTY LOCATION:

SUBDIVISION Linden Chapel Hills LOT NO. 11, Blk, D, Sect, 3

ROAD AND DESCRIPTION Morningstar Drive

SIZE OF LOT 40,500 sq. ft. TYPE BLDG. 3 or 4 bedrooms

NUMBER OF BEDROOMS

IF NOT SINGLE RESIDENCE DESCRIBE _____

THE SYSTEM INSTALLED UNDER THIS APPLICATION IS ACCEPTABLE ONLY UNTIL PUBLIC FACILITIES BECOME AVAILABLE.

SIGNATURE OF APPLICANT /s/ Robert Johnson

APPROVED BY _____ FOR _____ DATE _____

(KIND OF SYSTEM)


REJECTED BY _____ FOR _____ DATE _____

(KIND OF SYSTEM)

HOLD PENDING FURTHER TESTS _____ DATE _____

REASONS FOR REJECTION OR HOLDING _____

THIS IS NOT A PERMIT

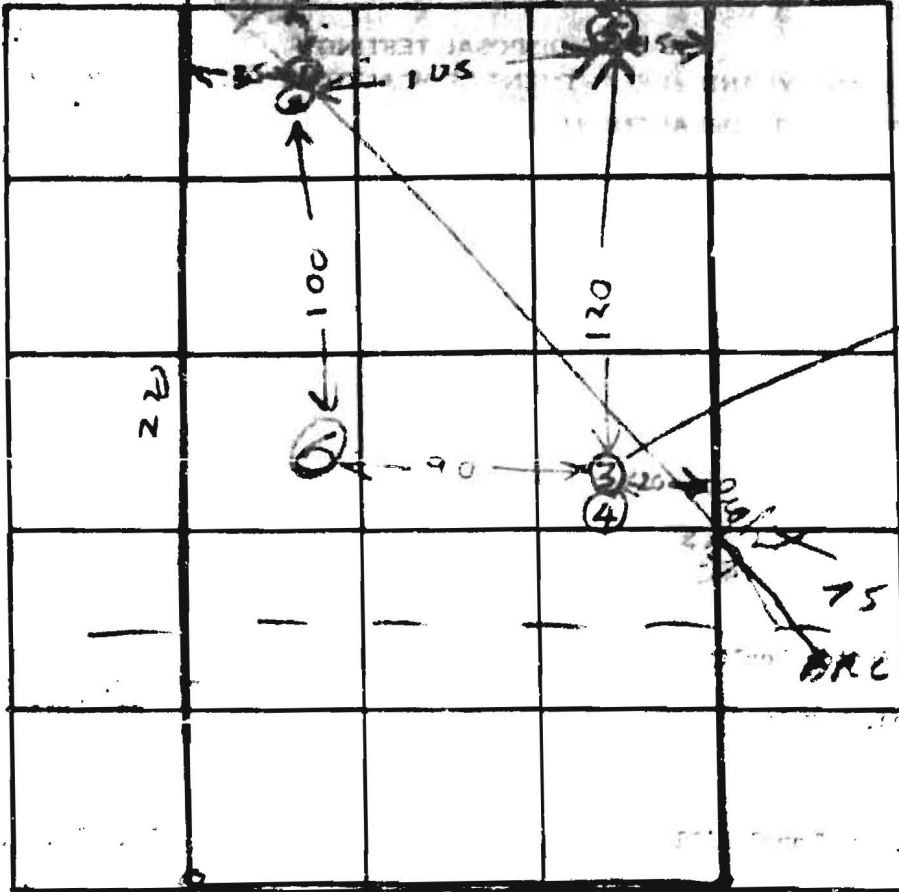

INDICATE NORTH - NAME ADJOINING ROADWAY AS BASE LINE

TO THE CENTER

MORNING STAR DR

| DATE | TEST NO. | DEPTH | MOISTURE | | TEST - 1" DROP | | TIME |
|--------|----------|--------|---------------|---------------|----------------|------|------|
| | | | START | STOP | START | STOP | |
| 5/2/75 | 1 | 6 | 226 | 227 | 227 | 230 | 3 |
| | 2 | 1 1/2 | 226 | 229 | 230 | 232 | 4 |
| | 3 | 10 1/2 | 241 | 245 | 245 | 249 | 4 |
| | 4 | 4 | 242 | 245 | 245 | 249 | 4 |
| | 5 | 1.0 | TOP 5 FT CLAY | BUT 5 FT SAND | | | Dry |
| | 6 | 10 1/2 | TOP 4 FT CLAY | BUT 5 FT SAND | | | 12:4 |
| | | | | | | | |
| | | | | | | | |
| | | | | | | | |
| | | | | | | | |

Arden
4 m
Max
depth
4 ft

REMARKS

TYPE OF SOIL

