

TENNESSEE OFFICE OF REVENUE
WELL COMPLETION REPORT

FILL IN THIS FORM COMPLETELY
COUNTY NUMBER **H 18009**

DATE RECEIVED (ISSA USE ONLY) **10/26/76**
DATE WELL COMPLETED **10/26/76**
DEPTH OF WELL **150**
PERMIT NO. FROM "PERMIT FOR ALL WELLS" **47-70-V-195**
DRILLERS IDENTIFICATION NO. **217**

OWNER **ZIMMERMAN**
STREET OR RFD **MORNING STAR DR** POST OFFICE **CARL DAYTON MD**

WELL LOG

STATE THE KIND OF FORMATIONS PENETRATED, THEIR COLOR, DEPTH, THICKNESS AND IF WATER BEARING

DESCRIPTION (USE APPROPRIATE CODES)	FEET		WATER BEARING
	FROM	TO	
BROWN SANDSTONE	4	150	<input checked="" type="checkbox"/>

GRouting RECORD

WELL HAS BEEN GROUTED (CHECK APPROPRIATE BOX) Y N

TYPE OF GROUTING MATERIAL (CHECK ONE)

CEMENT DECATONITE CLAY OTHER

NO. OF BAGS **5** NO. OF POUNDS **410**

GALLONS OF WATER **30**

DEPTH OF GROUT SEAL (TO NEAREST FOOT)

FROM **0** FT. TO **25** FT.

CASING RECORD

CASING TYPE (CHECK APPROPRIATE CODE)

STEEL CONCRETE PLASTIC OTHER

MAIN CASING TYPE **ST** NOMINAL DIAMETER TOP OF MAIN CASING (NEAREST INCH) **6** TOTAL DEPTH OF MAIN CASING (NEAREST FOOT) **26**

OTHER CASING (IF ANY)

DIAMETER (INCH) _____ DEPTH (FEET) _____

SCREEN RECORD

SCREEN TYPE (CHECK APPROPRIATE CODE)

STEEL BRASS OR COPPER OPEN HOLE PLASTIC OTHER

SCREEN DEPTH (NEAREST WHOLE FOOT)

FROM **0** TO **150**

PUMPING TEST

HOURS PUMPED (TO NEAREST HOUR) **2**

PUMPING RATE (GALLONS PER MINUTE TO NEAREST GALLON) **6**

METHOD USED TO MEASURE PUMPING RATE **ROTAR**

WATER LEVEL (DISTANCE FROM LAND SURFACE)

DEPTH PUMPING **35** (NEAREST FOOT)

WELL PUMPING **145** (NEAREST FOOT)

TYPE OF PUMP USED (CHECK APPROPRIATE BOX)

AIR PISTON TURBINE CENTRIFUGAL ROTARY OTHER (DESCRIBE BELOW) JET SUBMERSIBLE

PUMP INSTALLER

TYPE OF PUMP WRITE APPROPRIATE LETTER (SEE ABOVE) **A, C, J, P, R, S, T, O**

DRILLER WILL INSTALL PUMP (CHECK APPROPRIATE BOX) YES NO

CAPACITY: _____

GALLONS PER MINUTE (TO NEAREST GALLON) _____

PUMP HORSE POWER _____

PUMP COLUMN LENGTH (NEAREST FOOT) **43** **47**

CASING HEIGHT

CHECK APPROPRIATE BOX AND COVER CASING HEIGHT

ABOVE BELOW

LAND SURFACE _____ NEAREST FOOT _____

LOCATION OF WELL ON LOT

SHOW PERMANENT STRUCTURE SUCH AS BUILDING, SEPTIC TANKS, AND/OR OTHER LAND MARKS AND INDICATE, NOT LESS THAN TWO DISTANCED MEASUREMENTS TO WELL.

Handwritten notes and diagrams on lot location.

CIRCLE APPROPRIATE BOXES

A WELL WAS ABANDONED AND SEALED WHEN THIS WELL WAS COMPLETED

B ELECTRIC LOG OBTAINED

C VERY WELL CONVERTED TO PRODUCTION WELL

I HEREBY CERTIFY THAT I HAVE COMPLIED WITH ALL CONDITIONS STATED ON THE ABOVE-CAPTIONED "PERMIT TO DRILL WELL", AND THAT INFORMATION CONTAINED IN THIS REPORT IS TRUE, ACCURATE, AND COMPLETE TO THE BEST OF MY KNOWLEDGE, INFORMATION AND BELIEF.

DRILLERS NAME _____

PLEASE PRINT: _____

SIGNATURE _____

DIAMETER OF SCREEN _____ (NEAREST INCH)

GRAV. PACK _____

IF WELL DRILLER WAS A FLOWING WELL CHECK BOX YES NO

ISSA USE ONLY (NOT TO BE FILLED IN BY DRILLER)

TELECOPY CASING TELEPHONE OTHER DATA AVAILABLE

Scale 1" = 30'

No City Water or Sewer

A18009

152'

N →

Lot 11 Block D
Linden Chapel Hills
Section 3.

135'

270'

270'

alt. Plan




20'

30'

15' septic

*Site is internet
plan for
house.*

Vacant lot.

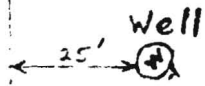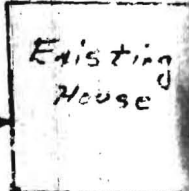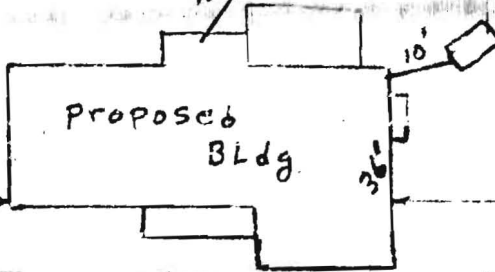

Proposed
driveways

40'

36'

50'

48'

50'

75'

152'

