

PUB. SEWER STATUS VERIFIED BY _____

ISSUE DATE: _____

APPROVAL DATE: _____

PERMIT INDEXED

P 518621-H

A re-index

ON-SITE SEWAGE DISPOSAL SYSTEM HOWARD COUNTY HEALTH DEPARTMENT BUREAU OF ENVIRONMENTAL HEALTH

03-279634

IS PERMITTED TO INSTALL ALTER

ADDRESS: _____ PHONE NUMBER: _____

SUBDIVISION: Green Henge III LOT NUMBER: 5B, Block B

ADDRESS: 2901 Evergreen Way PROPERTY OWNER: Carl Auld

SEPTIC TANK CAPACITY (GALLONS): _____

PUMP CHAMBER CAPACITY (GALLONS): _____

NUMBER OF BEDROOMS: _____

SQUARE FEET PER BEDROOM: _____

LINEAR FEET OF TRENCH REQUIRED: _____

TRENCHES:	Trench to be _____ feet wide. Inlet _____ feet below original grade. Bottom maximum depth _____ feet below original grade. Effective area begins at _____ feet below original grade. _____ feet of stone below distribution pipe.
LOCATION:	_____
PURPOSE:	_____

PLANS APPROVED: _____ DATE: _____

- NOTE: PERMIT VOID AFTER 2 YEARS
- NOTE: CONTRACTOR RESPONSIBLE FOR SCHEDULING A PRE-CONSTRUCTION INSPECTION FOR ALL INSTALLATIONS
- NOTE: WATERTIGHT SEPTIC TANKS REQUIRED
- NOTE: ALL PARTS OF SEPTIC SYSTEM SHALL BE 100 FEET FROM ANY WATER WELL
- NOTE: MANHOLE RISERS REQUIRED ON ALL SEPTIC TANKS AND PUMP CHAMBERS

**NEITHER THE HOWARD COUNTY COUNCIL NOR THE HEALTH DEPARTMENT IS
RESPONSIBLE FOR THE SUCCESSFUL OPERATION OF ANY SYSTEM
PERMITTEE RESPONSIBLE FOR OBTAINING FINAL APPROVAL ON THIS PERMIT
CALL 410-313-2640 FOR INSPECTION OF SEPTIC SYSTEM**

P518621-H

Approved 5/11/70 yllc

PERMIT

P. 19119

A. 11446

SEWAGE DISPOSAL SYSTEM

MARYLAND STATE DEPARTMENT OF HEALTH

HOWARD COUNTY

ELLICOTT CITY

INDEXED

DISTRICT 3

DATE 3/3/70

Superintendent & Bell IS PERMITTED TO INSTALL X ALTER

ADDRESS South Dalfield Md., Orange Mills, Md. PHONE 363-0880

A SEWAGE DISPOSAL SYSTEM LOCATED AT _____

SUBDIVISION Green Hedge ROAD Evergreen Way & Ordway Dr. LOT 5 B. 228

PROPERTY OWNER Garrett, Inc. - New Owners - Mr. & Mrs. Carl Auld

ADDRESS _____

SPECIFICATION. 4 bedrooms

DRAIN FIELD _____ DEPTH _____ FEET. BOTTOM AREA _____ SQ. FT.

SEWAGE PITS _____ ABSORBENT SIDE-WALL AREA _____ SQ. FT.

SEPTIC TANK CAPACITY 1,200 GALLONS

FOR GARBAGE GRINDER, INCREASE DISPOSAL AREA 25% & TANK CAPACITY 50%.

OTHER Dry well - 400 sq. ft. sidewall area below inlet with max. depth of

10 ft. below grade at time of pour test.

Place the dry well between 50 ft. and 70 ft. from the stream in the middle of the

lot measuring from the stream toward Evergreen Way and between 65 ft. and 85 ft.

from the sideline which is nearest to Ordway Drive.

NOTE: ALL PIPES FROM HOUSE TO SEPTIC TANK MUST BE CAST IRON.

PLANS APPROVED BY J. H. Kilmer DATE 3/28/70


PERMIT VOID AFTER THREE YEARS.

FILL SEPTIC TANK AND DISTRIBUTION BOX WITH WATER BEFORE CALLING FOR AN INSPECTION. COVER NO WORK UNTIL INSPECTED AND APPROVED.

NEITHER THE HOWARD COUNTY COMMISSIONERS NOR THE HEALTH DEPARTMENT IS RESPONSIBLE FOR THE SUCCESSFUL OPERATION OF ANY SYSTEM.

BUDG. PERMIT SIGNED
AND RETURNED 3/29/70
Serial #51069 - Submitted

NOTIFY THE HEALTH DEPARTMENT 48 HOURS BEFORE EXCAVATIONS ARE TO BE BACK FILLED.

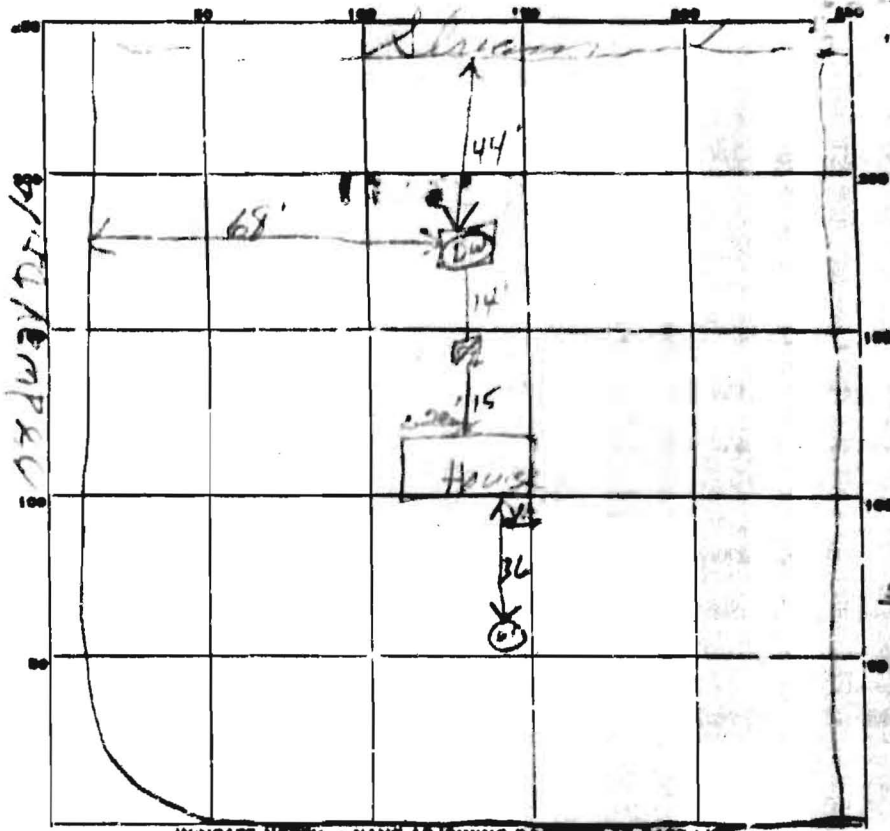

INDICATE NORTH - NAME ADJOINING ROADWAY AS BASE LINE

PERMIT CARD OK EVERGREEN WAY

SEPTIC TANK, LEVEL OK 12.50 cement CLEANOUTS _____

DISTRIBUTION BOX, LEVEL _____

TILE FIELD, DEPTH _____ FT. TRENCH WIDTH _____ FT.

GRAVEL DEPTH _____ IN. TOTAL LENGTH _____ FT.

NUMBER OF TRENCHES _____ TOTAL BOTTOM AREA _____

SEEPAGE FITS 11 x 14 x 14 INSIDE DIAMETER 10 cement FT. DEPTH BELOW INLET 8 FT.

ABSORBENT AREA 400 SQ. FT.

REMARKS _____

DATE SYSTEM APPROVED 5/11/70 INSPECTOR JH