

APPLICATION

A 11414

P _____

SEWAGE DISPOSAL TESTING

MARYLAND STATE DEPARTMENT OF HEALTH

HOWARD COUNTY

absorbent sidewall area below 1/2 in. inlet pipe
ELLICOTT CITY

3 bedroom Septic Tank 750 gallons

DISTRICT 3

2 dry wells - 150 sq. ft. each, at least 40 ft apart measured edge to edge. First dry well to be located 70 ft from rear lot line and 45 ft from left side lot line as seen when facing lot from Evergreen Way. Depth of dry wells to be no greater than 8 ft below original grade.

DATE 1/20/66

4 bedroom Septic Tank 1800 gallons

2 dry wells 200 sq ft each at least 40 ft apart measured edge to edge and no deeper than 9 ft below original grade located same as above.

TO THE COUNTY HEALTH OFFICER
ELLICOTT CITY, MARYLAND

I, HEREBY, APPLY FOR THE NECESSARY TESTS IN ORDER TO CONSTRUCT OR RECONSTRUCT A SEWAGE DISPOSAL SYSTEM. *see other sheet for new specs*

PROPERTY OWNER C. Curwell, Inc.

ADDRESS Chatham Rd., Ellicott City, Md.

PHONE HO 5-2677

PROPERTY LOCATION:

SUBDIVISION Green Heart

LOT NO. 5B
2, Sec. 3

ROAD AND DESCRIPTION Corner of Evergreen Way & Unnamed Road

OCCUPANT _____

PHONE _____

PERSON TO CONSTRUCT SYSTEM _____

ADDRESS _____

PHONE _____

SIZE OF LOT 215' x 162' x 265' x 82' x 90'

TYPE BLDG 3 or 4

NUMBER OF DWELLINGS

IF NOT SINGLE RESIDENCE DESCRIBE _____

SIGNATURE OF APPLICANT /s/ Carl C. Hall, President

APPROVED BY J. H. Kalmus

FOR a dry well

DATE 1/21/67

REJECTED BY _____

FOR _____


DATE _____

HOLD PENDING FURTHER TESTS _____

DATE _____

REASONS FOR REJECTION OR HOLDING _____

THIS IS NOT A PERMIT

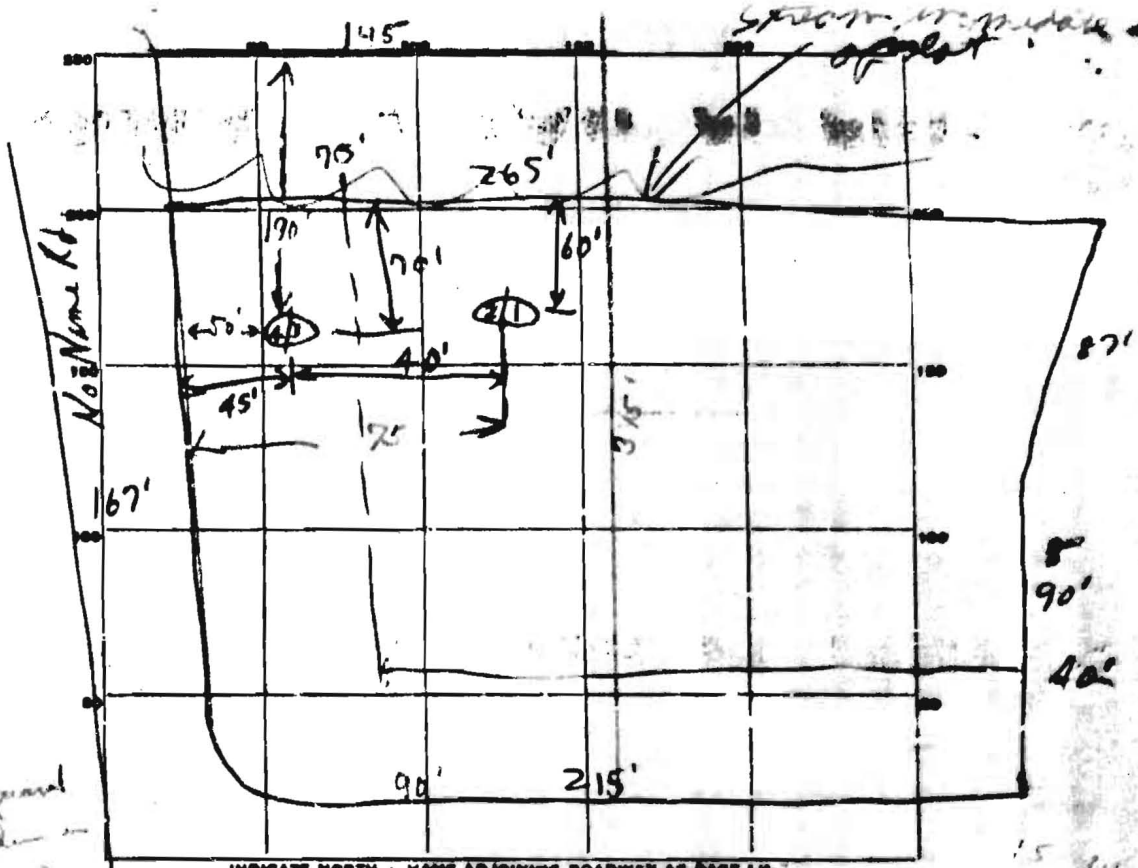

Change and
list of
values

Evergreen Way

DATE	TEST NO.	DEPTH	PRE-WET		TEST - 1" DROP		TIME
			START	STOP	START	STOP	
11/21/66	1	3 1/2 ft.	2:04	2:06	2:06	2:10	4 min.
	2	4 1/2 ft.	2:05	2:08	2:08	2:18	10 min.
	3	4 1/2 ft.	2:10	2:13	2:13	2:20	7 min.
	4	9 ft.	2:10	2:13	2:13	2:18	5 min.

60 ft. station
4/26
7

SOIL AUGER FINDING M. 1127 deep hole to 13 ft.

TESTED BY RPF 1/24/66 2 shallow dry wells

REMARKS _____

#5