

LAYOUT _____ INSP 4 _____
INSP 2 _____ INSP 5 _____
INSP 3 _____ INSP 6 _____

ISSUE DATE: _____
APPROVAL DATE: _____

**PERMIT
INDEXED**

P _____
A 518624 - A

**ON-SITE SEWAGE DISPOSAL SYSTEM
HOWARD COUNTY HEALTH DEPARTMENT
BUREAU OF ENVIRONMENTAL HEALTH**

06 405894

_____ IS PERMITTED TO INSTALL ALTER

ADDRESS: _____ PHONE NUMBER: _____

SUBDIVISION: _____ LOT NUMBER: _____

ADDRESS: 10711 Harding Road PROPERTY OWNER: R Jacob Hikmat

SEPTIC TANK CAPACITY (GALLONS): _____ OUTLET BAFFLE FILTER REQUIRED

PUMP CHAMBER CAPACITY (GALLONS): _____ COMPARTMENTED TANK REQUIRED

NUMBER OF BEDROOMS: _____

SQUARE FEET PER BEDROOM: _____

LINEAR FEET OF TRENCH REQUIRED: _____

TRENCHES:	Trench to be _____ feet wide. Inlet _____ feet below original grade. Bottom maximum depth _____ feet below original grade. Effective area begins at _____ feet below original grade. _____ feet of stone below distribution pipe.
LOCATION:	
NOTES:	

PLANS APPROVED: _____ DATE: _____

- NOTE: PERMIT VOID AFTER 2 YEARS
- NOTE: CONTRACTOR RESPONSIBLE FOR SCHEDULING A PRE-CONSTRUCTION INSPECTION FOR ALL INSTALLATIONS
- NOTE: WATERTIGHT SEPTIC TANKS REQUIRED
- NOTE: ALL PARTS OF SEPTIC SYSTEM SHALL BE 100 FEET FROM ANY WATER WELL
- NOTE: MANHOLE RISERS REQUIRED ON ALL SEPTIC TANKS AND PUMP CHAMBERS UNLESS SPECIFICALLY AUTHORIZED

**NEITHER THE HOWARD COUNTY COUNCIL NOR THE HEALTH DEPARTMENT IS
RESPONSIBLE FOR THE SUCCESSFUL OPERATION OF ANY SYSTEM
PERMITTEE RESPONSIBLE FOR OBTAINING FINAL APPROVAL ON THIS PERMIT**

BUILDING PERMIT SIGNED AND RETURNED
CALL 410-313-2640 FOR INSPECTION OF SEPTIC SYSTEM

*4/16/2009 B00141199 BREEZEWAY
3/31/04 BLD147120 - CONVERT GARAGE TO BEDROOM*

A 518624A

8/11/66
Approved

PERMIT

SEWAGE DISPOSAL SYSTEM

MARYLAND STATE DEPARTMENT OF HEALTH

HOWARD COUNTY

EL LICOTT CITY

DISTRICT 5

INDEXED

DATE 5/25/66

P 11843

A 11477

Walter J. Heath IS PERMITTED TO INSTALL I ALTER

ADDRESS Harding Rd., Laurel, Md. PHONE PA 5-6619

A SEWAGE DISPOSAL SYSTEM LOCATED AT

SUBDIVISION 10711 ROAD Harding Rd. LOT

PROPERTY OWNER same as above

ADDRESS

SPECIFICATIONS - 3 bedrooms

DRAIN FIELD _____ DEPTH _____ FEET, BOTTOM AREA _____ SQ. FT.

SEEPAGE PITS _____ ABSORBENT SIDE-WALL AREA _____ SQ. FT.

SEPTIC TANK CAPACITY 750 GALLONS

FOR GARBAGE GRINDER, INCREASE DISPOSAL AREA 25% & TANK CAPACITY 50%.

OTHER Dry well 14 ft. in dia. by 12 ft. deep below the inlet located 131 ft. from the front property line and 76 ft. off the right side property line as seen when facing the lot from Harding Road. Locate inlet pipe 3 ft. below original grade.

PLANS APPROVED BY J. Hennigan DATE 3/1/66

FILL SEPTIC TANK AND DISTRIBUTION BOX WITH WATER BEFORE CALLING FOR AN INSPECTION. COVER NO WORK UNTIL INSPECTED AND APPROVED.


NEITHER THE HOWARD COUNTY COMMISSIONERS NOR THE HEALTH DEPARTMENT IS RESPONSIBLE FOR THE SUCCESSFUL OPERATION OF ANY SYSTEM.

BLOG. PERMIT SIGNED
AND RETURNED 11/23/66
Ann M 48992
Storage Shed.

11477

12
12
12

10
12
14
43

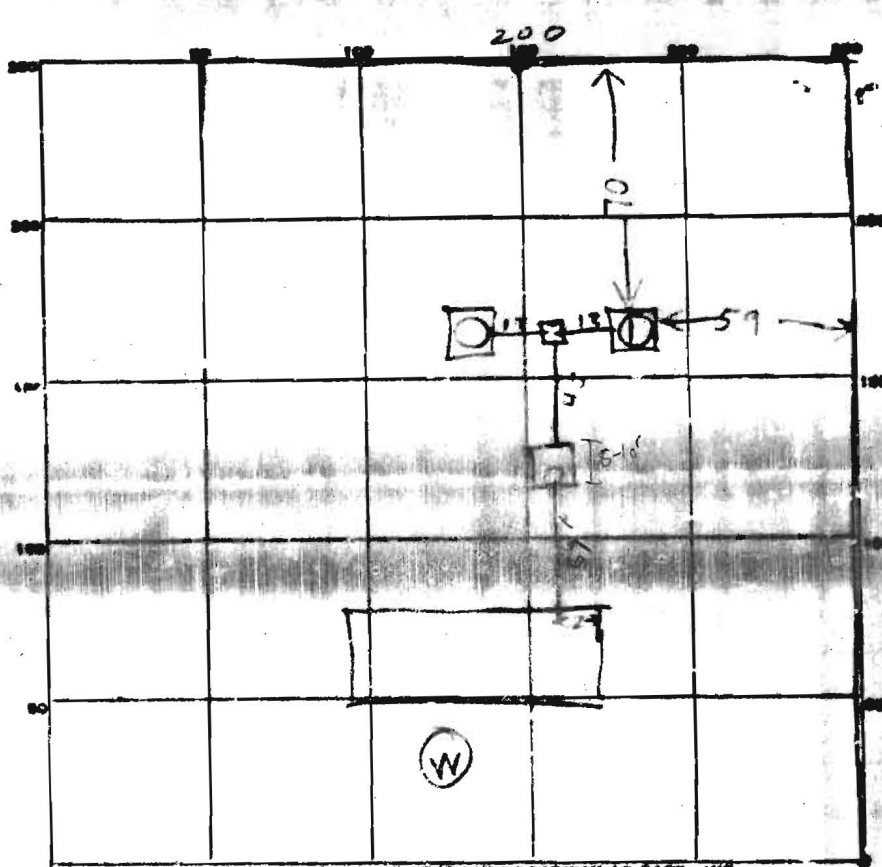

INDICATE NORTH. - NAME ADJOINING ROADWAY AS BASE LINE.

PERMIT CARD _____

SEPTIC TANK, LEVEL Concrete
Top is 3' 6" below grade 10' 0"

CLEANOUTS OK

DISTRIBUTION BOX, LEVEL _____

TILE FIELD, DEPTH _____ FT. TRENCH WIDTH _____ FT.

GRAVEL DEPTH _____ IN. TOTAL LENGTH _____ FT.

NUMBER OF TRENCHES _____ TOTAL BOTTOM AREA _____

SEEPAGE PITS, INSIDE DIAMETER _____ FT. DEPTH BELOW INLET _____ FT.

ABSORBENT AREA 6 sq ft existing stone
936 sq ft Country Stone

REMARKS 6/12/65 Dry Well #1 Inlet is 2' below grade

Dry Well #2 Inlet 11ft Top is 2ft below sidewalk area existing
stone 341 Perimeter dry well 40ft soft sidewalk area existing stone 508
Dry Well #3 Dry Well Inlet is 4' below grade Depth below
inlet is 10ft Top is 10ft below sidewalk area not existing
stone 310 Perimeter dry well 42ft soft sidewalk area existing stone 430

DATE SYSTEM APPROVED 8/12/65

INSPECTOR Raymond [Signature]

11
12
12
16
46
31
391