

APPLICATION

SEWAGE DISPOSAL TESTING

MARYLAND STATE DEPARTMENT OF HEALTH

HOWARD COUNTY

ELLICOTT CITY

A 11477

P _____

DISTRICT 5

DATE 2/16/66

*750 gal. septic Tank.
Dry well 14 ft. in dia. by 12 ft. deep
below the inlet located 131 ft. from the
front property line and 7 1/2 ft. off the right side
property line as seen when facing the lot from
Harding road. Inlet pipe 30 ft. below
original grade.*

TO: THE COUNTY HEALTH OFFICER
ELLICOTT CITY, MARYLAND

I, HEREBY, APPLY FOR THE NECESSARY TESTS IN ORDER TO CONSTRUCT OR RECONSTRUCT A SEWAGE DISPOSAL SYSTEM.

PROPERTY OWNER Walter J. Heath

ADDRESS Harding Road - Laurel, Md. PHONE 215-6619

PROPERTY LOCATION:

SUBDIVISION _____ LOT NO. _____

ROAD AND DESCRIPTION Harding Road
Rt. 29 to Rt. 216 - turn left on 216 - go to Pine Valley Rd.
make right turn - go to Harding Rd. - make left -
first lot past the first butcher house on right

OCCUPANT _____ PHONE _____

PERSON TO CONSTRUCT SYSTEM _____

ADDRESS _____ PHONE _____

SIZE OF LOT 1.477 acres TYPE BLDG. 3
NUMBER OF BEDROOMS _____

IF NOT SINGLE RESIDENCE DESCRIBE _____

SIGNATURE OF APPLICANT Walter J. Heath


APPROVED BY J. H. ... FOR Dry Well DATE 3-1-66

REJECTED BY _____ FOR _____ DATE _____

HOLD PENDING FURTHER TESTS _____ DATE _____

REASONS FOR REJECTION OR HOLDING 2-23-66 Approval but final offer must be signed
by Mr. Shroyer, Jr.

THIS IS NOT A PERMIT

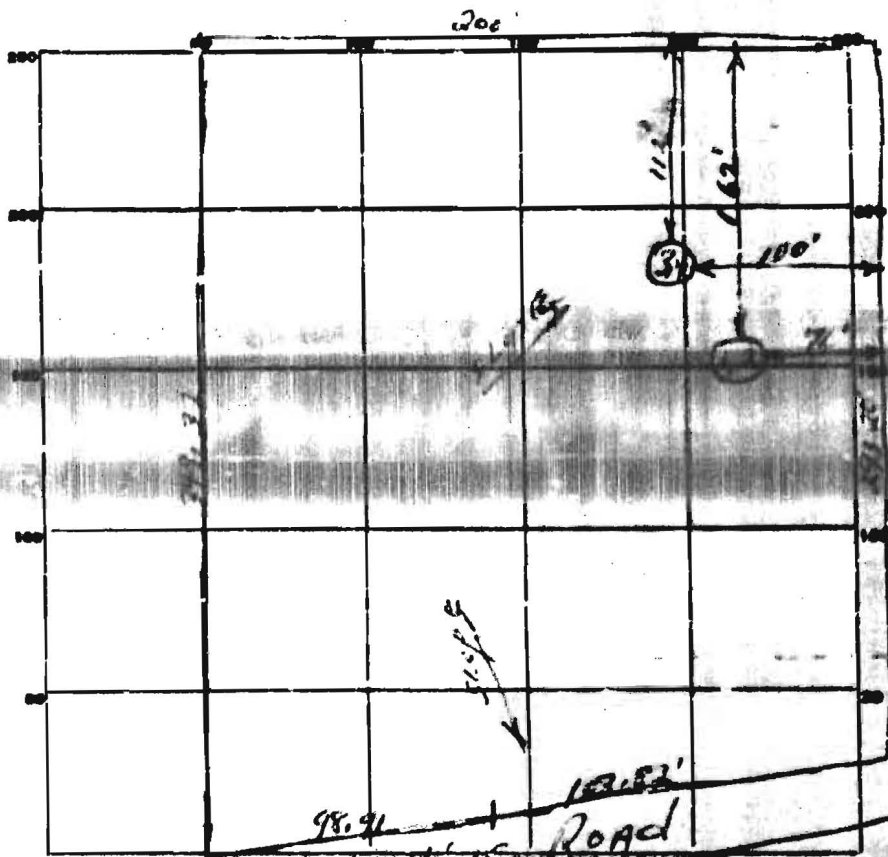


DATE	TEST NO.	DEPTH	PRE-WET		TEST - 1" DROP		TIME
			START	STOP	START	STOP	
2-23-66	1, Sand	9'	9:44	9:45	9:45	9:48	3 min
	2, Pit	5'	9:45	9:53	9:58	10:25	27 min
	3, Sand	9 1/2'	9:52	9:54	9:54	9:58	4 min
	4, Pit	5'	9:55	10:09	10:09	10:34	25 min

as per
Time
15 min

SOIL AUGER FINDING 1ST 5FT. not very good.

TESTED BY *[Signature]*

REMARKS 2-23-66

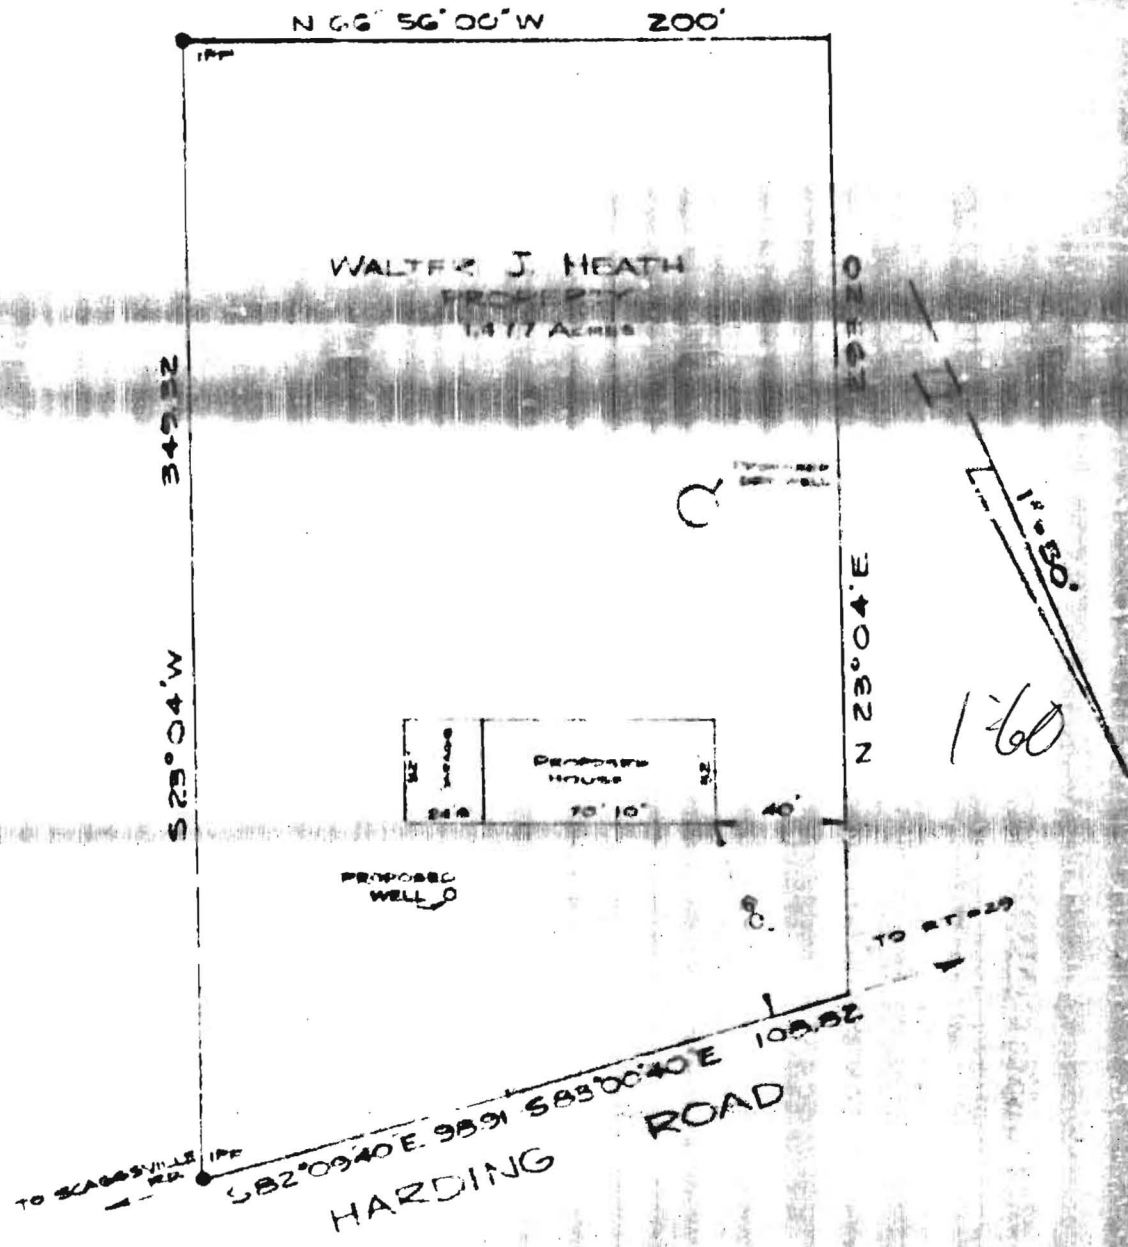


FACILITIES
PRIVATE WATER AND SEWERAGE

APPROVED:
Theodore R. Snodgrass
DR. THEODORE R. SNODGRASS DATE 2-28-66
HOWARD COUNTY HEALTH OFFICER



PREPARED BY:
CARL W. GOHR
8800 - 58th Avenue
Bowie, Md. 20741
2-15-66

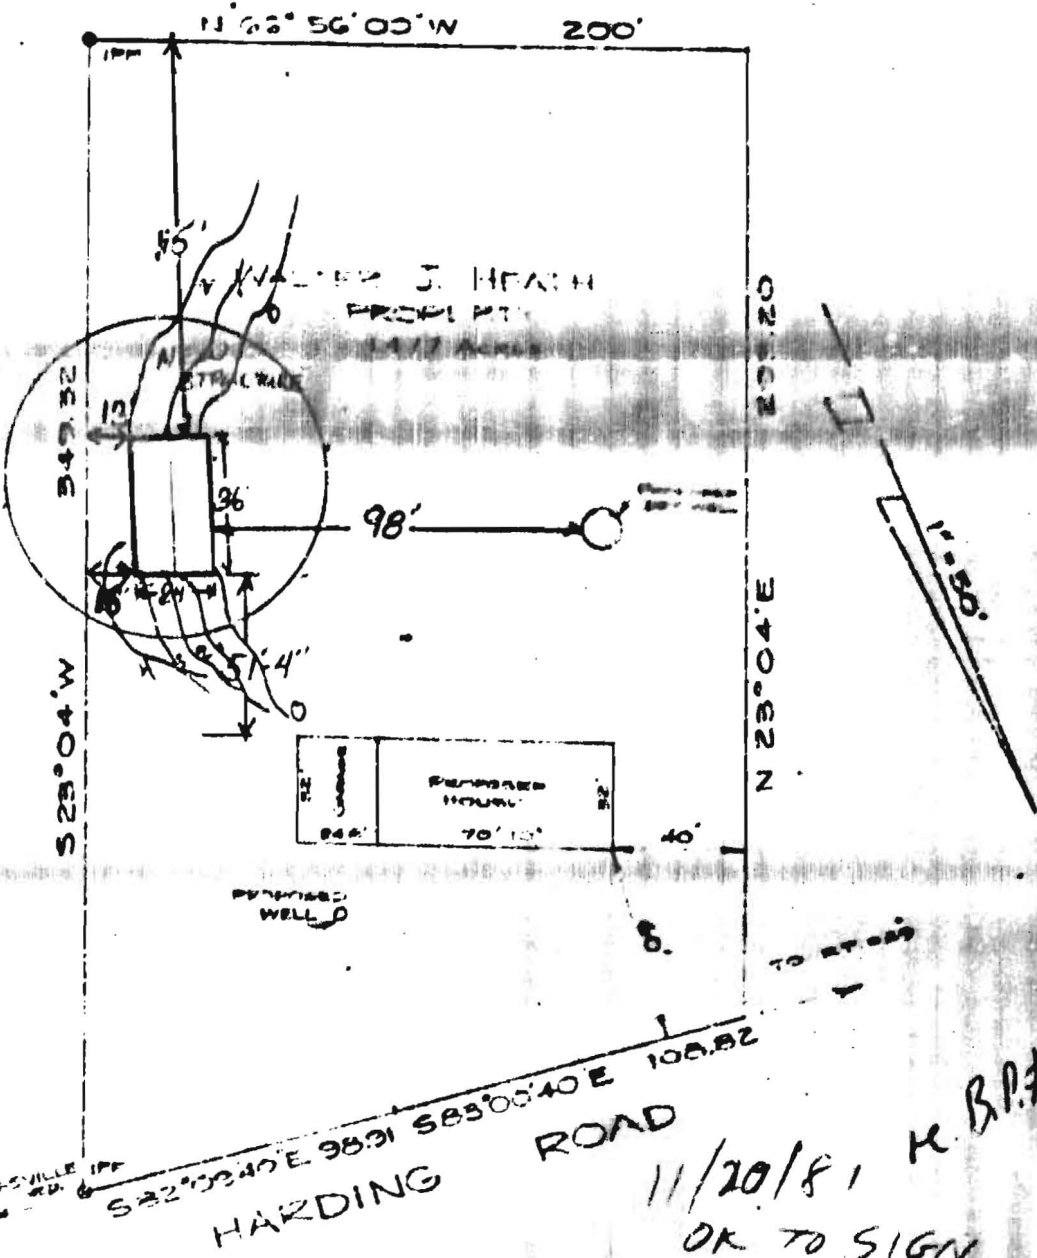

FACILITIES
 PRIVATE WATER AND SEWERAGE
 APPROVED:

BY: HOWARD CARL J. HEATH, CLERK



11/20/81
 OK TO SIGN
 PERMIT
 NO PROBLEMS
 PREPARED BY: K.B.P.#48292

CARL W. GOHR
 8800 - 58th Avenue
 Berwyn Hgts. Md. 20741

2-15-66