

# PERMIT

SEWAGE DISPOSAL SYSTEM

MARYLAND STATE DEPARTMENT OF HEALTH

HOWARD COUNTY

ELLICOTT CITY

DISTRICT 5

DATE 10/28/69

**INDEXED**

SEWER MAIN IS PERMITTED TO INSTALL 3 ALTER

ADDRESS Amegalia Park Road, Woodbine, Md. PHONE MI 9-4726

A SEWAGE DISPOSAL SYSTEM LOCATED AT \_\_\_\_\_

SUBDIVISION Hill Green ROAD Highway 211 LOT 2a 000 2

PROPERTY OWNER George V. Chandler

ADDRESS \_\_\_\_\_

SPECIFICATIONS - 3 bedrooms

DRAIN FIELD \_\_\_\_\_ DEPTH \_\_\_\_\_ FEET, BOTTOM AREA \_\_\_\_\_ SQ. FT.

SEEPAGE PITS \_\_\_\_\_ ABSORBENT SIDE-WALL AREA \_\_\_\_\_ SQ. FT.

SEPTIC TANK CAPACITY 750 GALLONS

FOR GARBAGE GRINDER, INCREASE DISPOSAL AREA 225 & TANK CAPACITY 500.

OTHER dry well - 300 sq. ft. absorbent sidewall area to begin below inlet pipe. Inlet pipe to be 4 ft. below original grade. Max. depth permitted for dry well below original grade is 15 ft. Place dry well 100 ft. from front lot line and 50 ft. from left side line as shown when facing lot from Highway Hill Road.

NOTE: ALL PIPE FROM HOUSE TO SEPTIC TANK MUST BE CAST IRON.

PERMIT VOID AFTER THREE YEARS.


PLANS APPROVED BY D. V. Manahan DATE 1/28/69

FILL SEPTIC TANK AND DISTRIBUTION BOX WITH WATER BEFORE CALLING FOR AN INSPECTION. COVER NO WORK UNTIL INSPECTED AND APPROVED.

NEITHER THE HOWARD COUNTY COMMISSIONERS NOR THE HEALTH DEPARTMENT IS RESPONSIBLE FOR THE SUCCESSFUL OPERATION OF ANY SYSTEM.

**NOTIFY THE HEALTH DEPARTMENT 48 HOURS BEFORE EXCAVATIONS ARE TO BE BACK FILLED.**

*214231*

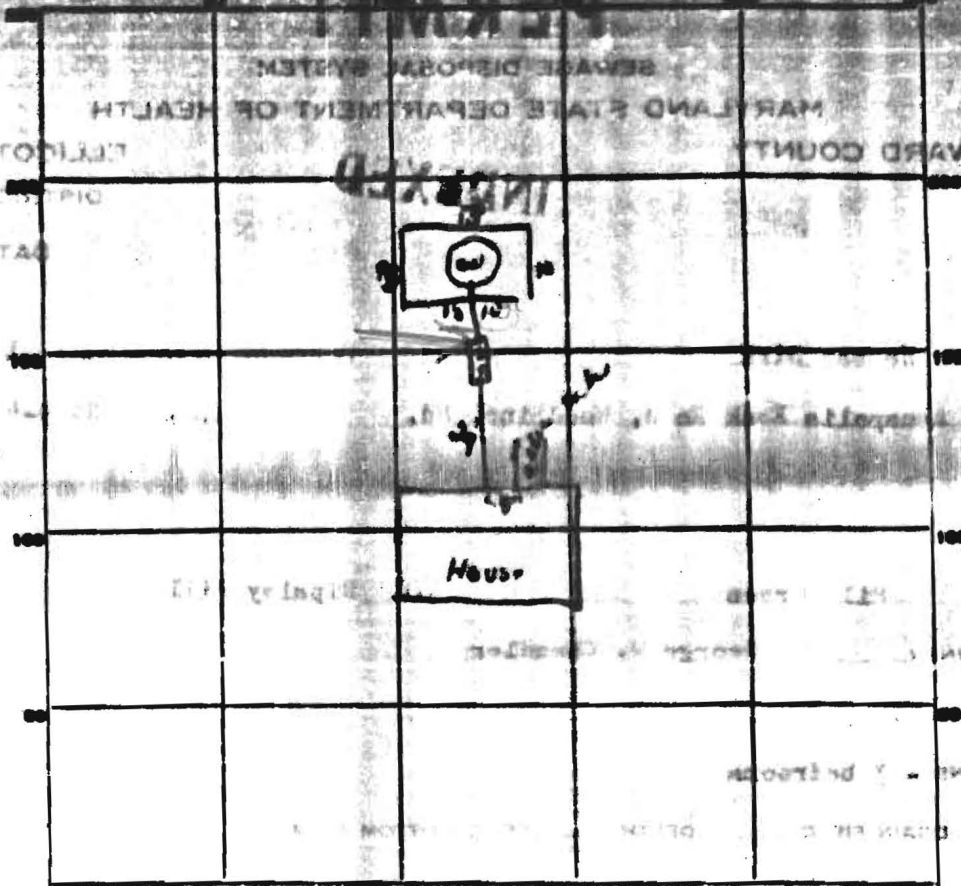

INDICATE NORTH - NAME ADJOINING ROADWAY AS BASE LINE.

PERMIT CARD CK

SEPTIC TANK, LEVEL OK CLEARNOUTS OK

DISTRIBUTION BOX, LEVEL \_\_\_\_\_

TILE FIELD, DEPTH \_\_\_\_\_ FT. TRENCH WIDTH \_\_\_\_\_ FT.

GRAVEL DEPTH \_\_\_\_\_ IN. TOTAL LENGTH \_\_\_\_\_ FT.

NUMBER OF TRENCHES \_\_\_\_\_ TOTAL BOTTOM AREA \_\_\_\_\_

SEEPAGE PITS, INSIDE DIAMETER Paints 5 ft FT. DEPTH BELOW INLET 6 FT.

ABSORBENT AREA 410 SQ. FT.

REMARKS \_\_\_\_\_

\_\_\_\_\_

\_\_\_\_\_

\_\_\_\_\_

\_\_\_\_\_

DATE SYSTEM APPROVED 10/30/69 INSPECTOR [Signature]

Handwritten notes on the left side of the page, including calculations and dates:   
 $3.75 \times 10 = 37.5$    
 $4.5 \times 10 = 45$    
 $1.25 \times 10 = 12.5$    
 $10/30/69$    
 $11/10/69$

NOTIFY THE HEALTH DEPARTMENT AS TO THE BACK BEFORE EXCAVATIONS ARE TO BE MADE