

# APPLICATION

SEWAGE DISPOSAL TESTING

MARYLAND STATE DEPARTMENT OF HEALTH

HOWARD COUNTY

ELLICOTT CITY

DISTRICT 4

DATE 1/23/69

*Septic Tank 75' dia*

*dry well - 310 yds. about residential area & began below street grade  
street grade to be 14 ft below road grade. May depth permitted  
for dry well below original grade is 13 ft.  
Below dry well 13 ft from front lot line - 50 ft from 1/2  
residential area near below facing lot from Ripley Mill Rd*

TO: THE COUNTY HEALTH OFFICER  
ELLICOTT CITY, MARYLAND

I, HEREBY, APPLY FOR THE NECESSARY TESTS IN ORDER TO CONSTRUCT (OR RECONSTRUCT) A SEWAGE DISPOSAL SYSTEM.

PROPERTY OWNER George W. Chandler

ADDRESS 12727 Gould Road, Wheaton, Md. PHONE RA 6-2800

PROPERTY LOCATION:

SUBDIVISION Hill Green LOT NO. 1, Sec. 2

ROAD AND DESCRIPTION Ripley Mill Road

OCCUPANT \_\_\_\_\_ PHONE \_\_\_\_\_

PERSON TO CONSTRUCT SYSTEM \_\_\_\_\_

ADDRESS \_\_\_\_\_ PHONE \_\_\_\_\_

SIZE OF LOT 2.86 acres TYPE BLDG. 3

IF NOT SINGLE RESIDENCE DESCRIBE \_\_\_\_\_ (Single Family Dwllg.)

SIGNATURE OF APPLICANT Marshall Peters Sec'y.

APPROVED BY Dennis W. Munnighan FOR Dry Well DATE 1/23/69


REJECTED BY \_\_\_\_\_ FOR \_\_\_\_\_ DATE \_\_\_\_\_

HOLD PENDING FURTHER TESTS \_\_\_\_\_ DATE \_\_\_\_\_

REASONS FOR REJECTION OR HOLDING \_\_\_\_\_

## THIS IS NOT A PERMIT

# APPLICATION

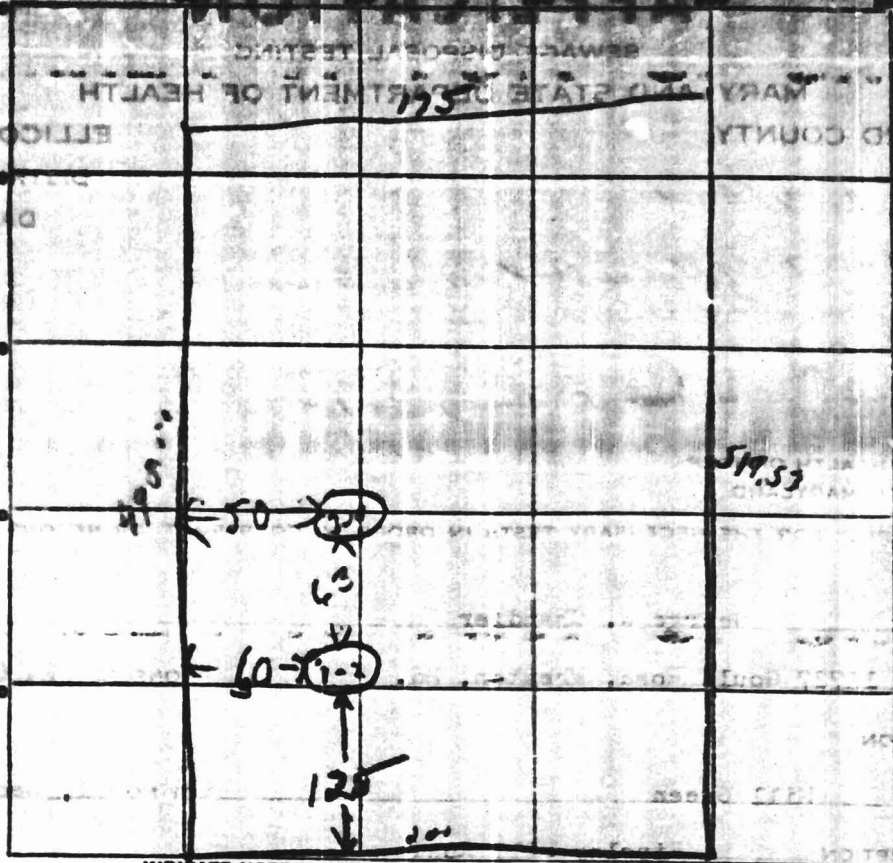

INDICATE NORTH. - NAME ADJOINING ROADWAY AS BASE LINE.

*Hepaly Mill Road*

| DATE           | TEST NO. | DEPTH            | PRE-WET      |               | TEST - 1" DROP |              | TIME          |
|----------------|----------|------------------|--------------|---------------|----------------|--------------|---------------|
|                |          |                  | START        | STOP          | START          | STOP         |               |
| <i>1/18/53</i> | <i>1</i> | <i>11 1/2 ft</i> | <i>9 36</i>  | <i>9 38</i>   | <i>9 38</i>    | <i>9 43</i>  | <i>5 min</i>  |
|                | <i>2</i> | <i>4 1/2 ft</i>  | <i>9 40</i>  | <i>no pen</i> |                |              |               |
|                | <i>3</i> | <i>13 ft</i>     | <i>10 00</i> | <i>10 04</i>  | <i>10 04</i>   | <i>10 10</i> | <i>6 min</i>  |
|                | <i>4</i> | <i>5 ft</i>      | <i>10 03</i> | <i>10 09</i>  | <i>10 09</i>   | <i>10 20</i> | <i>11 min</i> |
|                |          |                  |              |               |                |              |               |
|                |          |                  |              |               |                |              |               |
SOIL AUGER FINDING \_\_\_\_\_

TESTED BY \_\_\_\_\_

REMARKS \_\_\_\_\_