

# APPLICATION

SEWAGE DISPOSAL TESTING

A 30373

STATE OF MARYLAND - DEPARTMENT OF HEALTH AND MENTAL HYGIENE

P \_\_\_\_\_

HOWARD COUNTY HEALTH DEPARTMENT  
ENVIRONMENTAL HEALTH SERVICES

P.O. BOX 476 ELLICOTT, MARYLAND 21043  
TELEPHONE: 992-2330

DISTRICT 4th

DATE 11/20/79

TO: THE COUNTY HEALTH OFFICER  
ELLICOTT CITY, MARYLAND

I, HEREBY, APPLY FOR THE NECESSARY TEST IN ORDER TO CONSTRUCT (OR RECONSTRUCT) A SEWAGE DISPOSAL SYSTEM.

PROPERTY OWNER Henry & Charlotte Vana

ADDRESS 549 Forest View Road, Linthicum Heights PHONE 636-5768

PROPERTY LOCATION

SUBDIVISION \_\_\_\_\_ LOT NO. \_\_\_\_\_

ROAD AND DESCRIPTION Gaither Road - Rt. 32 to Forstythe Road, left on Forsythe, right on Gaither Road. Property is located approx. 1½ to 2 miles on left hand side of Gaither Road.

SIZE OF LOT 2/3 acres TYPE BLDG. 3 or 4 bedrooms

THE SYSTEM INSTALLED UNDER THIS APPLICATION IS ACCEPTABLE ONLY UNTIL PUBLIC FACILITIES BECOME AVAILABLE.

I FULLY UNDERSTAND THE FEE CONNECTED WITH THE FILING OF THIS PERC TEST APPLICATION IS NON-REFUNDABLE UNDER

ANY CIRCUMSTANCES.

SIGNATURE OF APPLICANT Charlotte A. Vana

APPROVED BY \_\_\_\_\_ FOR \_\_\_\_\_ DATE \_\_\_\_\_

REJECTED BY J. Stayer FOR \_\_\_\_\_ DATE 12/6/79


HOLD PENDING FURTHER TESTS \_\_\_\_\_ DATE \_\_\_\_\_

REASONS FOR REJECTION OR HOLDING \_\_\_\_\_

# THIS IS NOT A PERMIT

SOIL PROFILE

0

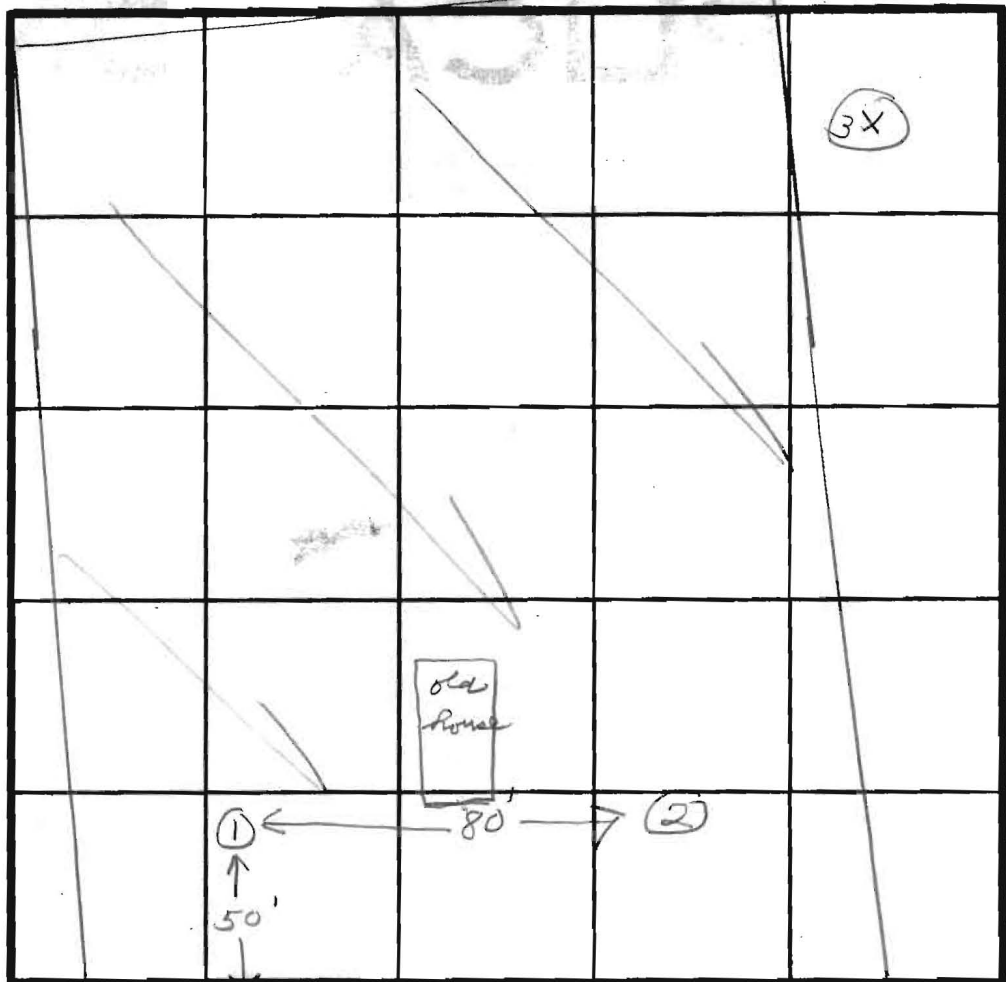

INDICATE NORTH - NAME ADJOINING ROADWAY AS BASE LINE.

*Gauthier Rd.*

DATE	TEST NO.	DEPTH	PRE-WET		TEST - 1" DROP		TIME
			START	STOP	START	STOP	
12/4/79	1	7	Water	at 5'			
	2	10	Water	at 8'			
	3X	12	Water	at 11' - hole dug			
			before my arrival - not on property.				

REMARKS *Small old house on property - vacant. No privy or well on lot.*

TYPE OF SOIL \_\_\_\_\_

TESTED BY *JB* ALSO PRESENT *Bud Arnold*