

3/25/96
10:00

APPLICATION

PERCOLATION TESTING

A 50977

P _____

HOWARD COUNTY HEALTH DEPARTMENT
BUREAU OF ENVIRONMENTAL HEALTH
3525-H ELLICOTT MILLS DRIVE/ELLICOTT CITY, MARYLAND 21043
TELEPHONE: 313-2640

perc by
South Carroll Bookhoe
875-4197
(Paul Schiarber)

DISTRICT _____

DATE 11/14/95

TO: THE COUNTY HEALTH OFFICER
ELLICOTT CITY, MARYLAND

I HEREBY APPLY FOR THE NECESSARY TEST PRIOR TO APPLICATION FOR PERMIT TO CONSTRUCT (OR RECONSTRUCT) A SEWAGE DISPOSAL SYSTEM.

PROPERTY OWNER Henry J. VANA + Charlotte A. VANA

ADDRESS 549 Forestview Rd Linthicum Md 21099 PHONE 859-5768

AGENT OR PROSPECTIVE BUYER _____

ADDRESS _____ PHONE _____

PROPERTY LOCATION:

SUBDIVISION (NA) Vana Property LOT NO. _____

ROAD AND DESCRIPTION W/S Gaither Rd - 3rd lot S/3 South Branch + Carroll Co
(Next to 500 Gaither Rd)

TAX MAP 4 Grid 13 PARCEL # 30

SIZE OF LOT 0.69 Acres TYPE BLDG. SFD
(SINGLE FAMILY DWELLING OR COMMERCIAL)

THE SYSTEM INSTALLED UNDER THIS APPLICATION IS ACCEPTABLE ONLY UNTIL PUBLIC FACILITIES BECOME AVAILABLE. I FULLY UNDERSTAND THE FEE CONNECTED WITH THE FILING OF THIS PERC TEST APPLICATION IS NON-REFUNDABLE UNDER ANY CIRCUMSTANCES. I ALSO AGREE TO COMPLY WITH ALL M.O.S.H.A. REQUIREMENTS IN TESTING THIS LOT.

(SIGNATURE OF APPLICANT)

APPROVED BY _____ FOR _____ DATE _____

DISAPPROVED BY _____ FOR _____ DATE _____

HOLD PENDING FURTHER TESTS _____

REASONS FOR REJECTION OR HOLDING _____

PERCOLATION TEST PLAT/PRELIMINARY PLAT - TITLE OR I.D. # _____ DATE _____

SITE DEVELOPMENT PLAN/FINAL PLAT - TITLE OR I.D. # _____ DATE _____

THIS IS NOT A PERMIT

50977


COUNTY #

SOIL PROFILE

0' ①
 1' topsoil
 or br cl lm
 w/few lg boulders
 3.5' 14 or br to 14 br sil m
 13' 10% rock frags

0' ②
 1' topsoil
 or red br cl lm
 4.5' seepage
 7.5-9' water

0' ③
 1' topsoil
 or red br cl lm
 14 or br sil m
 w/gneiss frags
 5' water seepage
 9' Refusal

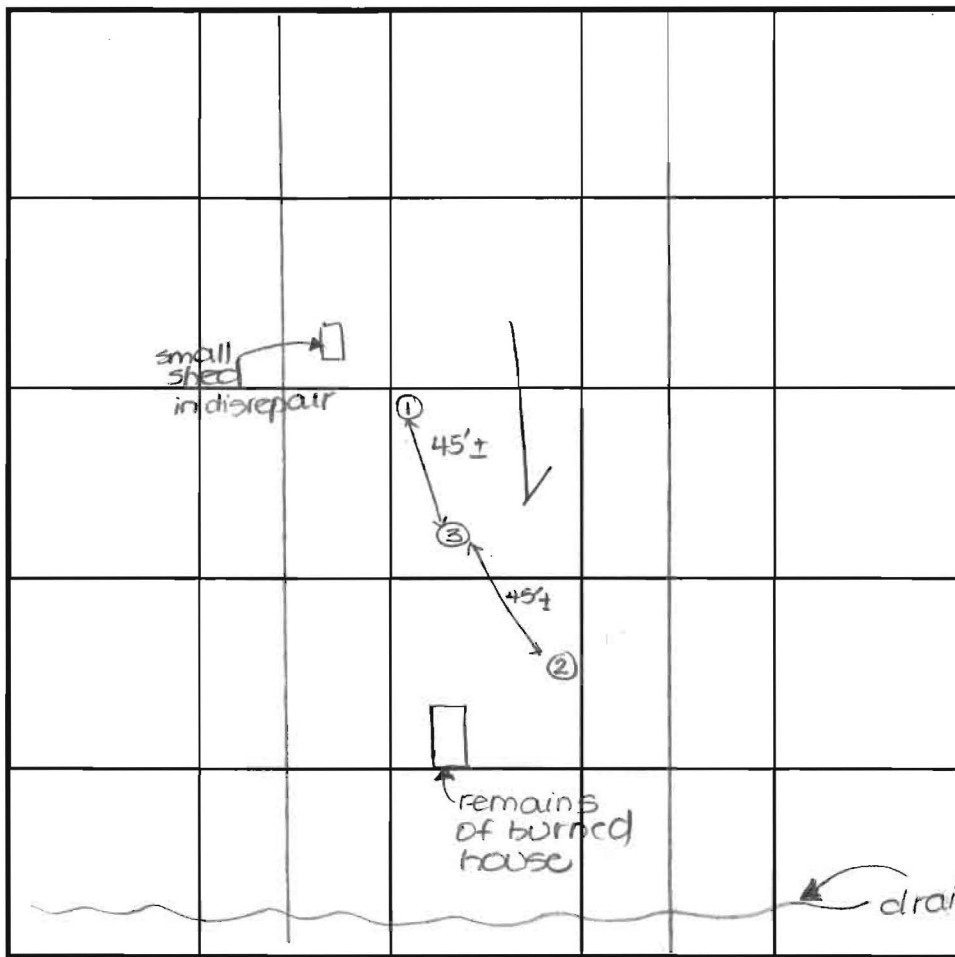

SOIL PROFILE

0'

INDICATE NORTH - NAME ADJOINING ROADWAY AS BASE LINE.

Gaither Road

| DATE | TEST NO. | DEPTH | PRE-WET | | TEST - 1" DROP | | TIME | |
|---------|----------|--------|----------------------|---------|----------------|-------|------|--|
| | | | START | STOP | START | STOP | | |
| 3-25-96 | 1 | 3.0'S | 10:35 ₃₀ | 10:46 | 10:46 | 11:00 | 14 | |
| | | 8.0'M | 10:38 | 10:45 | 10:45 | 10:55 | 10 | |
| | | 13.0'D | Visual - See profile | | | | | |
| | 2 | 4.5'S | Water | seepage | → | | FAIL | |
| | | 7.5'D | Water | | | | | |
| | 3 | 5.0'S | Water | seepage | → | | FAIL | |
| | | 9.0'D | Refusal | | | | | |
| | | | | | | | | |
| | | | | | | | | |
| | | | | | | | | |

REMARKS

TYPE OF SOIL blended Manor soils - previous December Test had water at 5, 8, 11' near front
 TESTED BY D. Soe ALSO PRESENT owner
 TRENCH DESIGN DATA: AVERAGE PERCOLATION TIME _____ TRENCH WIDTH _____
 INLET DEPTH _____ MAXIMUM BOTTOM DEPTH _____ SQ. FT./BEDROOM _____