

4/24/03 file 11am

PUB. SEWER STATUS VERIFIED BY SRK NA

ISSUE DATE: 4/23/2003

P 518632

APPROVAL DATE: 4/24/03

**PERMIT  
INDEXED**

A REPAIR

**ON-SITE SEWAGE DISPOSAL SYSTEM  
HOWARD COUNTY HEALTH DEPARTMENT  
BUREAU OF ENVIRONMENTAL HEALTH**

**03-289052**

Jack Fyock Septic Service IS PERMITTED TO INSTALL  ALTER

ADDRESS: PO Box 89, Glenelg, MD 21737 PHONE NUMBER: 410-988-9270

SUBDIVISION: \_\_\_\_\_ LOT NUMBER: 4

ADDRESS: 11362 Frederick Road PROPERTY OWNER: Catherine Klein

SEPTIC TANK CAPACITY (GALLONS): 1,000 Top Seam, New

PUMP CHAMBER CAPACITY (GALLONS): N/A

NUMBER OF BEDROOMS: 2

SQUARE FEET PER BEDROOM: N/A

LINEAR FEET OF TRENCH REQUIRED: N/A


TRENCHES: <u>Existing 70' trench</u>	Trench to be _____ feet wide. Inlet _____ feet below original grade. Bottom maximum depth _____ feet below original grade. Effective area begins at _____ feet below original grade. _____ feet of stone below distribution pipe.
LOCATION:	
PURPOSE:	Septic tank collapsed. Call for inspection when ground is opened so sanitarian can recommend repair.

PLANS APPROVED: KN DATE: 4/24/03

- NOTE: PERMIT VOID AFTER 2 YEARS
- NOTE: CONTRACTOR RESPONSIBLE FOR SCHEDULING A PRE-CONSTRUCTION INSPECTION FOR ALL INSTALLATIONS
- NOTE: WATERTIGHT SEPTIC TANKS REQUIRED
- NOTE: ALL PARTS OF SEPTIC SYSTEM SHALL BE 100 FEET FROM ANY WATER WELL
- NOTE: MANHOLE RISERS REQUIRED ON ALL SEPTIC TANKS AND PUMP CHAMBERS

**NEITHER THE HOWARD COUNTY COUNCIL NOR THE HEALTH DEPARTMENT IS RESPONSIBLE FOR THE SUCCESSFUL OPERATION OF ANY SYSTEM PERMITTEE RESPONSIBLE FOR OBTAINING FINAL APPROVAL ON THIS PERMIT CALL 410-313-2640 FOR INSPECTION OF SEPTIC SYSTEM**

P518632

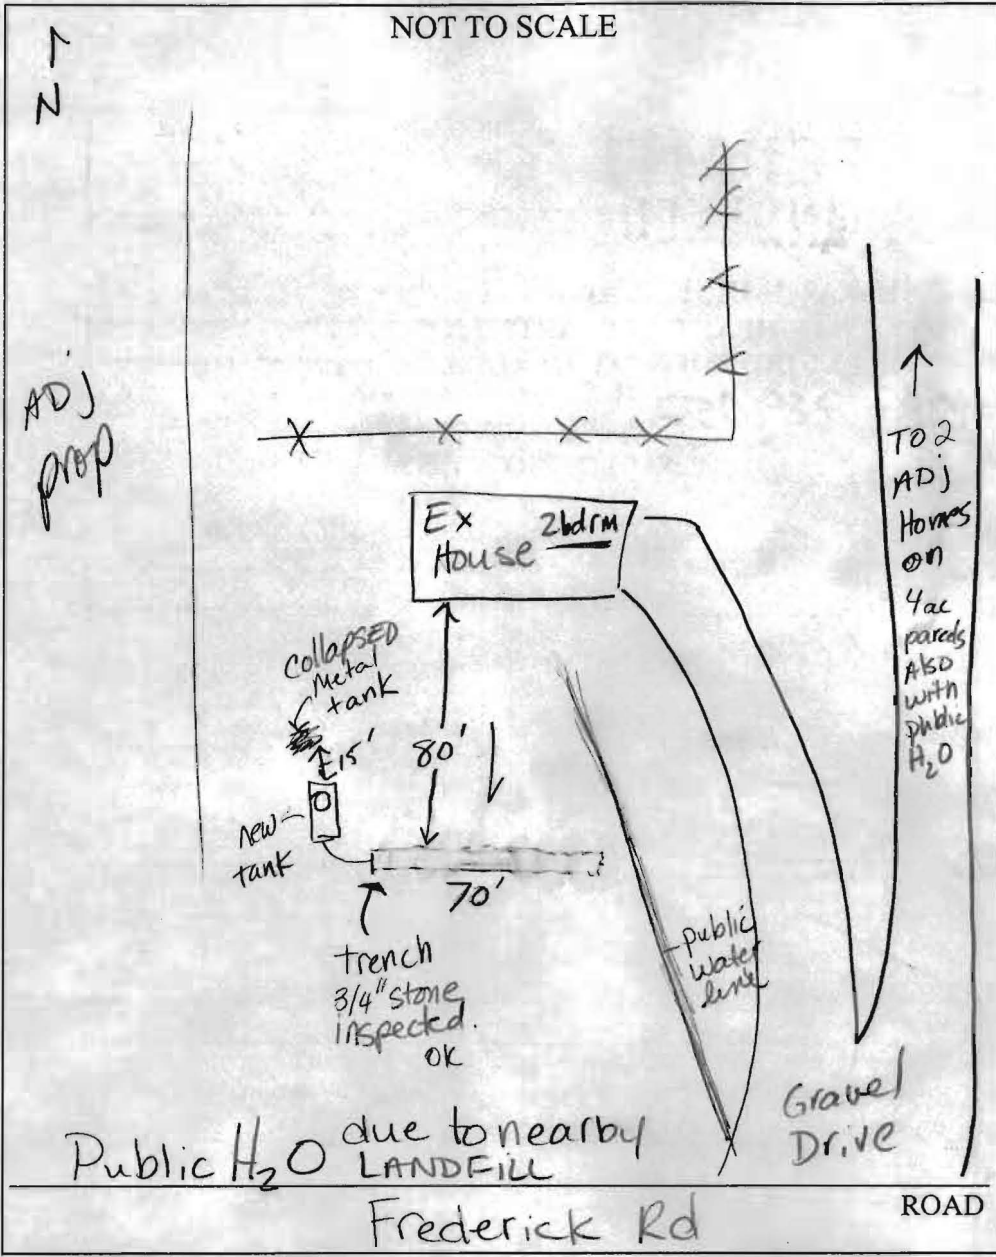

TRENCH/DRAINFIELD DATA.		
WIDTH	INLET	BOTTOM
Existing trench (~2 1/2' - 3' inlet)		
NUMBER OF TRENCHES	1	
TOTAL LENGTH	70' Existing	
ABSORPTION AREA	?	
DISTRIBUTION BOX LEVEL	None	
DISTRIBUTION BOX BAFFLE	NA	
DISTRIBUTION BOX PORT	NA	

SEPTIC TANK DATA		
SEPTIC TANK 1 LEVEL	yes	
New CAPACITY	1,000	GAL
SEAM LOC	Top	
TANK LID DEPTH	2'	
BAFFLES	yes	
BAFFLE FILTER	No	
MANHOLE LOC	Front	
6" PORT LOC	none	
WATERTIGHT TEST	no	
SEPTIC TANK 2 LEVEL	N/A	
CAPACITY		GAL
SEAM LOC		
TANK LID DEPTH		
BAFFLES		
BAFFLE FILTER		
MANHOLE LOC		
6" PORT LOC		
WATERTIGHT TEST		

PRE-CONSTRUCTION \_\_\_\_\_

INSTALLATION 4-24-03 Replaced caved-in metal septic tank with new 1,000 gallon top seam tank. Mike Skipper, with Fyock, observed dry, but somewhat used existing trench when he connected new S.T. to existing trench. House's public water line located. <sup>approximately</sup> No old well found on property in back yard area. History of private water supply said to be contaminated. ∴ public H<sub>2</sub>O hook-up.

FCN/FA

FINAL INSPECTOR Kaci Noonan

DATE OF APPROVAL 4/24/03

C058

REGION \_\_\_\_\_

AREA \_\_\_\_\_ RATING \_\_\_\_\_

ACKNOWLEDGMENT AND CONTROLS	DATE

Howard County Department of Health  
BUREAU OF ENVIRONMENTAL HEALTH

DISPOSITION	DATE

RECORD OF INVESTIGATION

LOCATION (elderly) ZIP \_\_\_\_\_  
 OWNER  Katherine Klein ADDRESS 11362 Federick Rd. PHONE 410-531-2309  
 OCCUPANT  \_\_\_\_\_ ADDRESS P.C. 21042 PHONE 410-985-8055  
 COMPLAINANT Cecily Deverin ADDRESS 11394 Federick Rd. PHONE \_\_\_\_\_  
P.C. 21042

REASON FOR INVESTIGATION \_\_\_\_\_  
- septic has no covering - it collapsed (2) wks ago  
- the smell is horrible.  
 \_\_\_\_\_ CODES \_\_\_\_\_

RECEIVED BY Que M. Shoup DATE 4/15/03 ASSIGNED TO \_\_\_\_\_ DATE \_\_\_\_\_

DATE OF INVESTIGATION 4-17-03 TIME 3:15 p.m. WEATHER cold, dry, windy

REPORT Ground is soft downslope of hole. Soils appear to be a sandy, mucaceous loam. There is no presence of black carbon material in the soil, however there is a container filled with sewage up to its surface. Parts of it, i.e. baffle, appears to be made of metal. I assume the septic tank is deteriorating and the dry well, somewhere downslope, is completely saturated.

Katherine has a contractor in mind

DATE SUBMITTED 4-17-03 SANITARIAN Kacie Noonan & Keren Francis