


50' R/W  
ALBETH ROAD  
21.6'± MAC PAVING

EDGE MAC

B00140955

4/9/08 JB  
SUNROOM  
addition 0.12

50' B.R.L.

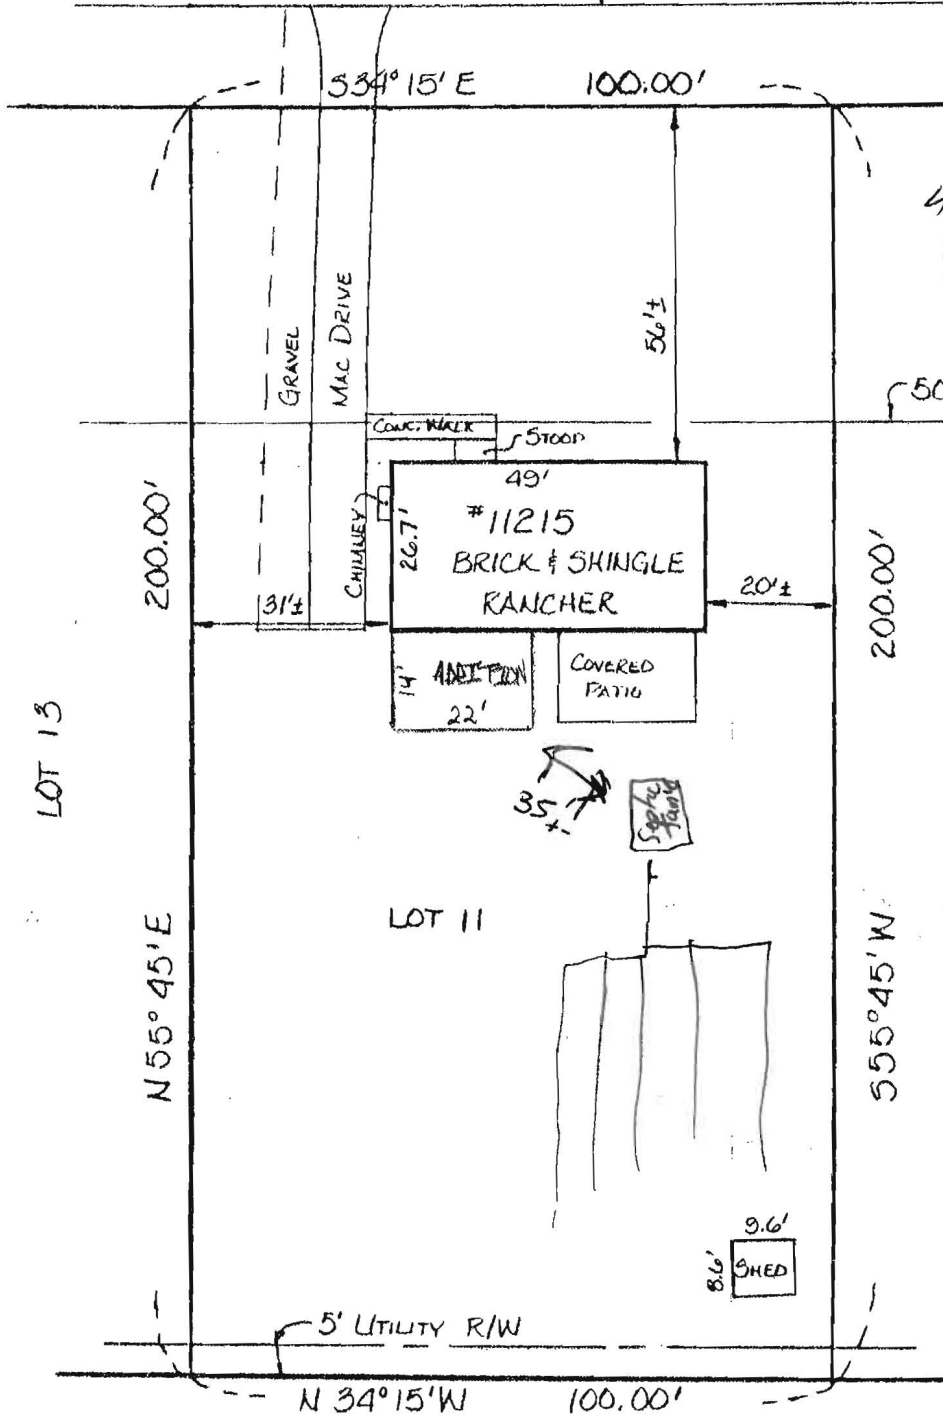

A05879  
P06484

2008 AP - 1 PM 3:16