

Tax ID-05-400252
Filer

8/28/89(2) P.C.O.

PERMIT

SEWAGE DISPOSAL SYSTEM

MARYLAND STATE DEPARTMENT OF HEALTH

HOWARD COUNTY
BUREAU OF ENVIRONMENTAL HEALTH
461-9933

INDEXED

P 45033

A 39336

DISTRICT 5th

DATE 10/5/89

DATE SYSTEM APPROVED 8/29/89

INSPECTOR C.B.D.

Jack Fyock, Jr.

IS PERMITTED TO INSTALL ALTER

ADDRESS 13775 Triadelphia Road, Glenelg, Md. 21737 PHONE 988-9270

SUBDIVISION Fox Pause ROAD 11940 Hall Shop Road LOT 20, Sec. 2

PROPERTY OWNER LDG Development, Inc. Mr. + Mrs. Steve Adler

ADDRESS Phone: 924-2516

BUILDING PERMIT SIGNED

IF GARBAGE GRINDER IS USED INCREASE SEPTIC TANK CAPACITY BY 50% AND ABSORPTION AREA BY 22% **AND RETURNED**

11308 BU0154992-OFFICE

GARBAGE GRINDER? YES NO

SEPTIC TANK CAPACITY _____ GALLONS NUMBER OF BEDROOMS 4

* HOUSE INSTALLED LOWER THAN PER APPROVED BUILDING PERMIT PLAN.

Install 2000 gallon tank and 1000 gallon tank in series as shallow as possible.

Determination of trench location and length to be made at time of tank installation.

8/28 [some parts of trench 8'± and to stay near new home due to water wells at rear of lots. C.B.D. for C.W.]

180 sq ft Bedroom @ C.B.D. - left permit. Houses is sep. water well in ... (C.B.D. for back)

PLANS APPROVED BY Craig Williams DATE 7/21/89

COVER NO WORK UNTIL INSPECTED AND APPROVED

NEITHER THE HOWARD COUNTY COUNCIL NOR THE HEALTH DEPARTMENT IS RESPONSIBLE FOR THE SUCCESSFUL OPERATION OF ANY SYSTEM.

NOTE: CLEANOUT REQUIRED EVERY 70 FEET OF SEWER LINE AND/OR AT 90° SWEEPS IN LINES FROM HOUSE TO DRAIN FIELDS

NOTE: ALL PARTS OF SEPTIC SYSTEMS (I.E. TANK, DISTRIBUTION BOX, TRENCHES) TO BE 100 FEET FROM WELL (UNLESS OTHERWISE SPECIFICALLY AUTHORIZED)

NOTE: IF DEEP TRENCHES ARE USED CALL FOR INSPECTION BEFORE AND AFTER PLACING GRAVEL IN TRENCHES

NOTE: NO DRY WELL SHALL EXCEED 15 FOOT IN DIAMETER NO ABSORPTION TRENCH TO EXCEED 100 FEET IN LENGTH

NOTE: ALL PIPE FROM HOUSE TO SEPTIC TANK MUST BE CAST IRON OR SCHEDULE 40 PVC OR ABS

PERMIT VOID AFTER TWO YEARS

NOTE: INSTALL STAND PIPE ON SEPTIC TANK AND DRY WELL. STAND PIPES MUST BE 6 INCHES IN DIAMETER. CAST IRON, CONCRETE OR TERRA COTTA OR PVC OR ABS ACCEPTED. IF TOP OF SEPTIC TANK IS DEEPER THAN 3 FEET, MANHOLE TO GRADE REQUIRED

NOTE: DISTRIBUTION BOXES MUST HAVE BAFFLES

BLDG. PERMIT SIGNED


AND RETURNED

10/4/89 Seal # 50812 Proben

A 39336

***INSTALLER IS RESPONSIBLE FOR OBTAINING FINAL APPROVAL ON THIS PERMIT**

*CALL 461-9933 FOR INSPECTION OF SEPTIC SYSTEMS.

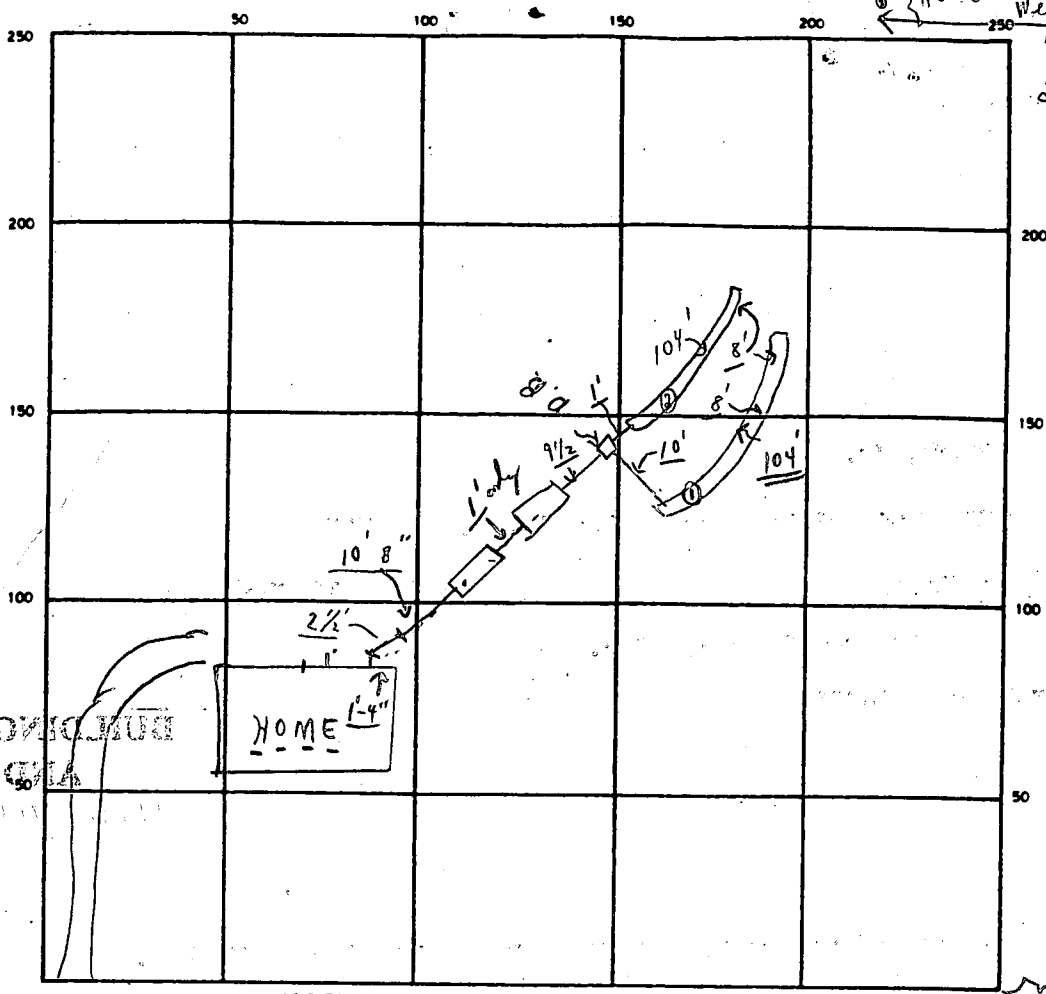

BUILDING PERMIT SIGNED AND RETURNED

INDICATE NORTH — NAME ADJOINING ROADWAY AS BASE LINE

HALL SHOP ROAD

SEPTIC TANK LEVEL OK CLEANOUTS OK S.T. 1 OK S.T. 2 OK

DISTRIBUTION BOX LEVEL OK (Baffle in) needs top

DRAIN FIELD/TILE FIELD DEPTH ① +8 ± FT. TRENCH WIDTH ② 2 FT. INLET DEPTH ① 1/2 FT.

EFFECTIVE GRAVEL DEPTH ① 6' ± average FT. TOTAL LENGTH ① 104 ± FT.

NUMBER OF TRENCHES ① Partly ONE SIDEWALL/BOTTOM AREA ② 624 3 = 1248 SQ. FT.

DRYWELL INSIDE DIAMETER — FT. EFFECTIVE DEPTH BELOW INLET — FT.


ABSORBENT AREA 1248 SQ. FT.

REMARKS Partial 8/28/89 ① HOUSE IS UP AND WATER WELL IN AT REAR; ② LATE-P.M.
Partial (1) trench - GRAVEL TO 1/2 OF SURFACE FIRST HALF. C.B.
① Partial 8/29/89 ① Trench covered; ② Final ok to cover all work after big top put on S.T.C.O. & Final.


DATE SYSTEM APPROVED 8/29/89 INSPECTOR Charles Bryan Streater

VICINITY

SCALE: 1" = 2'

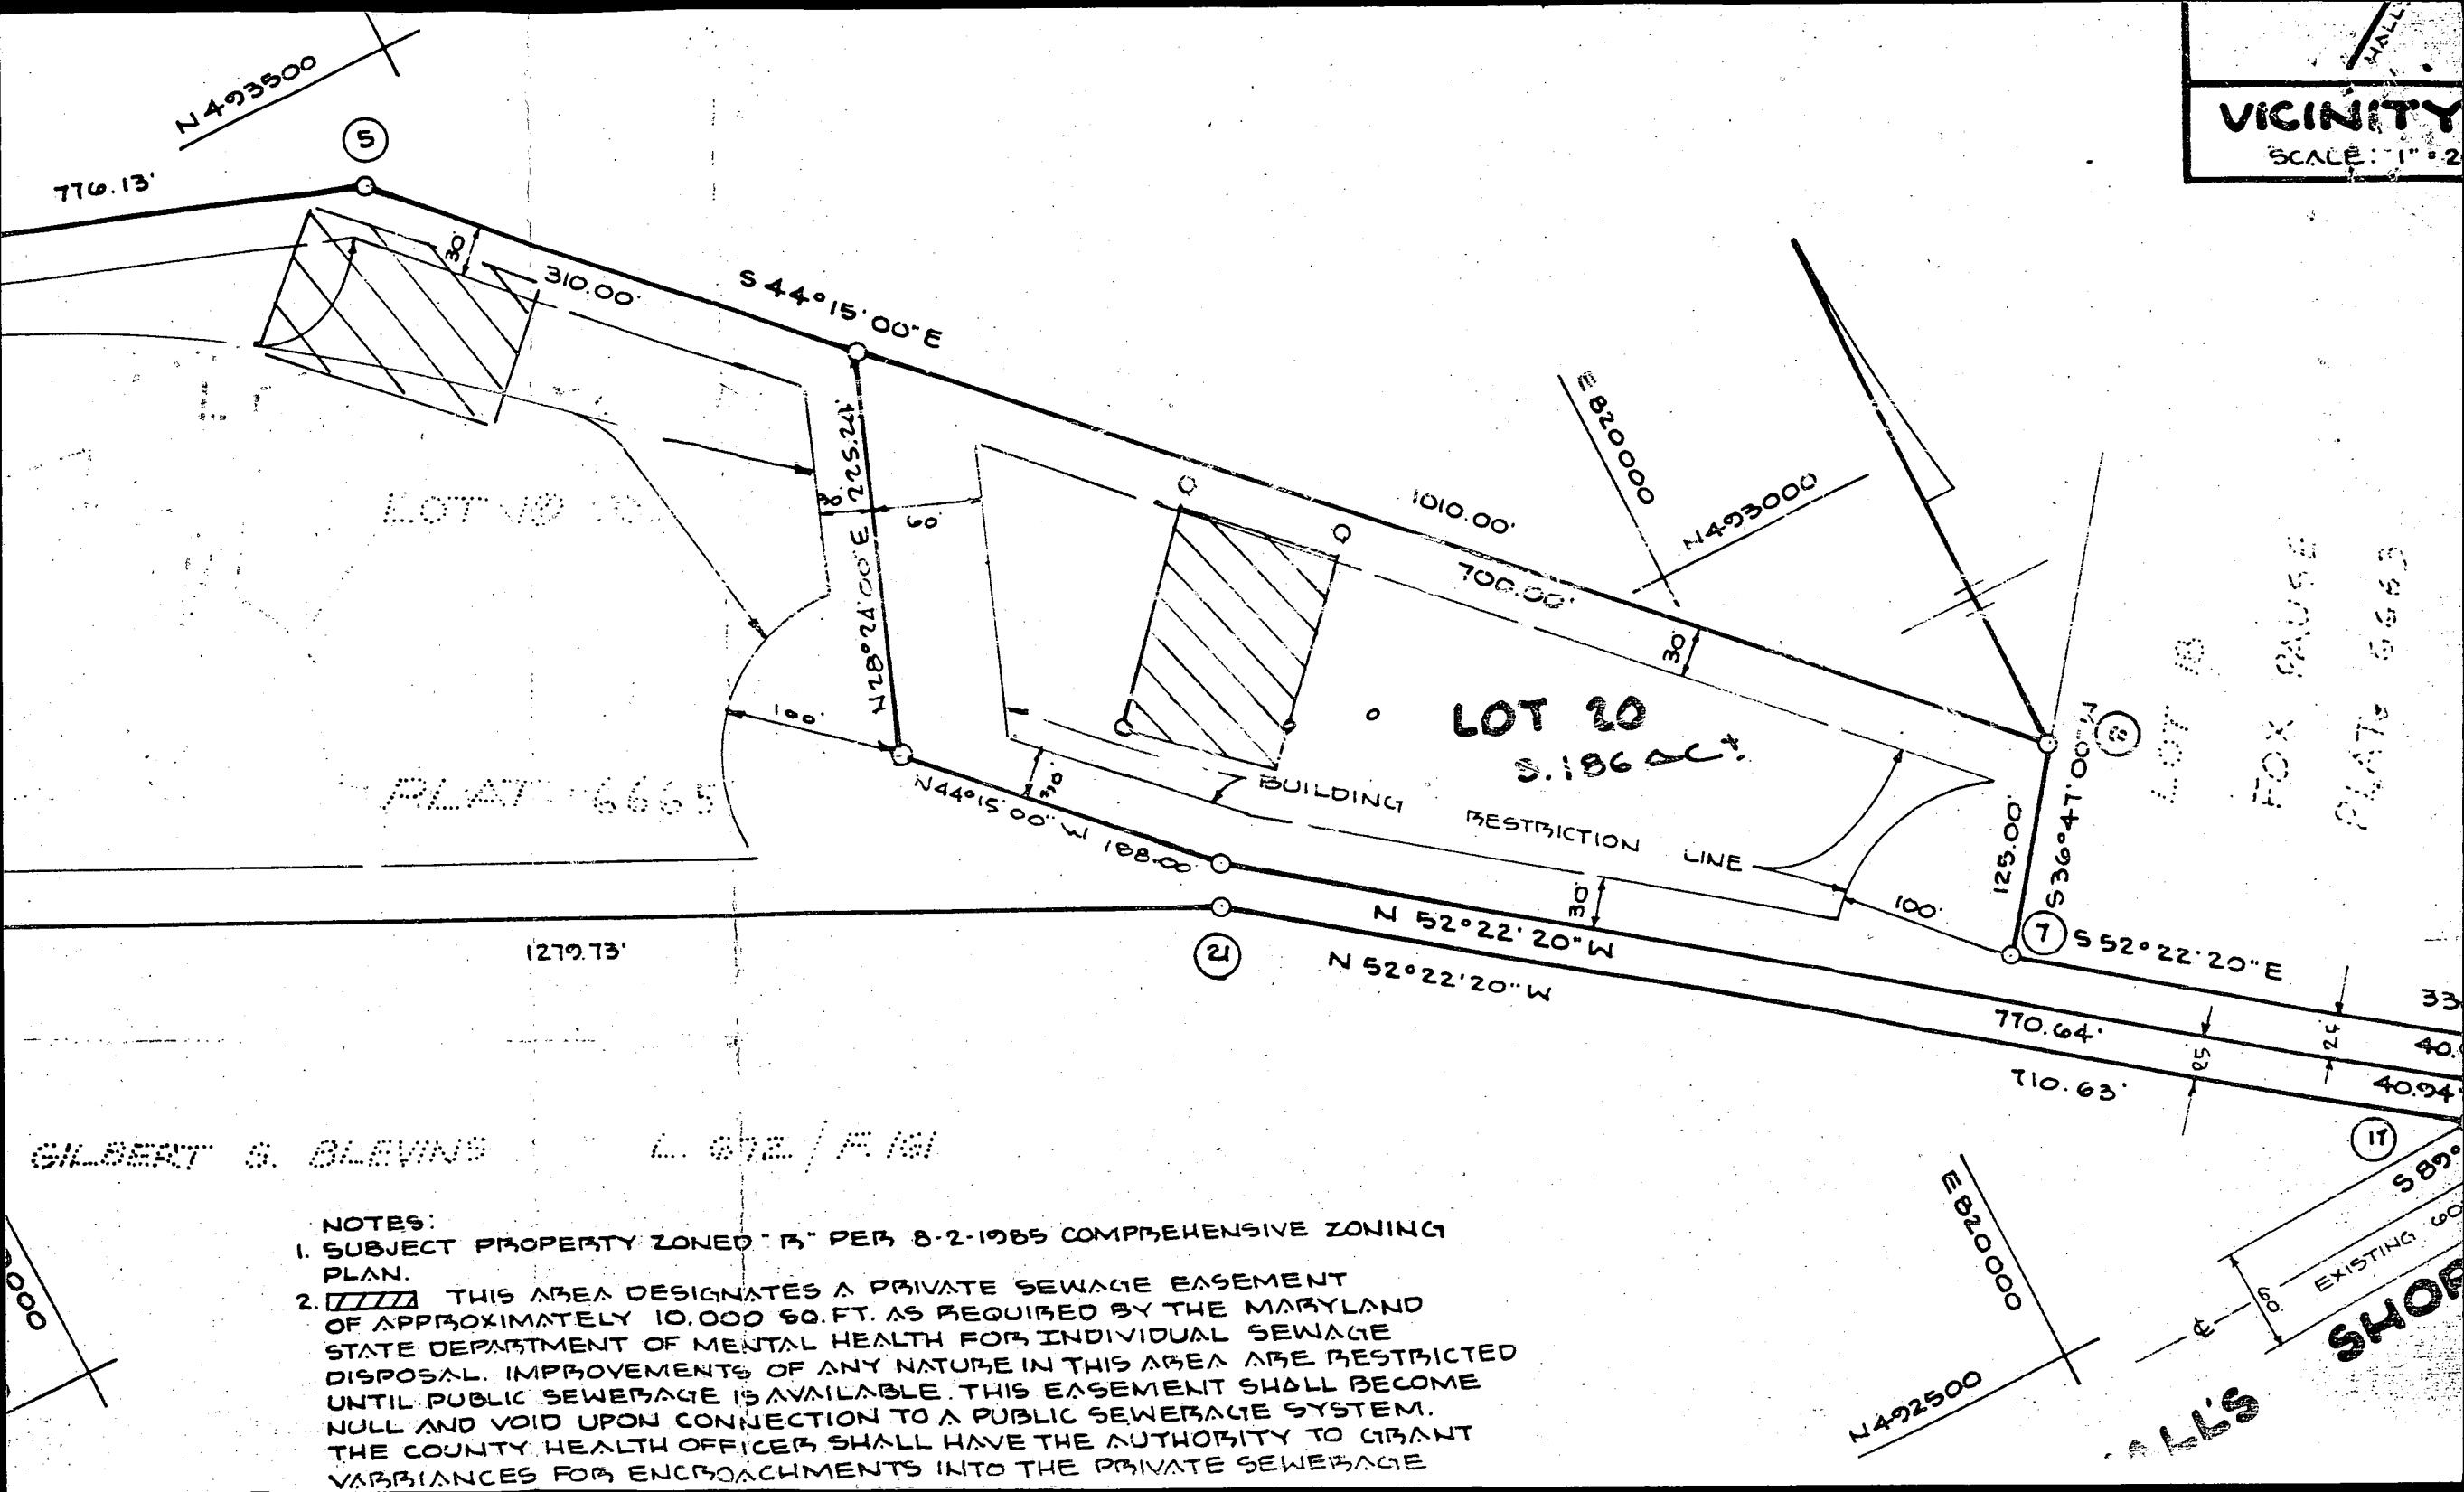

NOTES:

1. SUBJECT PROPERTY ZONED "B" PER 8-2-1985 COMPREHENSIVE ZONING PLAN.
2.  THIS AREA DESIGNATES A PRIVATE SEWAGE EASEMENT OF APPROXIMATELY 10,000 SQ. FT. AS REQUIRED BY THE MARYLAND STATE DEPARTMENT OF MENTAL HEALTH FOR INDIVIDUAL SEWAGE DISPOSAL. IMPROVEMENTS OF ANY NATURE IN THIS AREA ARE RESTRICTED UNTIL PUBLIC SEWERAGE IS AVAILABLE. THIS EASEMENT SHALL BECOME NULL AND VOID UPON CONNECTION TO A PUBLIC SEWERAGE SYSTEM. THE COUNTY HEALTH OFFICER SHALL HAVE THE AUTHORITY TO GRANT VARIANCES FOR ENCROACHMENTS INTO THE PRIVATE SEWERAGE

