

APPLICATION

A 00006
P _____

SEWAGE DISPOSAL TESTING

MARYLAND STATE DEPARTMENT OF HEALTH

HOWARD COUNTY

150 Gallon tank

ELLICOTT CITY

DISTRICT 9

DATE 9-8-64

Dry Well - 300 soft sidewall
aka below the inlet

Place the dry well 140 ft to 160 ft
from the front lot line
7-11-64 JS

TO: THE COUNTY HEALTH OFFICER
ELLICOTT CITY, MARYLAND

I, HEREBY, APPLY FOR THE NECESSARY TESTS IN ORDER TO CONSTRUCT OR RECONSTRUCT A SEWAGE DISPOSAL SYSTEM.

PROPERTY OWNER Andrew Zello

ADDRESS 624 Platoon Pl, Greenbelt, MD 20740 PHONE 474 1283

PROPERTY LOCATION:

SUBDIVISION Heperin Court LOT NO. 22

ROAD AND DESCRIPTION East Side Oakcrest Lane

A parcel 1/2 mi South Johns Hopkins

OCCUPANT _____ PHONE _____

PERSON TO CONSTRUCT SYSTEM _____

ADDRESS _____ PHONE _____

SIZE OF LOT 1.1222 acres TYPE BLDG. 3 - 1/2

IF NOT SINGLE RESIDENCE DESCRIBE _____

SIGNATURE OF APPLICANT Andrew Zello

APPROVED BY Raymond Hodges FOR Dry Well DATE 15 Sept 64


REJECTED BY _____ FOR _____ DATE _____

HOLD PENDING FURTHER TESTS _____ DATE _____

REASONS FOR REJECTION OR HOLDING _____

RECEIVED
SEP 10 1964
ELLICOTT CITY, MD

THIS IS NOT A PERMIT

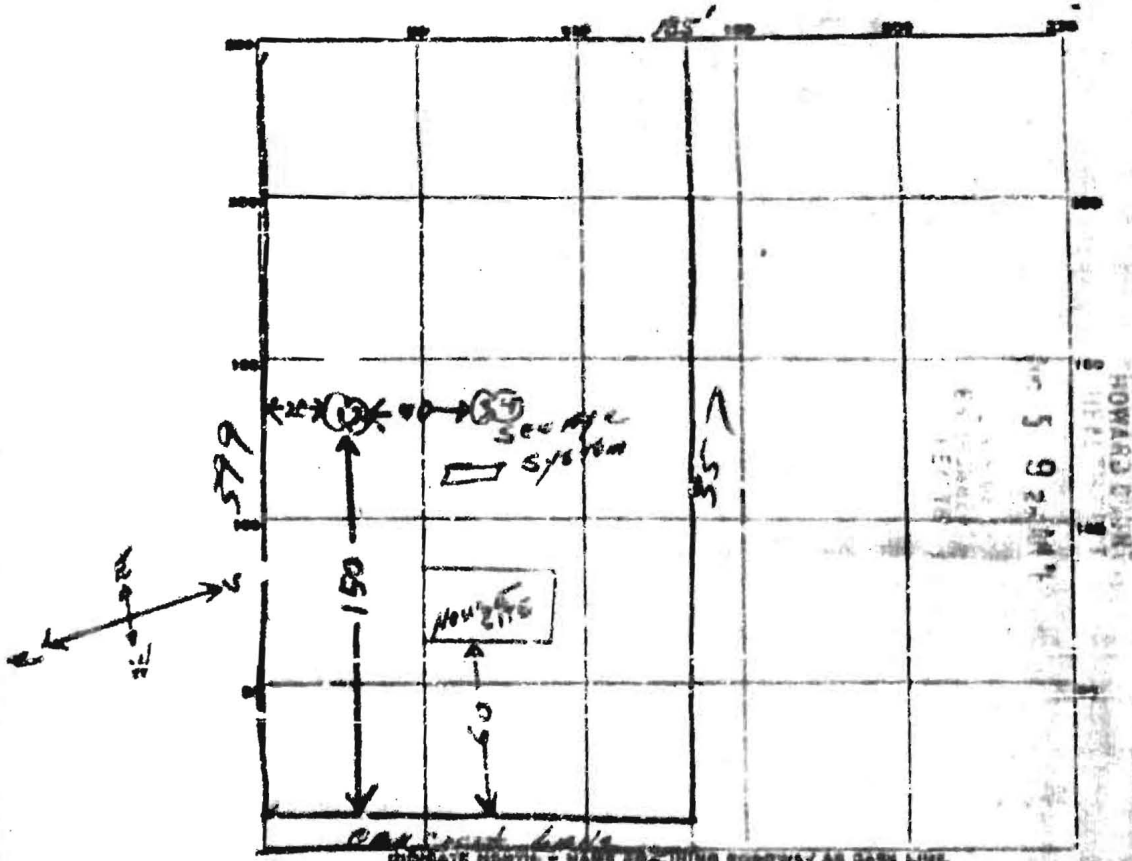

DATE NORTH - NAME RESIDING ROADWAY AS BASE LINE.

DATE	TEST NO.	DEPTH	PRO-WET		TEST - 1" SOOP		TIME
			START	STOP	START	STOP	
11/11	1	9	959	1003	1003	1006	3
	2	4	1002	1003	1003	1004	1
	3	4	1004	1007	1007	1011	4
11	4	5	1007	1008	1008	1011	3

SOIL AUGER FINDING

TESTED BY Raymond Hodges

REMARKS

ALSO PRESENT Barbara Hodges LOT NO. 32