

2092

STATE OF MARYLAND WATER RESOURCES ADMINISTRATION TALESTATE OFFICE 6500, ANNAPOLIS, MD. 21401 WELL COMPLETION REPORT

FILL IN THIS FORM COMPLETELY COUNTY NUMBER A17919

COMMUNITY: A5/18/73 DATE WELL COMPLETED: 105 DEPTH OF WELL (TO NEAREST FOOT): 22 20 PERMIT NO. FROM "PERMIT TO DRILL WELL": 20-12-2350 20 20 20 21 22 23 24 25 26 27 DRILLERS IDENTIFICATION NO.: 209

OWNER: WILLMAN LAST NAME FIRST NAME: HOBART STREET OR RFD: Sink Hollow Road POST OFFICE: Highland 20777

Table with columns: DESCRIPTION, FEET, TO. Rows: Sink sand (0-60), Sink rock (60-105).

GROUTING RECORD: WELL HAS BEEN GROUTED (CIRCLE APPROPRIATE BOX) TYPE OF GROUTING MATERIAL: (C) MORTAR (B) CEMENT (D) OTHER. NO. OF BAGS: 7 NO. OF POUNDS: 658. GALLONS OF WATER: 70. DEPTH OF GROUT SEAL (NEAREST FOOT): FROM 0 TO 70.

CASING RECORD: INSERT APPROPRIATE CODE BELOW. MAJN CASING TYPE: (B) T. NOMINAL DIAMETER TOP (NEAREST INCH): 6. TOTAL DEPTH OF MAIN CASING (NEAREST FOOT): 60.


OTHER CASING (IF USED): DIAMETER (INCH) DEPTH (FEET). SCREEN RECORD: INSERT APPROPRIATE CODE BELOW. (S) T. (M) H. (N) O. (P) L. (O) Y.

DEPTH (NEAREST WHOLE FOOT) FROM TO. 1: 0 1 2 99 100.

PUMPING TEST: HOW LONG PUMPED (TO NEAREST HOUR): PUMPING RATE (GALLONS PER MINUTE TO NEAREST GALLON): METHOD USED TO MEASURE PUMPING RATE: WATER LEVEL (DISTANCE FROM LAND SURFACE) BEFORE PUMPING: 10. TYPE OF PUMP USED (CIRCLE APPROPRIATE BOX FOR PUMPING TEST): (A) AIR (B) PISTON (C) CENTRIFUGAL (D) ROTARY (E) OTHER (F) JET (G) SUBMERSIBLE.

PUMP INSTALLED: TYPE OF PUMP (CIRCLE APPROPRIATE LETTER IN BOX): DRILLER WILL INSTALL PUMP (CIRCLE APPROPRIATE BOX): CAPACITY: GALLONS PER MINUTE (TO NEAREST GALLON): PUMP HORSE POWER: PUMP COLUMN LENGTH (NEAREST FOOT):

CASING HEIGHT (CIRCLE APPROPRIATE BOX AND ENTER CASING HEIGHT): (+) ABOVE (0) LAND SURFACE (1) BELOW. 1: 2: 3:

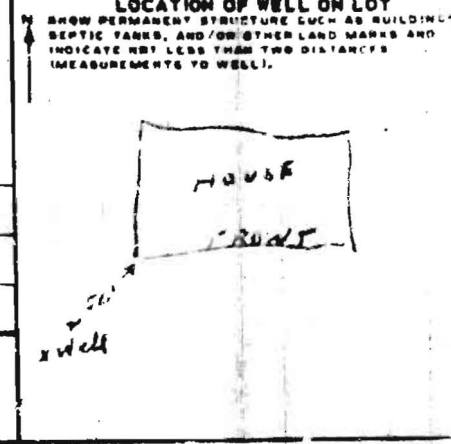

CIRCLE APPROPRIATE BOXES: (A) WELL HAS ABANDONED AND SEALED WHEN THIS WELL WAS COMPLETED. (E) ELECTRIC LOG OBTAINED. (P) TEST WELL CONVERTED TO PRODUCTION WELL. I HEREBY CERTIFY THAT I HAVE COMPLIED WITH ALL CONDITIONS STATED ON THE ABOVE-CAPTIONED "PERMIT TO DRILL WELL", AND THAT INFORMATION CONTAINED IN THIS REPORT IS TRUE, ACCURATE, AND COMPLETE TO THE BEST OF MY KNOWLEDGE, INFORMATION AND BELIEF. DRILLERS NAME: Howard Wilson. SIGNATURE: Howard Wilson.


DIAMETER OF SCREEN (NEAREST INCH) FROM TO. GRAVEL PACK. IF WELL DRILLED WITH A P. ORING WELL CIRCLE: (P). DRILLERS USE ONLY (NOT TO BE FILLED IN BY DRILLER): TELEPHONE CALLING LOG INDUSTRY: LOG INDUSTRY: OTHER DATA AVAILABLE.

HOUSE LOCATION

272.37

MR & MRS DAVID FULTZ

PART OF LIBER 284 FOLIO 288  
SCALE 1" = 50'

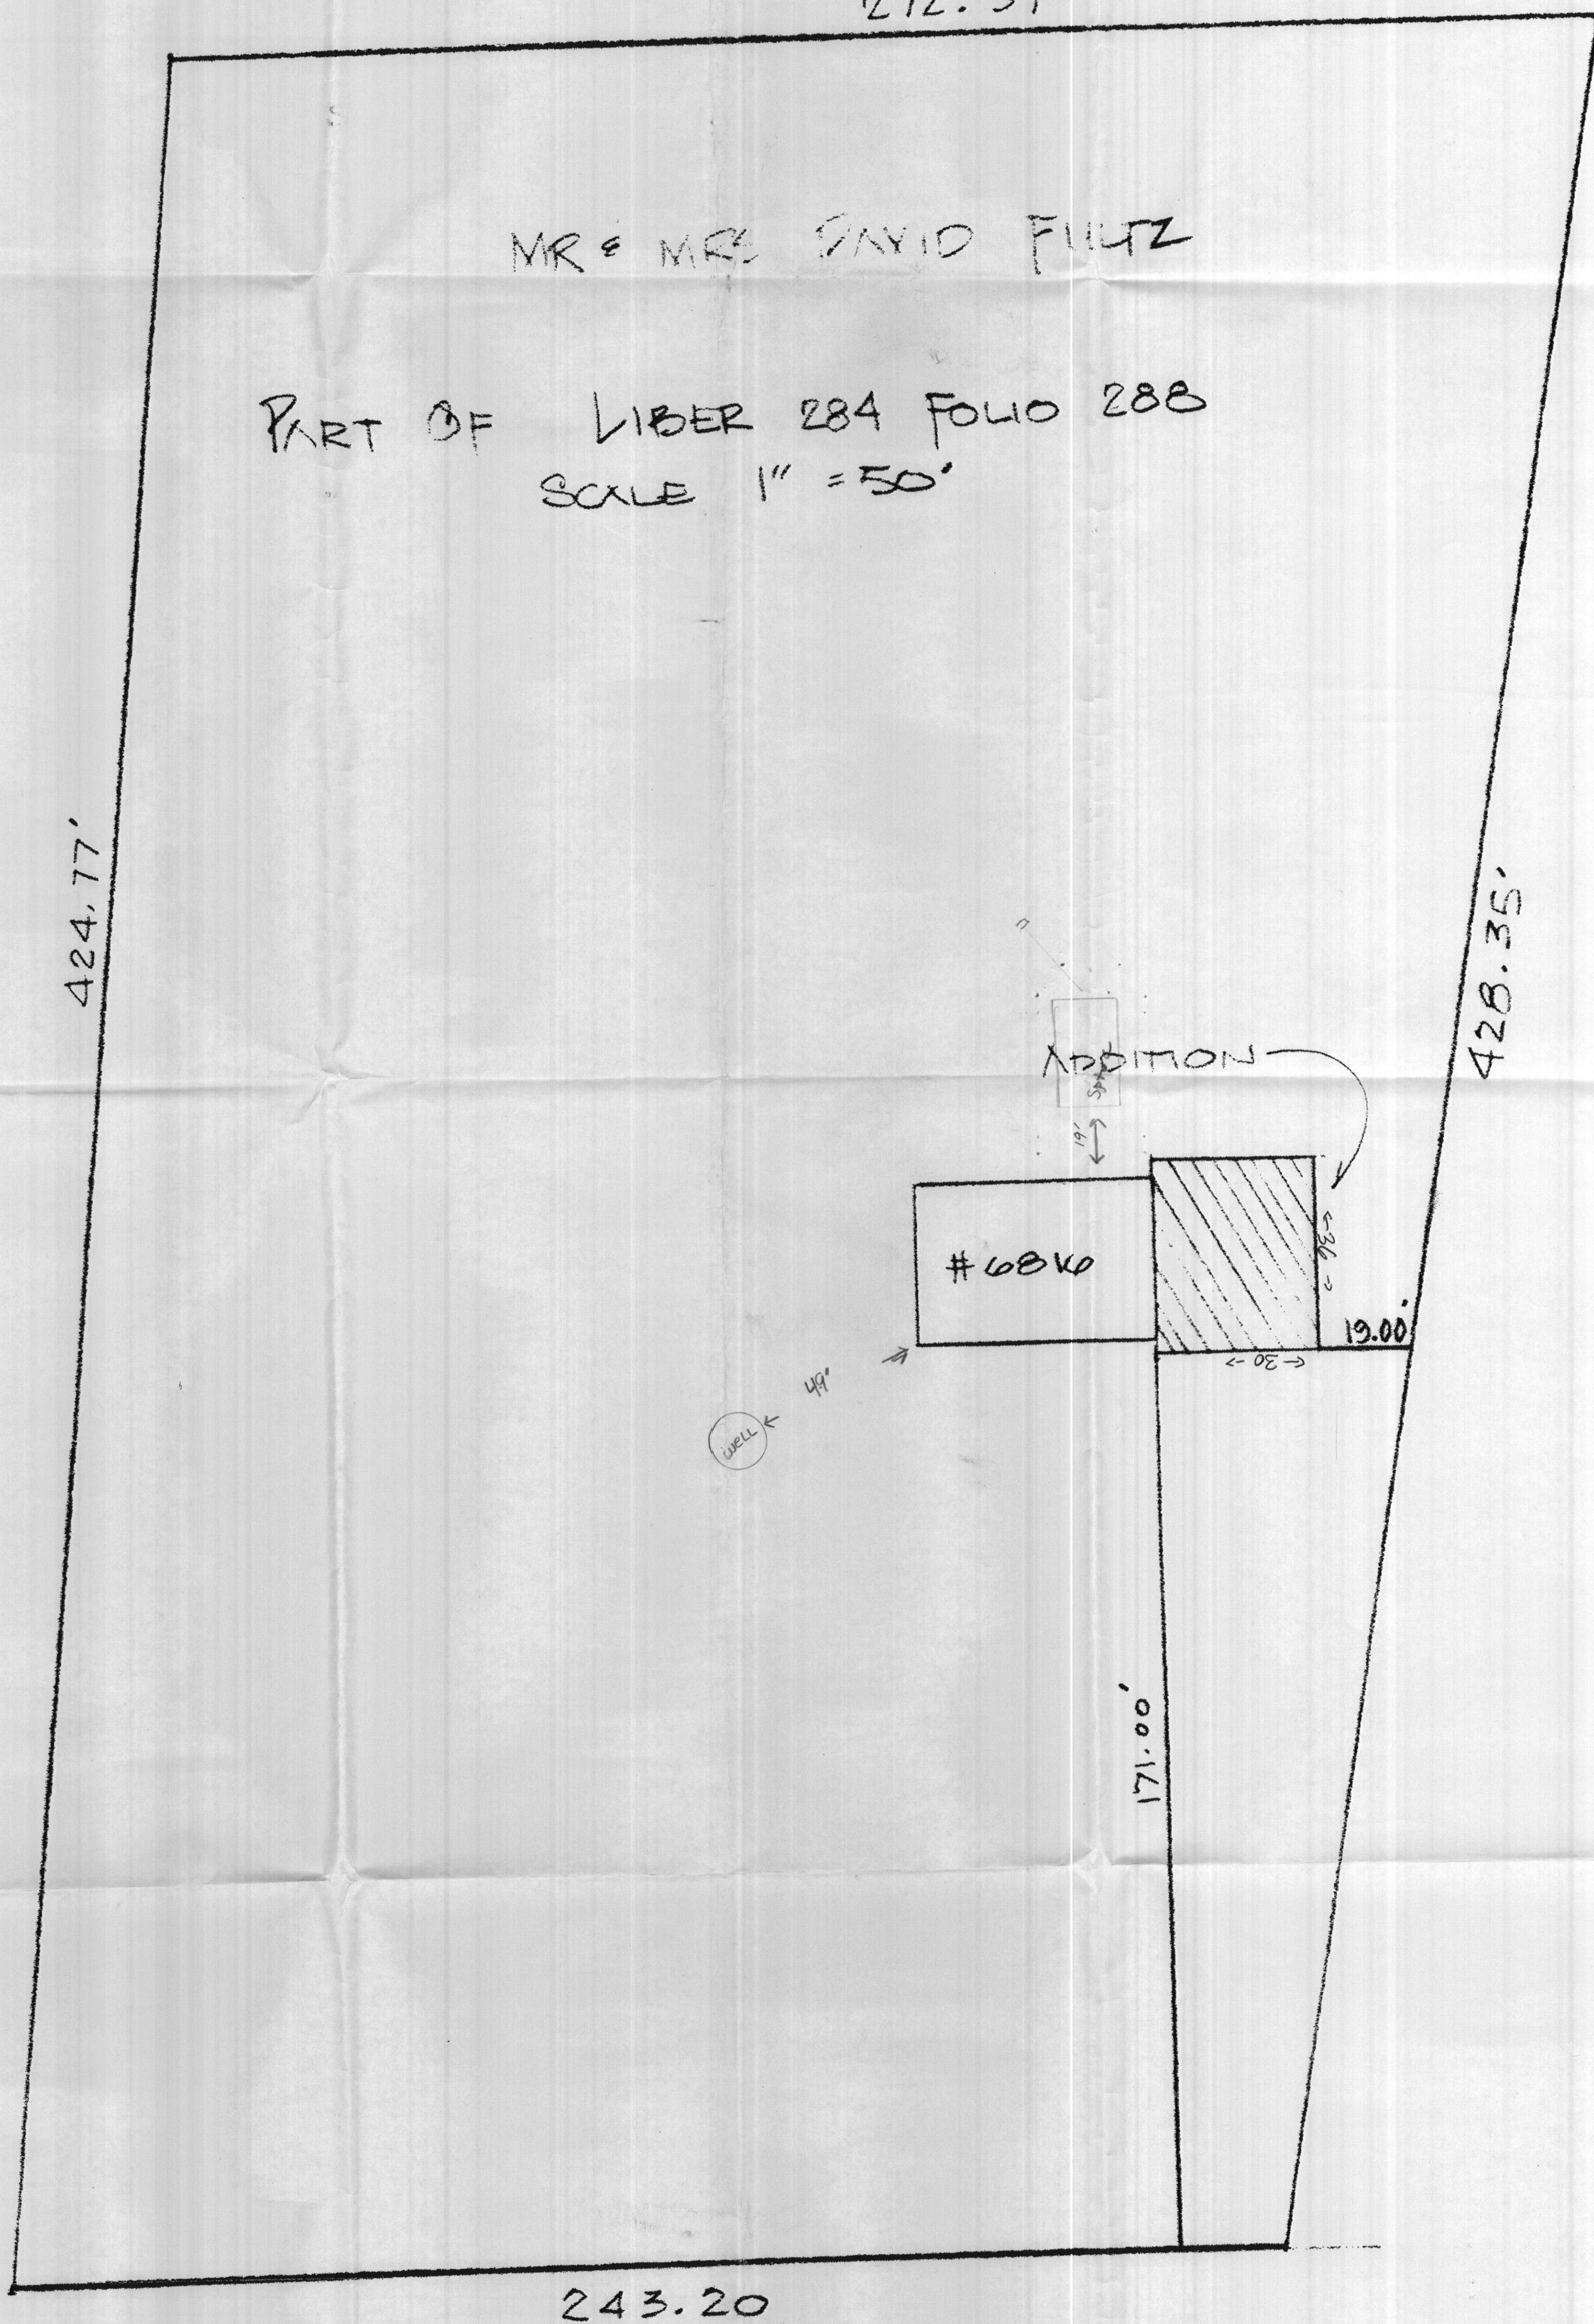

David FULTZ  
6816 Mink Hollow Road  
Highland, Md 20777  
301-854-9568