

APPLICATION

1969

SEWAGE DISPOSAL TESTING

STATE OF MARYLAND - DEPARTMENT OF HEALTH AND MENTAL HYGIENE

HOWARD COUNTY HEALTH DEPARTMENT
ENVIRONMENTAL HEALTH SERVICES
P. O. BOX 476, ELLICOTT CITY, MARYLAND 21043
TELEPHONE: 410-5060, EXT. 300

DISTRICT 702

DATE 2/6/73

TO THE COUNTY HEALTH OFFICER
ELLICOTT CITY, MARYLAND

I, HEREBY, APPLY FOR THE NECESSARY TEST IN ORDER TO CONSTRUCT (OR RECONSTRUCT) A SEWAGE DISPOSAL SYSTEM.

PROPERTY OWNER Bettie Dillman

ADDRESS Mink Hollow Road, Highland, Md.

Call: Ralph Dillman
PHONE 886-3945

PROPERTY LOCATION

SUBDIVISION _____ LOT NO. _____

ROAD AND DESCRIPTION Mink Hollow Road - lot 1000 to the right after passing Deer Valley
Road which is on left hand side of road, Robert Dillman on mailbox.

SIZE OF LOT 2.500 acres TYPE BLDG. 3 bedrooms
NUMBER OF BEDROOMS _____

IF NOT SINGLE RESIDENCE DESCRIBE _____

THE SYSTEM INSTALLED UNDER THIS APPLICATION IS ACCEPTABLE ONLY UNTIL PUBLIC FACILITIES BECOME AVAILABLE.

SIGNATURE OF APPLICANT Denzel Dillman


APPROVED BY _____ FOR _____ DATE _____
(KIND OF SYSTEM)

REJECTED BY _____ FOR _____ DATE _____
(KIND OF SYSTEM)

HOLD PENDING FURTHER TESTS _____ DATE _____

REASONS FOR REJECTION OR HOLDING _____

THIS IS NOT A PERMIT

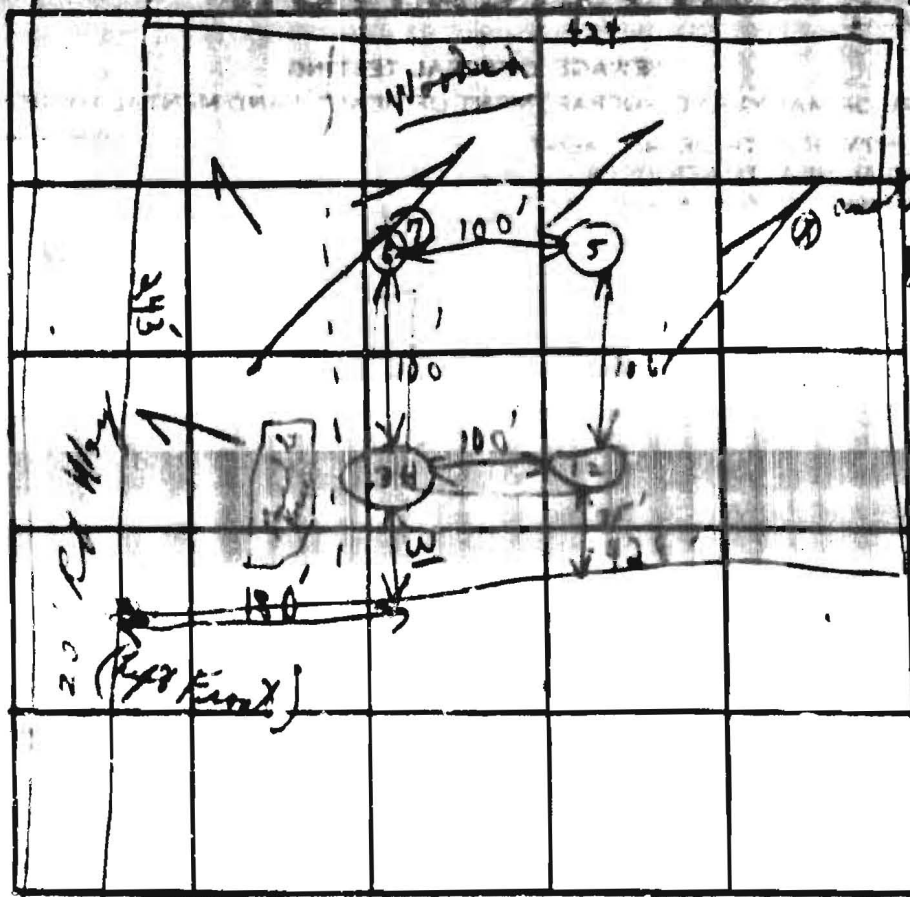

INDICATE WIDTH - NAME - JOINING ROADWAY AS BASE LINE

Hole Hollow

DATE	TEST NO	DEPTH	PRE-WEY		TEST .1' DEEP		TIME	
			START	STOP	START	STOP		
3/2/79	1	12' 0"	10:06	10:11	10:11	10:18	7 min	
	2	3 1/2' S	10:22	10:39	10:39	10:52	19 min	
	3	4' S	10:29	10:36	10:36	10:59	23 min	
	4	3 1/2' S	10:26	10:40	10:40	11:06	26 min	
	5	12'	Visual hole measurement than others					
	6	4' S	11:06	11:09	11:09	11:19	10 min	
	7	11 1/2' 0"	11:04	11:11	11:11	11:29	18 min	
							103	

(Dry 215.40)
 use the 26 min
 18 min average

Soil wet state at 4' level 3 1/2' (Use either 67 or 34)

REMARKS

TYPE OF SOIL Very Dry Brown Sandy Mess Wooded lot

TESTED BY


ALSO PRESENT

2-24-11

A. 3536

Approved by Health Officer & Public Health Board

After this lot is shown to be free from all
the usual sources of infection as
required by the Maryland State Health
Department.

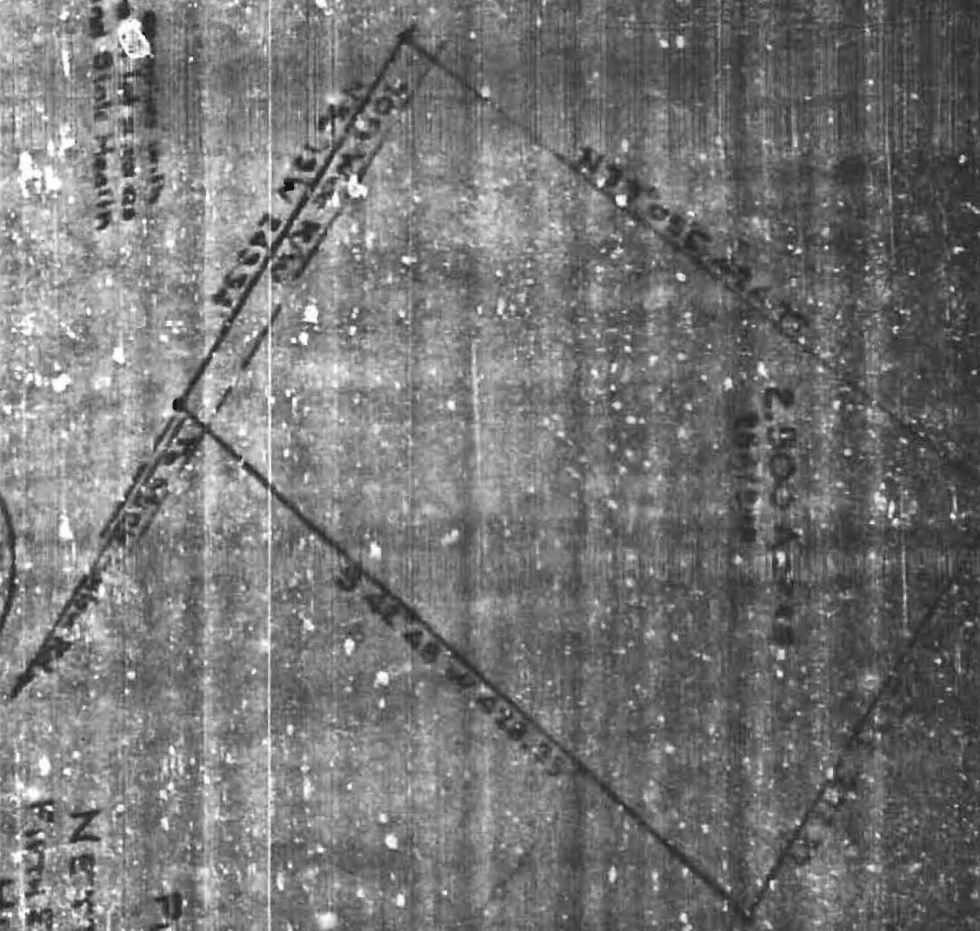

PLAT FOR DEEDS
FOR
NERRIE DELLMAN,
BY Wm. Edward Dyer, Trustee Co.
Highland Park, Md.
Solely in Trust, Dated 10-10-11

