

PERMIT

SEWAGE DISPOSAL SYSTEM

D. 1970
A. 14224

MARYLAND STATE DEPARTMENT OF HEALTH

HOWARD COUNTY

INDEXED

ELLICOTT CITY

DISTRICT 3

DATE 3/16/71

03-280381

INDEXED

Hudson Construction Co.

IS PERMITTED TO INSTALL ALTER

ADDRESS - 8957 Chapel Avenue, Ellicott City, Md.

PHONE NO 5-2205

A SEWAGE DISPOSAL SYSTEM LOCATED AT

SUBDIVISION Evergreen Valley Estates

3121

ROAD Evergreen Way

LOT 31, Sec. 6

PROPERTY OWNER Hudson Construction Co.

ADDRESS

SPECIFICATIONS - 4 bedrooms

DRAIN FIELD _____ DEPTH _____ FEET, BOTTOM AREA _____ SQ. FT.

SEEPAGE PITS _____ ABSORBENT SIDE-WALL AREA _____ SQ. FT.

SEPTIC TANK CAPACITY 1200 GALLONS

FOR GARBAGE GRINDER, INCREASE DISPOSAL AREA 22% & TANK CAPACITY 50%.

OTHER Dry well to be 100 sq. ft. of absorbent sidewall area below the inlet pipe per bedroom. Maximum depth of dry well to be 7 1/2 ft. Locate dry well 99 ft. from right side line and 49 ft. from front property line as lot is now standing on Evergreen Way facing lot.

NOTE: ALL PIPE FROM HOUSE TO SEPTIC TANK MUST BE CAST IRON.

PERMIT VOID AFTER THREE YEAR.

PLANS APPROVED BY James T. Wright

DATE 6/16/70

FILL SEPTIC TANK AND DISTRIBUTION BOX WITH WATER BEFORE CALLING FOR AN INSPECTION. COVER NO WORK UNTIL INSPECTED AND APPROVED.


NEITHER THE HOWARD COUNTY COMMISSIONERS NOR THE HEALTH DEPARTMENT IS RESPONSIBLE FOR THE SUCCESSFUL OPERATION OF ANY SYSTEM.

see permit sheet for more details

**BUILDING PERMIT SIGNED
AND RETURNED**

1-2203 660M1124- ADDITION ABOVE GARAGE

SIB040-C

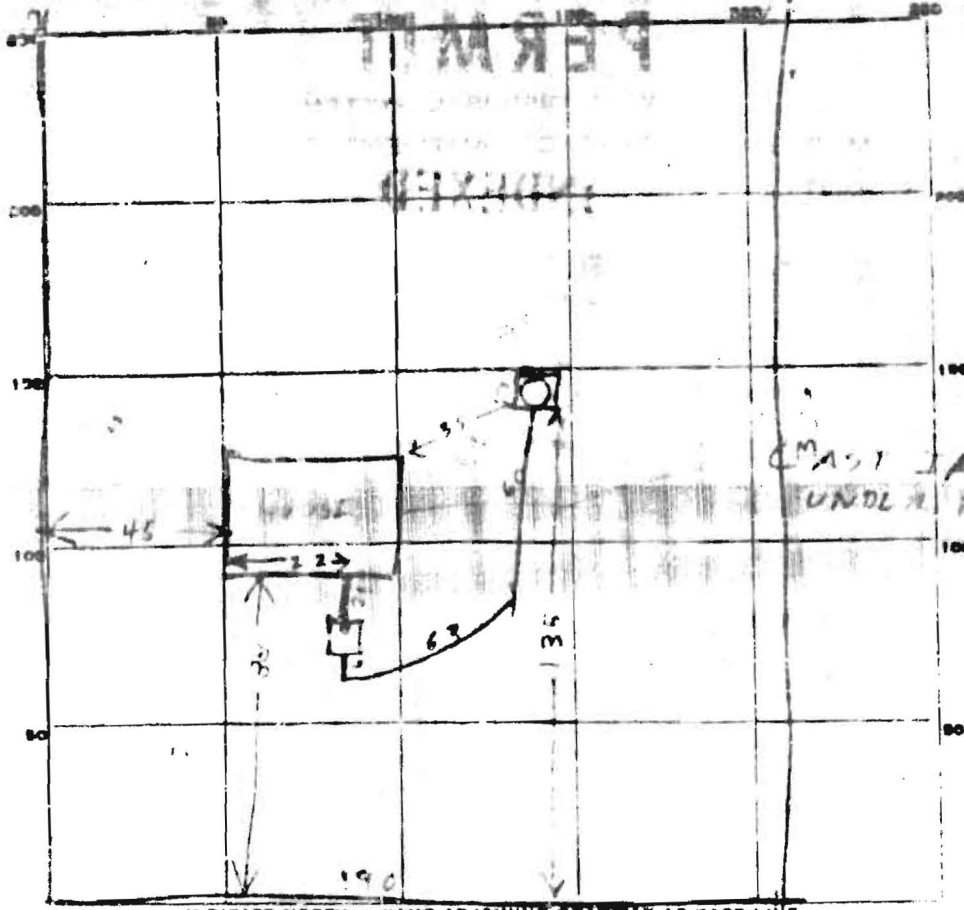

INDICATE NORTH - NAME ADJOINING ROADWAY AS BASE LINE.

PERMIT CARD

SEPTIC TANK, LEVEL 0.5' above 194' CLEANOUT 0.5'

DISTRIBUTION BOX, LEVEL _____

TILE FIELD, DEPTH 4-6 FT. TRENCH WIDTH 2 FT.

GRAVEL DEPTH 36 IN. TOTAL LENGTH 123 FT.

NUMBER OF TRENCHES _____ TOTAL BOTTOM AREA 260

SEEPAGE PITS, INSIDE DIAMETER 7 1/2 FT. DEPTH BELOW INLET 9 FT.

ABSORBENT AREA 307 SQ. FT. counting slope

REMARKS 9/1/71 - Dry well. Inlet diameter 6 inches. 10 ft. deep.

I see a di. sand line 35' of stone in it.
No water in dry well at the well it caused
water to rise. Water out of it.

BUILDING PERMIT SIGNED AND RETURNED


DATE SYSTEM APPROVED 9/1/71 INSPECTOR R. Dodge

60
1951

PERMIT

MARYLAND STATE DEPARTMENT OF HEALTH
SEWER PROVISIONAL PERMIT

INDEXED

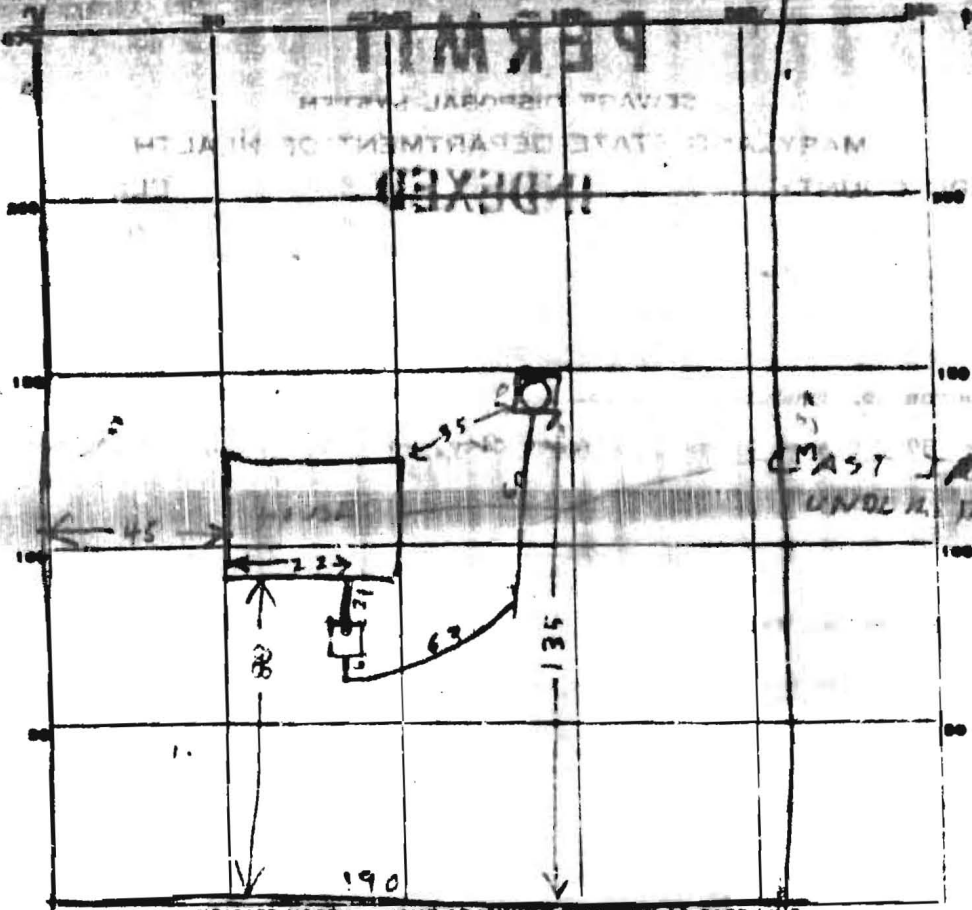

INDICATE NORTH - NAME ADJOINING HIGHWAY AS BASE LINE.

PERMIT CARD

SEPTIC TANK, LEVEL OK ground 16.41 CLEANOUTS 01

DISTRIBUTION BOX, LEVEL _____

TILE FIELD, DEPTH 4-6 FT. TRENCH WIDTH 2 FT.

GRAVEL DEPTH 36 IN. TOTAL LENGTH 123 FT.

NUMBER OF TRENCHES _____ TOTAL BOTTOM AREA 246

SEEPAGE PITS, INSIDE DIAMETER 9 1/2 FT. DEPTH BELOW INLET 9 FT.

ABSORBENT AREA 367 SQ. FT. counting stone

REMARKS 9/2/71 - Dry well located at window side perimeter of dry well
4 FT.

I have also said the tile field has 35% of stone in it
No water in dry well at though it rained
recently. Water well not yet installed

DATE SYSTEM APPROVED 9/2/71 INSPECTOR B. Hodge