

# APPLICATION

SEWAGE DISPOSAL TESTING

A 1422b

P \_\_\_\_\_

MARYLAND STATE DEPARTMENT OF HEALTH

HOWARD COUNTY *lytic for 3 bedroom 1000 gallon* ELLICOTT CITY

DISTRICT 3

DATE 1/27/69

*Dry well to be 100 sq ft of open pit, 24 inches  
area below the inlet pipe per bed room. Mason  
depth of dry well to be 9 1/2 ft. locate by 99 ft from right  
side line and 48 ft from front property line. Lat is seen  
standing on Creeper way facing lat.*

TO: THE COUNTY HEALTH OFFICER  
ELLICOTT CITY, MARYLAND

I, HEREBY, APPLY FOR THE NECESSARY TESTS IN ORDER TO CONSTRUCT OR RECONSTRUCT A SEWAGE DISPOSAL SYSTEM.

PROPERTY OWNER Hudson Construction Co., Inc.

ADDRESS 363 Chapel Avenue, Ellicott City, Md. PHONE HO 5-2205

PROPERTY LOCATION:

SUBDIVISION Evergreen Valley Estates LOT NO. 31, Sec. 6

ROAD AND DESCRIPTION Evergreen Way

OCCUPANT \_\_\_\_\_ PHONE \_\_\_\_\_

PERSON TO CONSTRUCT SYSTEM \_\_\_\_\_

ADDRESS \_\_\_\_\_ PHONE \_\_\_\_\_

SIZE OF LOT 120' x 260' x 180' x 260' TYPE BLDG. 3 of 6  
NUMBER OF BEDROOMS

IF NOT SINGLE RESIDENCE DESCRIBE \_\_\_\_\_

SIGNATURE OF APPLICANT /s/ Madeline Leonard

APPROVED BY James Wright FOR Dry well DATE 6/16/70  
(KIND OF SYSTEM)


REJECTED BY \_\_\_\_\_ FOR \_\_\_\_\_ DATE \_\_\_\_\_  
(KIND OF SYSTEM)

HOLD PENDING FURTHER TESTS \_\_\_\_\_ DATE \_\_\_\_\_

REASONS FOR REJECTION OR HOLDING \_\_\_\_\_

## THIS IS NOT A PERMIT

16  
10  
7

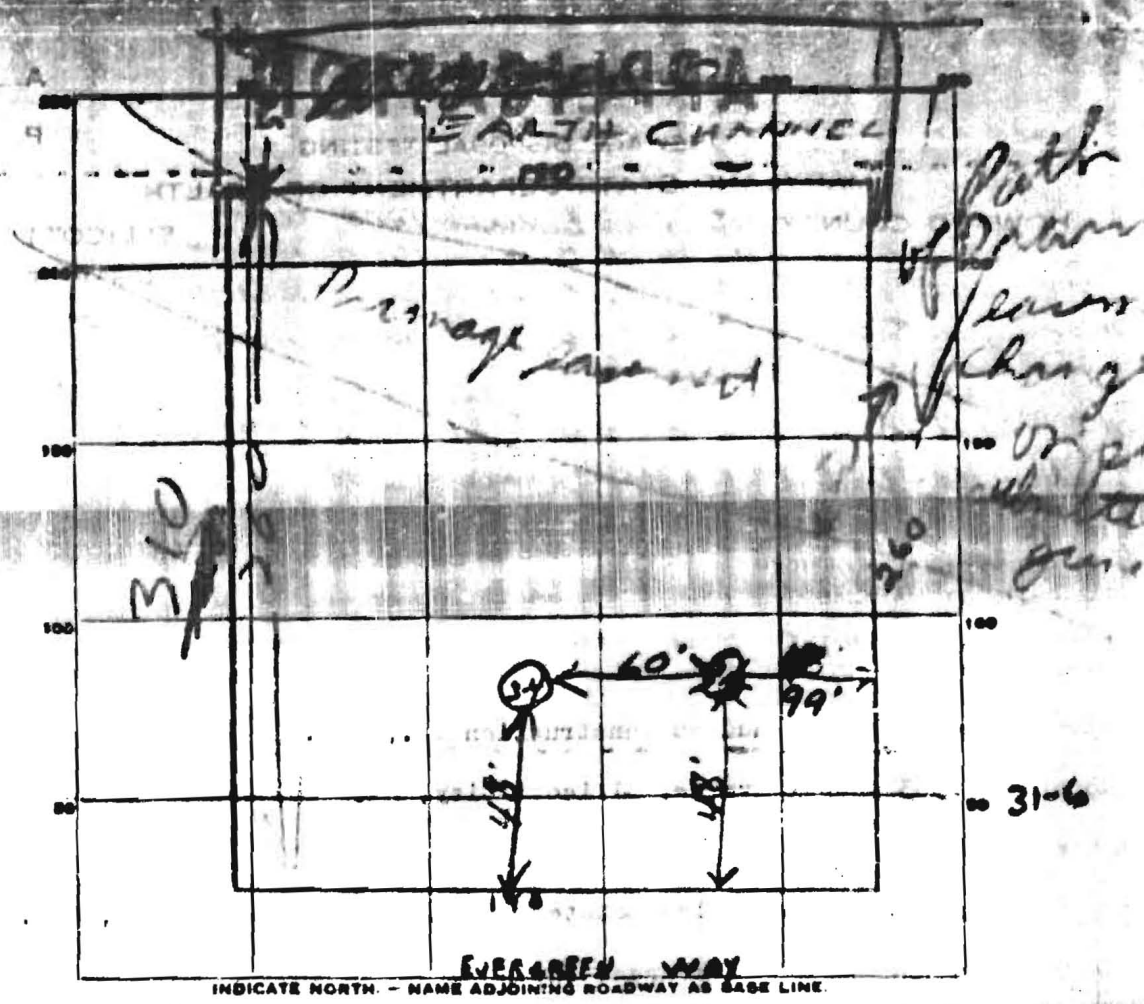

INDICATE NORTH - NAME ADJOINING ROADWAY AS BASE LINE.

DATE	TEST NO.	DEPTH	PRE-WET		TEST - 1" DROP		TIME
			START	STOP	START	STOP	
	1	8 1/2'	11:50	11:54	11:54	11:59	5 min
	2	8'	11:51	11:54	11:54	11:58	4 min
	3	8 1/2'	11:52	11:55	11:58	12:03	5 min
	4	3'	11:55	11:58	11:58	12:04	6 min

14  
4 in A'

SOIL AUGER FINDING \_\_\_\_\_  
 TESTED BY J. Wright  
 REMARKS \_\_\_\_\_