



534° 26' 46" W - 127.85'

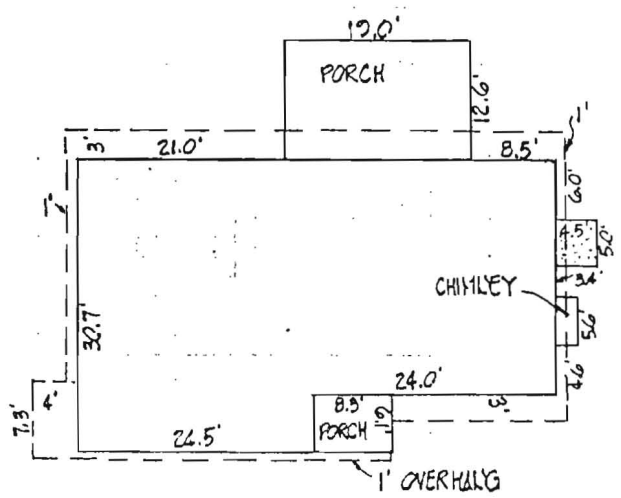

HOUSE DETAIL
SCALE: 1" = 20'

4/21/03 JAB
Garage ~~loc.~~ loc. ok
B00141010

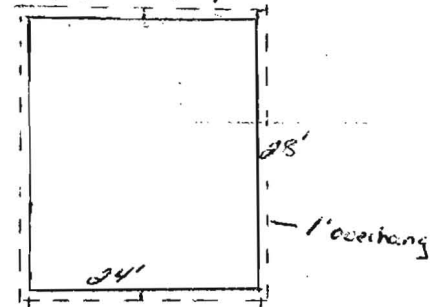

Garage Detail
1" = 20'

HOUSE LOCATION
16304 CARR'S MILL ROAD
FOURTH ELECTION DISTRICT
HOWARD COUNTY, MD.
SCALE: 1" = 100'



882.82'

863.81'

2.525 Ac.

557° 50' 09" E

157° 36' 37" W

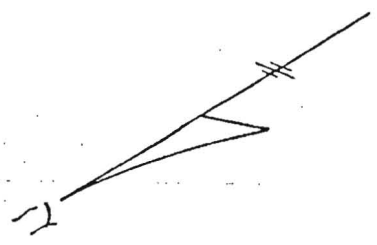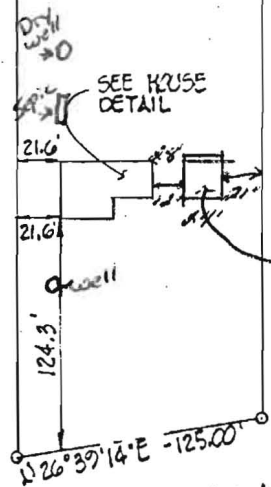

I HEREBY CERTIFY THIS HOUSE LOCATION TO BE CORRECT AS SHOWN AND THAT IT IS NOT INTENDED TO BE USED TO ESTABLISH PROPERTY LINES.



PREPARED BY:
DITMAN - CHEIM & ASSOC.
3007 PARK AVE.
ELLCOTT CITY, MD.

CARR'S MILL RD.