

B 1 6472

SEQUENCE NO. (MDE USE ONLY)

STATE OF MARYLAND PERMIT TO DRILL WELL

STATE PERMIT NUMBER

Ho - 94 - 2869

W514601 please print or type

Date Received (APA)

10/18/00

OWNER INFORMATION

Winston Edward, 7331 Rocky Creek Drive, Columbia MD 21046

B 3 LOCATION OF WELL


Howard County, Beauport Park, Section 44, Lot 3, Fulton

MILES FROM TOWN (enter 0 if in town) 2.0

DRILLER INFORMATION

Paul M. Fabiszak, MWD399, G. Edgar Harr Sons' Corp, 12047 Falls Rd. Cockeysville 21030

B 4 DIRECTION OF WELL FROM TOWN (CIRCLE BOX)

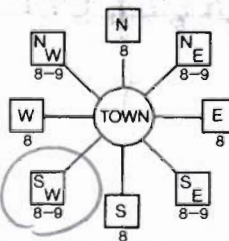

Blounts Lane, 260, 100

ON WHICH SIDE OF ROAD (CIRCLE APPROPRIATE BOX) WEST

TAX MAP: 45 BLK: PARCEL 26

B 2 WELL INFORMATION

APPROX. PUMPING RATE 5 GAL. PER MIN., AVERAGE DAILY QUANTITY NEEDED 750 GAL. PER DAY

USE FOR WATER (CIRCLE APPROPRIATE BOX)

- Domestic Potable Supply & Residential Irrigation (D), Farming (F), Industrial (I), Public Water Supply Well (P), Test (T), Geo-Thermal (G)

Permit EXPIRED, Tag returned + destroyed

APPROXIMATE DEPTH OF WELL 250 FEET, APPROXIMATE DIAMETER OF WELL 6 INCH

METHOD OF DRILLING (circle one)

AIR-ROTary, AIR-PERcussion, CABLE, Reverse-ROTary, Drive-POINT

REPLACEMENT OR DEEPEMED WELLS (CIRCLE APPROPRIATE BOX)

- THIS WELL WILL NOT REPLACE AN EXISTING WELL (N), THIS WELL WILL REPLACE A WELL THAT WILL BE ABANDONED AND SEALED (Y), THIS WELL WILL REPLACE A WELL THAT WILL BE USED AS A STANDBY-CONTACT LOCAL APPROVING AUTHORITY FOR POLICY ON STANDBY WELLS (S), THIS WELL WILL DEEPEM AN EXISTING WELL (D)

Not to be filled in by driller (MDE OR COUNTY USE ONLY)

APPROX. PERMIT NUMBER HD 74 - G 008, PERMIT No. Ho - 94 - 2869


SPECIAL CONDITIONS

NOTE - APPROVING AUTHORITIES SHOULD USE SEPARATE SHEET IF NEEDED -

NOT TO BE FILLED IN BY DRILLER HEALTH DEPARTMENT APPROVAL

HOWARD 458576-A, COUNTY NAME, COUNTY NO., STATE SIGNATURE, DATE ISSUED 1/26/01, CO SIGNATURE, EXP. DATE 1/26/02, NORTH GRID 474, EAST GRID 0815

SHOW MAJOR FEATURES OF BOX & LOCATE WELL WITH AN X, SOURCES OF DRILLING WATER 1. Well

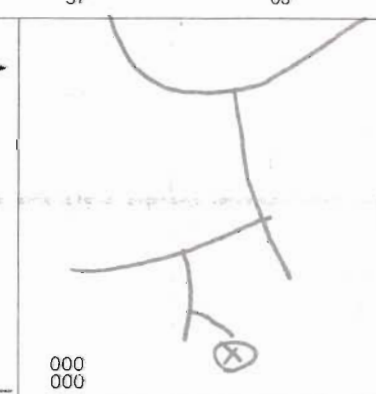

WRITE THE BOX NUMBER FROM THE MAP HERE

E 815, N 470

DRAW A SKETCH BELOW SHOWING LOCATION OF WELL IN RELATION TO NEARBY TOWNS AND ROADS AND GIVE DISTANCE FROM WELL TO NEAREST ROAD JUNCTION

