

# APPLICATION

A \_\_\_\_\_  
P \_\_\_\_\_

## SEWAGE DISPOSAL TESTING

STATE OF MARYLAND - DEPARTMENT OF HEALTH AND MENTAL HYGIENE

HOWARD COUNTY HEALTH DEPARTMENT  
ENVIRONMENTAL HEALTH SERVICES  
P. O. BOX 479, ELLICOTT CITY, MARYLAND 21042  
TELEPHONE: 410-5866, EXT. 388

DISTRICT 285 4th  
DATE 9/16/73

TO: THE COUNTY HEALTH OFFICER  
ELLICOTT CITY, MARYLAND

I, HEREBY, APPLY FOR THE NECESSARY TEST IN ORDER TO CONSTRUCT (OR RECONSTRUCT) A SEWAGE DISPOSAL SYSTEM.

PROPERTY OWNED Florence Farms, Inc.

ADDRESS Suite 200, Md. National Center, Rockville 20850 PHONE 424-8700

PROPERTY LOCATION:

SUBDIVISION \_\_\_\_\_ LOT NO. Parcel 5

ROAD AND DESCRIPTION Route 94

SIZE OF LOT 5.811 acres TYPE BLDG. 3 or 4 bedrooms  
NUMBER OF BEDROOMS

IF NOT SINGLE RESIDENCE DESCRIBE \_\_\_\_\_

THE SYSTEM INSTALLED UNDER THIS APPLICATION IS ACCEPTABLE ONLY UNTIL PUBLIC FACILITIES BECOME AVAILABLE.

SIGNATURE OF APPLICANT /s/ Harold Watkins


APPROVED BY \_\_\_\_\_ FOR \_\_\_\_\_ DATE \_\_\_\_\_  
(KIND OF SYSTEM)

REJECTED BY \_\_\_\_\_ FOR \_\_\_\_\_ DATE \_\_\_\_\_  
(KIND OF SYSTEM)

HOLD PENDING FURTHER TESTS \_\_\_\_\_ DATE \_\_\_\_\_

REASONS FOR REJECTION OR HOLDING \_\_\_\_\_

# THIS IS NOT A PERMIT

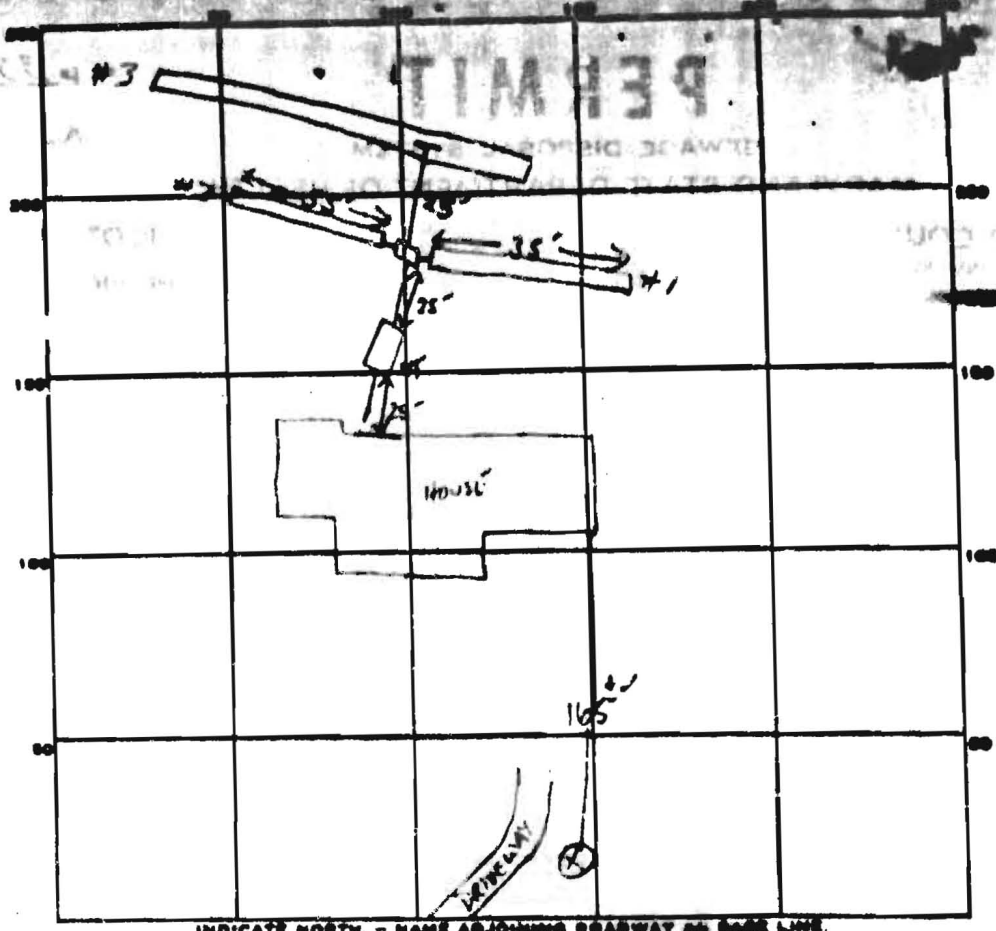

INDICATE NORTH - NAME ADJOINING ROADWAY ON BASE LINE.  
CABIN RUN Rd.

PERMIT CARD

SEPTIC TANK, LEVEL 12000 GAL

CLEANOUTS

DISTRIBUTION BOX, LEVEL

TILE FIELD, DEPTH 1 2 3 FT. TRENCH WIDTH 2 FT. JUNE 4

GRAVEL DEPTH 4 FT TOTAL LENGTH 35 55 90 FT. TOTAL 120'


NUMBER OF TRENCHES 3 ONE SIDE WALL TOTAL BOTTOM AREA 720

SEEPAGE PITS, INSIDE DIAMETER \_\_\_\_\_ FT. DEPTH BELOW INLET \_\_\_\_\_ FT.

ABSORBENT AREA 720 SQ. FT.

REMARKS 7-20-85 OK TO ADD SAND TO TRENCHES;  
8-30-85 OK TO COVER ALL WORK - NEED HOUSE CONNECTION -> CALL  
CALL YARD SALES  
7-86 House connection OK

720φ

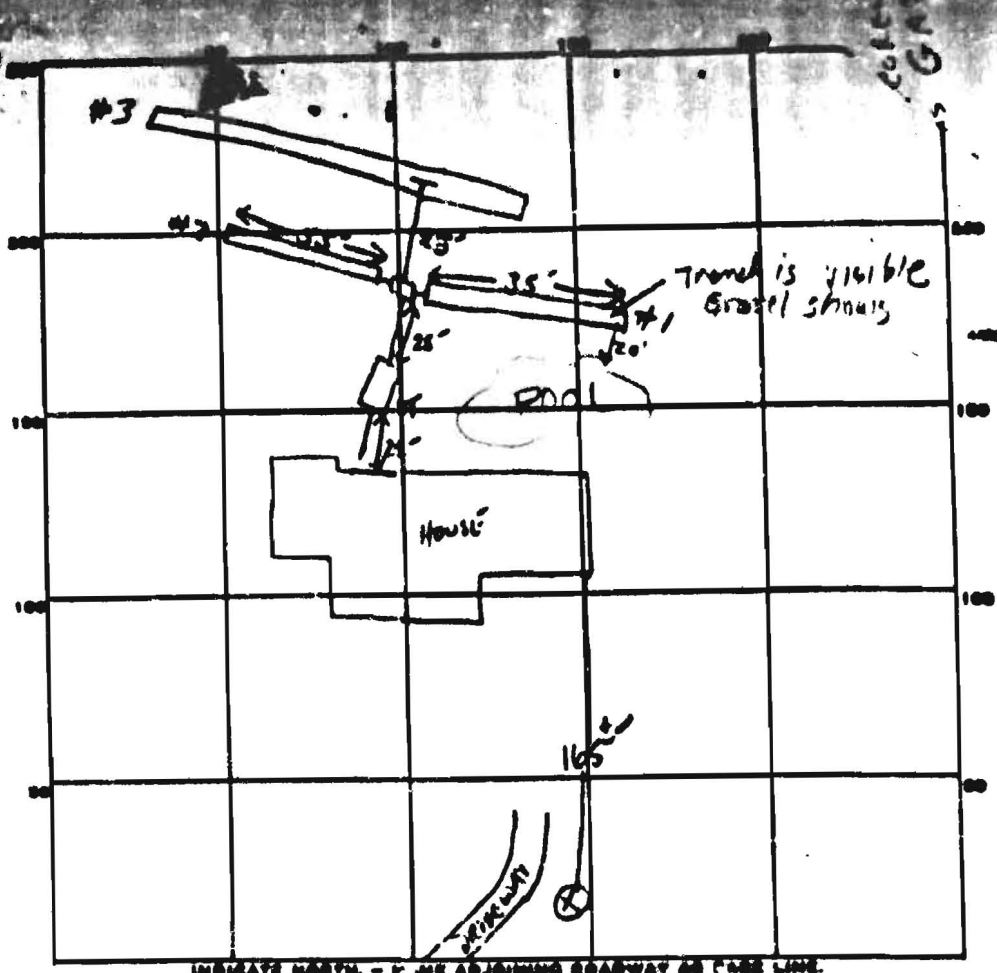

3 bedroom  
 3 bedroom  
 5 bedroom

Septic location  
 10/5/87

INDICATE NORTH - F.M.E. ADJOINING ROADWAY AS FACE LINE.  
 CABIN RUN Rd.

PERMIT CARD ✓

SEPTIC TANK, LEVEL ✓ 2000 GAL CLEANOUTS ✓ 1ST

DISTRIBUTION BOX, LEVEL ✓

TILE FIELD, DEPTH ① 8 ② 8 ③ 8 FT. TRENCH WIDTH 2 FT. INLET 4"

GRAVEL DEPTH 4ft OR TOTAL LENGTH ① 86 ② 55 ③ 90 FT. TOTAL 180"

NUMBER OF TRENCHES 3 ONE SIDE WALL TOTAL BOTTOM AREA 720φ

SEEPAGE PITS, INSIDE DIAMETER \_\_\_\_\_ FT. DEPTH BELOW INLET \_\_\_\_\_ FT.

ABSORBENT AREA 720 SQ. FT.


REMARKS 8-30-85 OK TO ADD STONE TO TRENCHES;

8-30-85 OK TO COVER H/L WORK - NEED HOUSE CONNECTION → CALL

WHEN READY SAULT

1-7-86 House connections OK

# APPLICATION

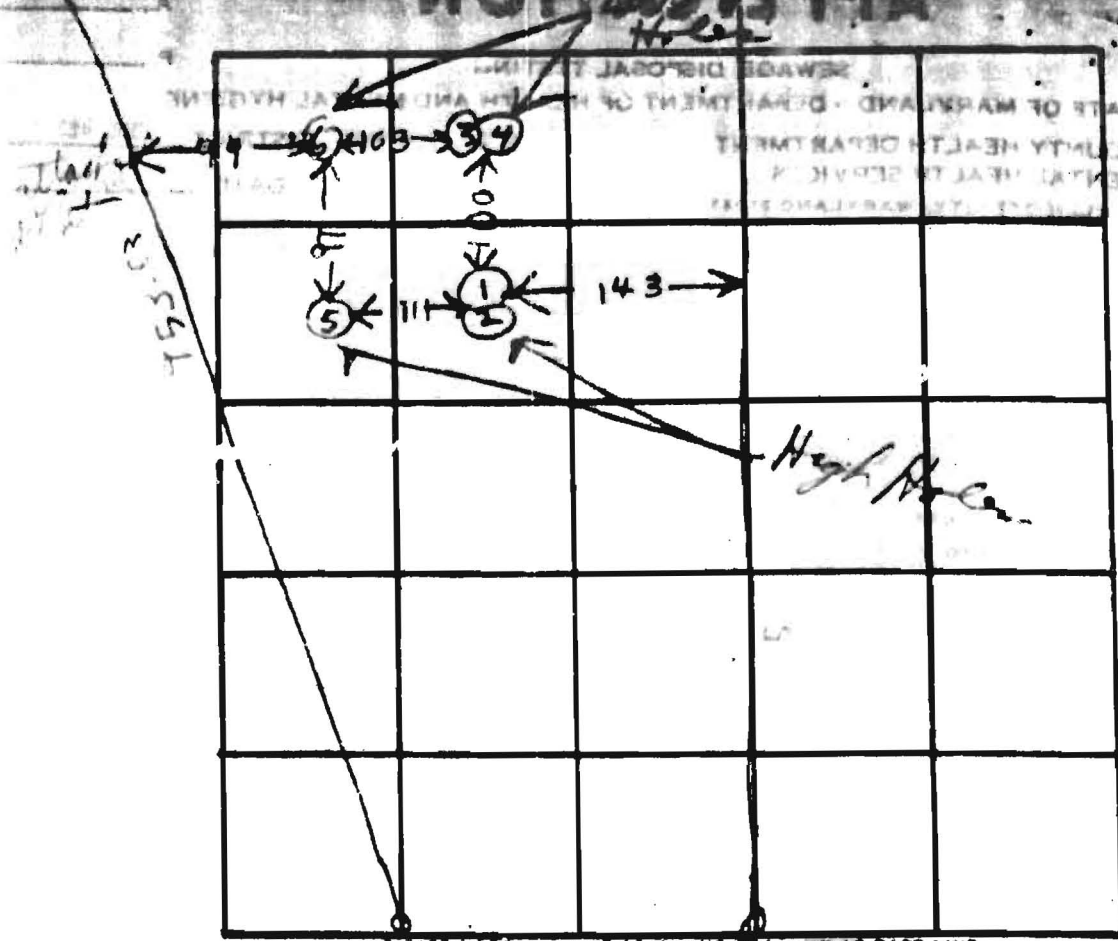

INDICATE NORTH - NAME ADJOINING ROADWAY AS BASE LINE

*P/W*

DATE	TEST NO.	DEPTH	PRE-WET		TEST - 1" DROP		TIME
			START	STOP	START	STOP	
9/25/73	1	11	329	334	339		11
9/25/73	2	5 1/2	329	337	337		13
" "	3	10 1/2	343	345	345		4
" "	4	5 1/2	343	353	430	430	7
9/26/73	5	10	TOP	31 FT	CLAY		DRY
" "	6	10	TOP	31 FT	CLAY		DRY
			BOT	7 FT	SAND & SHALE		

REMARKS \_\_\_\_\_

TYPE OF SOIL *CLAY* \_\_\_\_\_