

4/11/73

PERMIT

SEWAGE DISPOSAL SYSTEM

18236

18000

MARYLAND STATE DEPARTMENT OF HEALTH

HOWARD COUNTY

ELLICOTT CITY

DISTRICT 9th

INDEXED

DATE 3/3/73

Jack Fyock

IS PERMITTED TO INSTALL ALTER

ADDRESS Fox Oaks Road, Clarks, Maryland

PHONE 286-8929

A SEWAGE DISPOSAL SYSTEM LOCATED AT

SUBDIVISION (Over)

ROAD Ball Shop Road

LOT 3

PROPERTY OWNER Mr. & Mrs. James Stawinski and Herbert J. Lawrence

ADDRESS Ball Shop Road, Fulton, Maryland 20799

SPECIFICATIONS 3 bedrooms

DRAIN FIELD DEPTH FEET, BOTTOM AREA SQ. FT.

SEEPAGE PITS ABSORBENT SIDE-WALL AREA SQ. FT.

SEPTIC TANK CAPACITY 1000 GALLONS

FOR GARBAGE GRINDER, INCREASE DISPOSAL AREA 25% & TANK CAPACITY 20%.

OTHER DRY WELL - 300 sq. ft. absorbent sidewall area to begin below the inlet, minimum depth permitted for dry well is 4 ft. below original grade. Dig dry well 30 ft. from right side line and 20 ft. from rear property line to back from Ball Shop Road.

NOTE: ALL PIPE FROM HOUSE TO SEPTIC TANK MUST BE CAST IRON.

PERMIT VOID AFTER THREE YEARS.

NOTE: INSTALL STAND PIPE ON SEPTIC TANK AND DRY WELL.

PLANS APPROVED BY Robert V. Turve

DATE 6/7/72


FILL SEPTIC TANK AND DISTRIBUTION BOX WITH WATER BEFORE CALLING FOR AN INSPECTION. COVER NO WORK UNTIL INSPECTED AND APPROVED.

NEITHER THE HOWARD COUNTY COMMISSIONERS NOR THE HEALTH DEPARTMENT IS RESPONSIBLE FOR THE SUCCESSFUL OPERATION OF ANY SYSTEM.

A 1111

PERMIT

SEWAGE DISPOSAL SYSTEM
MARYLAND STATE DEPARTMENT OF HEALTH

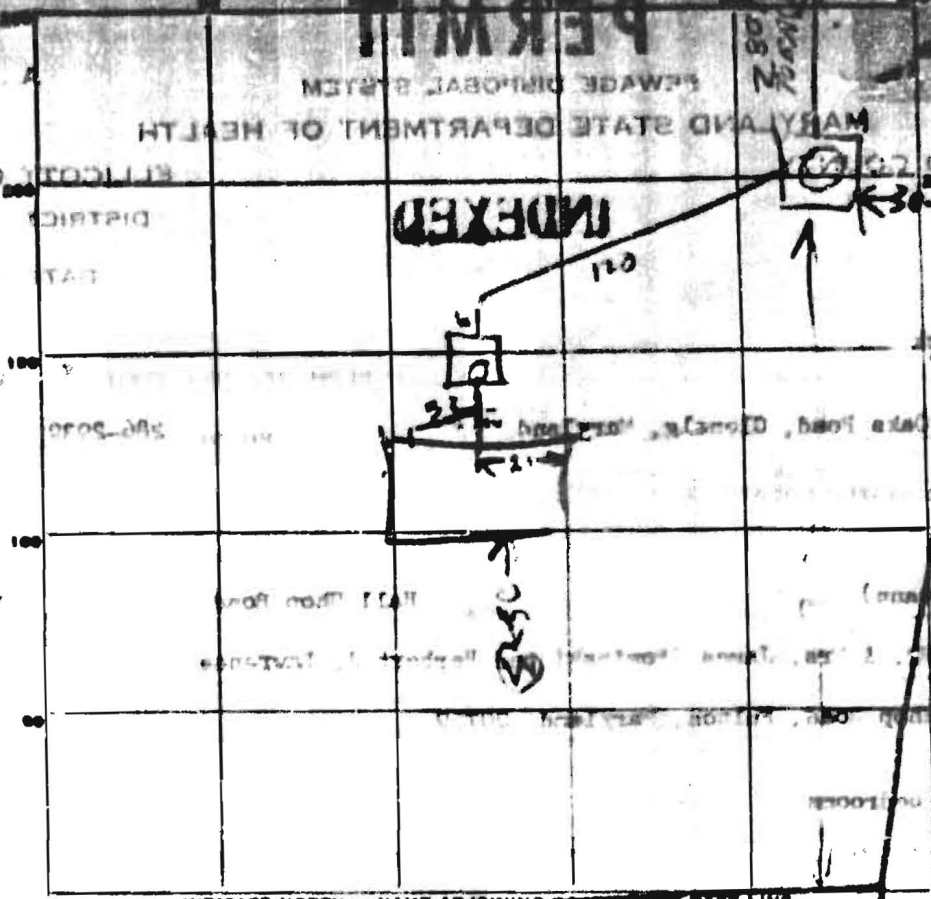

PERMIT CARD _____

SEPTIC TANK, LEVEL OK 1200 CLEANOUTS OK

DISTRIBUTION BOX, LEVEL 3' 8" below inlet

TILE FIELD, DEPTH _____ FT. TRENCH WIDTH _____ FT.

GRAVEL DEPTH _____ IN. TOTAL LENGTH _____ FT.

NUMBER OF TRENCHES _____ TOTAL BOTTOM AREA _____


SEEPAGE PITS, INSIDE DIAMETER 9 FT. DEPTH BELOW INLET 9 FT.

ABSORBENT AREA 276 SQ. FT.

REMARKS 41-1 below ground

Permit 449A

DATE SYSTEM APPROVED 4/11/73 INSPECTOR Raymond Hodge

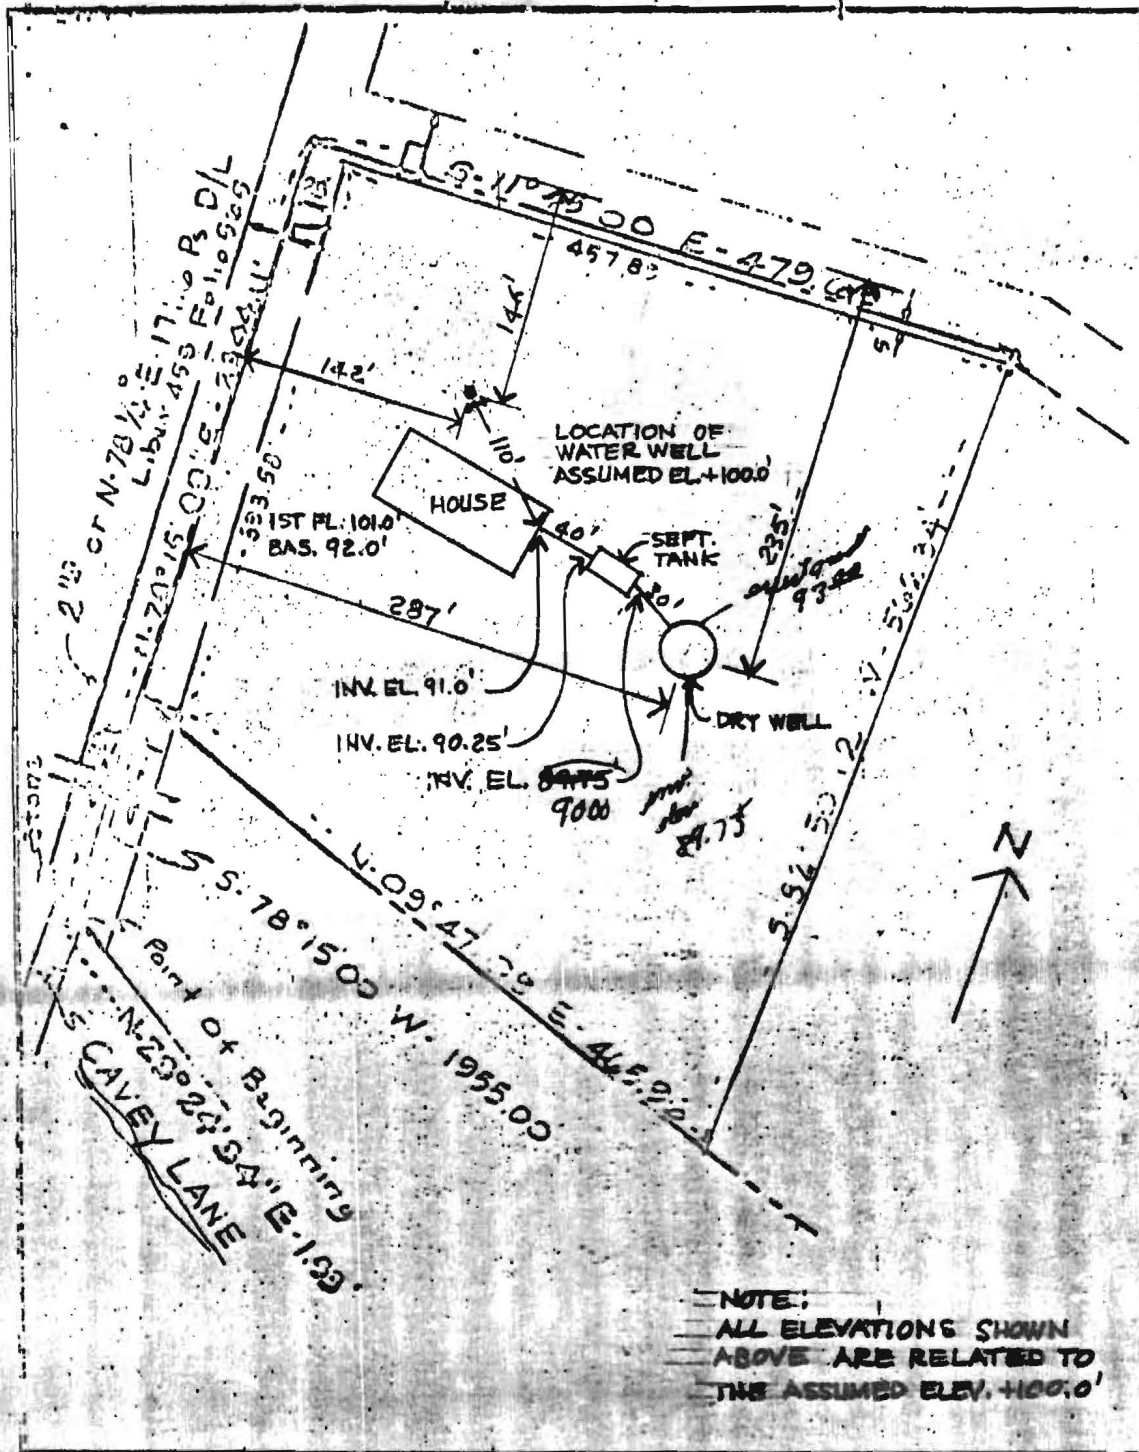

I CERTIFY THE ABOVE MEASUREMENTS AND ELEVATIONS ARE ACTUAL & CORRECT FOR THIS PROPERTY.

SIGNED: Paul Lewis
144-7479