

4-19'
Lined on
10,000 ft.

712/574
APPLICATION

Castillo Bldg.
A 23485

Recorded

SEWAGE DISPOSAL TESTING
STATE OF MARYLAND - DEPARTMENT OF HEALTH AND MENTAL HYGIENE

HOWARD COUNTY HEALTH DEPARTMENT DISTRICT 3
ENVIRONMENTAL HEALTH SERVICES
P. O. BOX 476, ELLICOTT CITY, MARYLAND 21043
TELEPHONE: 462-9600, EXT. 356
DATE 6/23/76

6/24/76
6/25/76
9:30
Locate the dry well 25' from the front property (center of Carey Lane) and 20' from the left gutterline as seen from Carey Lane. The air will enter the D.W. @ 3' below O.G. and the max depth of the D.W. will not exceed 10'. There will be no less than 144 sq ft of sidewalk area per bedroom in the 2nd. R.N. 10/4/76

TO: THE COUNTY HEALTH OFFICER
ELLICOTT CITY, MARYLAND

I, HEREBY, APPLY FOR THE NECESSARY TEST IN ORDER TO CONSTRUCT (OR RECONSTRUCT) A SEWAGE DISPOSAL SYSTEM.

30 PROPERTY OWNER Jack Fisher Joseph M. Di Martin
ADDRESS 603 Woodlura Way, Balt. PHONE 788-2676
21228

PROPERTY LOCATION:
SUBDIVISION (former Schenck property) LOT NO. 28 Row Lot 3-A
ROAD AND DESCRIPTION 10337 Carey Lane

SIZE OF LOT 4.970 ACRES TYPE BLDG. 3 (A)
IF NOT SINGLE RESIDENCE DESCRIBE _____ NUMBER OF ROOMS (Single Fmly. DfHo.)


THE SYSTEM INSTALLED UNDER THIS APPLICATION IS ACCEPTABLE ONLY UNTIL PUBLIC FACILITIES BECOME AVAILABLE.

SIGNATURE OF APPLICANT Jack Fisher
APPROVED BY [Signature] FOR Don Nell DATE 12/11/76
REJECTED BY _____ FOR _____ DATE _____
HOLD PENDING FURTHER TESTS _____ DATE _____

REASONS FOR REJECTION OR HOLDING _____
BLDG PERMIT SIGNED AND RETURNED 11/20/78
serial # 36704

THIS IS NOT A PERMIT

Lot 10

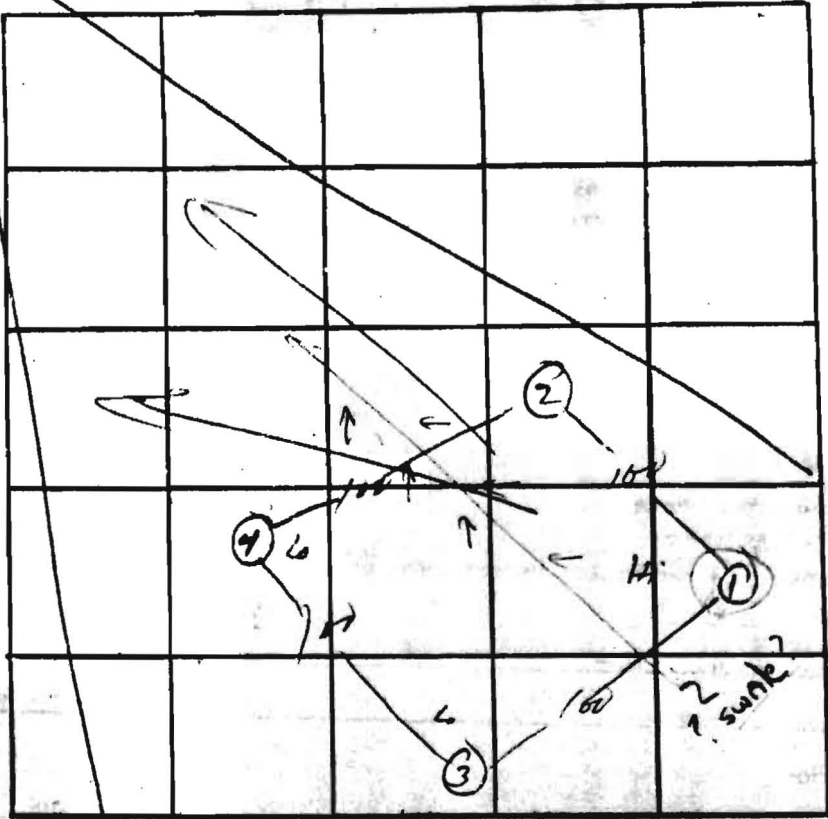

①
0
13
cont
rocks in
K 4 raised
up sandy loam
②
③

INDICATE NORTH - NAME ADJOINING BORDERS AS CASE LAW

Banyon. see next page for better detail

DATE	TEST NO.	DEPTH	PRE-WET		TEST - 1" DROP		TIME
			START	STOP	START	STOP	
8/25/73	1	3	2 ¹¹	2 ¹⁴	2 ¹⁴	2 ²⁰	6
	1A	13	2 ¹¹	2 ¹⁴	2 ¹⁴	2 ²¹	10
	2	13	vis		dry		
	3	5	2 ²¹	2 ²³	2 ²³	2 ²⁷	4
	3A	13	2 ²¹	2 ²²	2 ²²	2 ²⁷	4
	4	3	2 ²⁵	2 ²⁶	2 ²⁶	2 ³²	11
	4A	12.2	2 ²⁵	2 ²⁶	2 ²⁶	2 ³²	11

REMARKS _____

TYPE OF SOIL

TESTED BY ALSO PRESENT: _____