


S.5
16

10:09 10:15 10:25

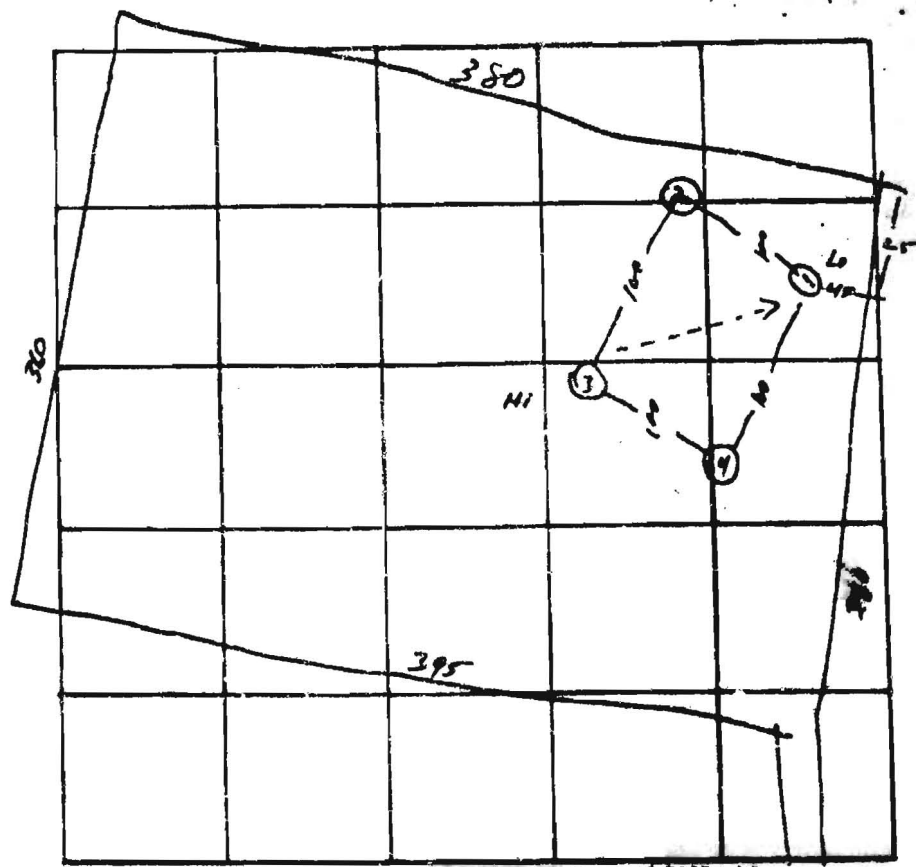

INDICATE NORTH - NAME ADJOINING ROADWAY AS BASE LINE

DATE	TEST NO.	DEPTH	PRE WET		TEST 1" DEEP		TIME
			START	STOP	START	STOP	
	1	6	11:02	11:12	11:13	11:17	04
	1A	14	11:02	11:13	11:19	11:22	13
	2	12 ⁰	11:12	11:13	11:23	11:22	12
	2A	5 ³	11:10	11:12	11:12	11:19	:06
	3	5	12:02	12:02	12:02	12:02	3
	3A	13	12:02	12:02	12:02	12:13	11
	4		vis				

REMARKS _____
 TYPE OF SOIL _____
 TESTED BY ALSO PRESENT: _____