

10/23/73  
Corrected out

11-6-77

# PERMIT

SEWAGE DISPOSAL SYSTEM

MARYLAND STATE DEPARTMENT OF HEALTH

HOWARD COUNTY

ELLICOTT CITY

INDEXED

DISTRICT 3

DATE 8/7/73

P. 18849

A 18795

James May IS PERMITTED TO INSTALL  ALTER

ADDRESS 2920 Route 32, West Friendship, Md. PHONE (489)-4565

A SEWAGE DISPOSAL SYSTEM LOCATED AT

SUBDIVISION ROAD 2920 Route 32 LOT (see application for directions)

PROPERTY OWNER James May and wife

ADDRESS

SPECIFICATIONS - 4 bedrooms (existing house)

DRAIN FIELD DEPTH FEET, BOTTOM AREA SQ. FT.

SEEPAGE PITS ABSORBENT SIDE-WALL AREA SQ. FT.

SEPTIC TANK CAPACITY \*1,000 GALLONS

FOR GARBAGE GRINDER, INCREASE DISPOSAL AREA 22% & TANK CAPACITY 50%

OTHER for old system repair - trench 50 ft. long - 12 ft. deep - bucket width

6 ft. gravel under pipe, to begin at point 78 ft. to left of the front of house and run parallel with side of house.

\* New system - ditch same specs. as for repair ditch - to begin 38 ft. to left of garage and run towards back of lot.

\* CALL FOR INSPECTION OF TRENCHES BEFORE GRAVEL IS INSTALLED.

PLANS APPROVED BY *[Signature]* DATE 8/11/73

NOTE: ALL PIPE FROM HOUSE TO SEPTIC TANK MUST BE CAST IRON.


FILL SEPTIC TANK AND DISTRIBUTION BOX WITH WATER BEFORE CALLING FOR AN INSPECTION. COVER NO WORK UNTIL INSPECTED AND APPROVED.

NOTE: INSTALL STAND PIPE ON SEPTIC TANK. PERMIT VOID AFTER THREE YEARS.

NEITHER THE HOWARD COUNTY COMMISSIONERS NOR THE HEALTH DEPARTMENT IS RESPONSIBLE FOR THE SUCCESSFUL OPERATION OF ANY SYSTEM.

A 18795

INSPECTOR APPROVED

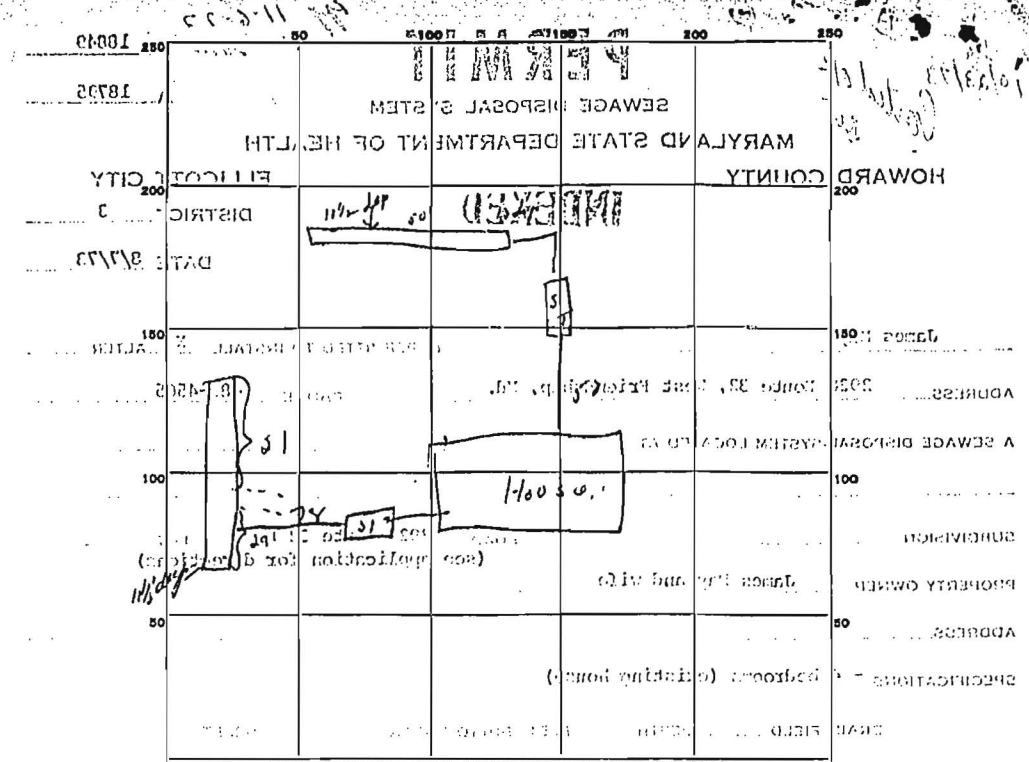

INDICATE NORTH - NAME ADJOINING ROADWAY AS BASE LINE.

PERMIT CARD NP

SEPTIC TANK, LEVEL OK CLEANOUTS OK

DISTRIBUTION BOX, LEVEL OK

TILE FIELD, DEPTH 116 1/2 FT. TRENCH WIDTH 2 FT.

GRAVEL DEPTH 6.58 IN. TOTAL LENGTH 100 FT.

NUMBER OF TRENCHES 2 TOTAL BOTTOM AREA 2.00 SQ. FT.

SEEPAGE PITS, INSIDE DIAMETER 30 IN. DEPTH BELOW INLET 2 FT.

ABSORBENT AREA 400 SQ. FT.

REMARKS 10-23-73 - OK to put gravel in trenches. D.M.

11/6/73

DATE SYSTEM APPROVED 11/6/73 INSPECTOR W. J. [Signature]