

APPLICATION

SEWAGE DISPOSAL TESTING

A 14102

P

MARYLAND STATE DEPARTMENT OF HEALTH

HOWARD COUNTY *Septic Tank - 4 bedrooms - 1250 gal* ELLICOTT CITY

3

DISTRICT 3

Dry well - 108 sq ft. absorbent sidewalk area per bedroom DATE 11/15/68

to be dug 3 1/2' below original grade. maximum depth permitted for dry well is 9 ft. below original grade. Locate dry well 21 ft off rear property line and 75 ft off left side line as seen from Triadelphia Rd.

TO: THE COUNTY HEALTH OFFICER
ELLICOTT CITY, MARYLAND

I, HEREBY, APPLY FOR THE NECESSARY TESTS IN ORDER TO CONSTRUCT (OR RECONSTRUCT) A SEWAGE DISPOSAL SYSTEM.

PROPERTY OWNER Carl C. Hall

ADDRESS Chatham Road - Ellicott City, Md. PHONE HO 5-1635

PROPERTY LOCATION:

SUBDIVISION Benson LOT NO. 1, Blk. B, Sec. 1

ROAD AND DESCRIPTION Triadelphia Rd. and ?

OCCUPANT _____ PHONE _____

PERSON TO CONSTRUCT SYSTEM _____

ADDRESS _____ PHONE _____

SIZE OF LOT 148' x 25' x 152' x 281' x 210' TYPE BLDG. 3 or 4
NUMBER OF BEDROOMS

IF NOT SINGLE RESIDENCE DESCRIBE _____

SIGNATURE OF APPLICANT /s/ Carl C. Hall


APPROVED BY James T. Wright FOR Dry well DATE 11/15/71
(KIND OF SYSTEM)

REJECTED BY _____ FOR _____ DATE _____
(KIND OF SYSTEM)

HOLD PENDING FURTHER TESTS _____ DATE _____

REASONS FOR REJECTION OR HOLDING _____

THIS IS NOT A PERMIT

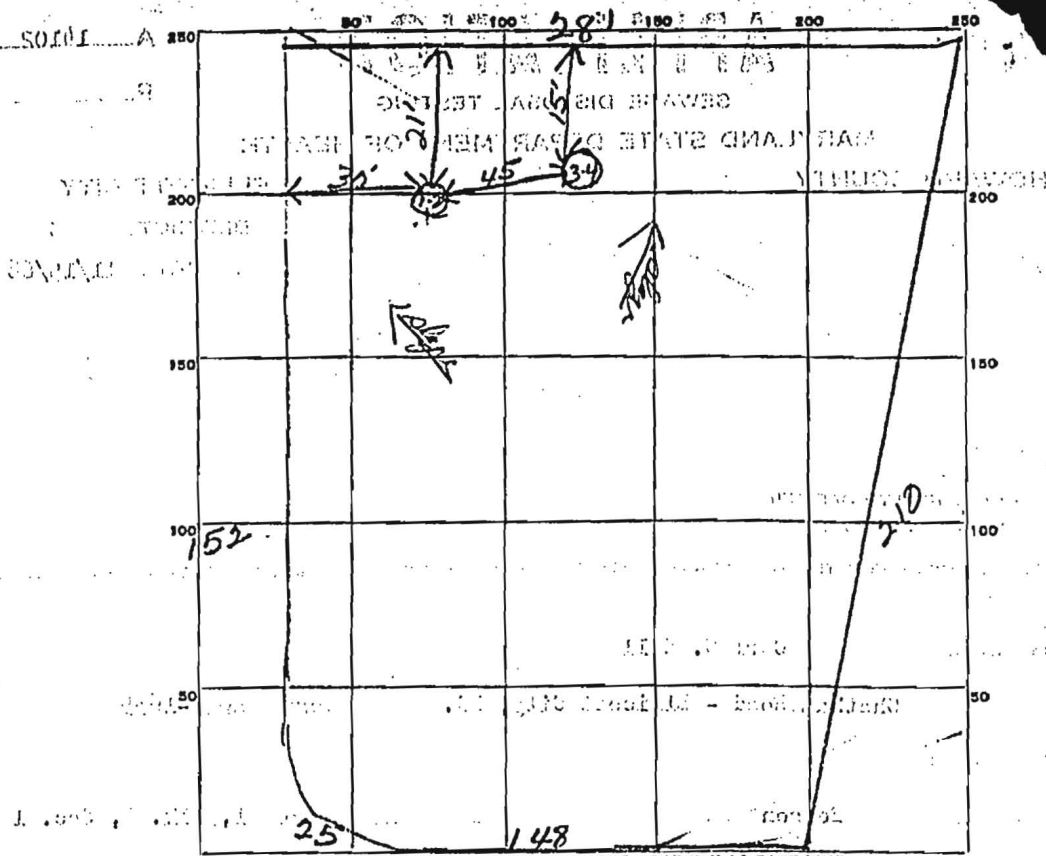

INDICATE NORTH - NAME ADJOINING ROADWAY AS BASE LINE.

Tridelphia Rd

B=1

DATE	TEST NO.	DEPTH	PRE-WET		TEST - 1" DROP		TIME
			START	STOP	START	STOP	
4/8/69	1	9'	10 ⁰⁰	10 ⁰³	10 ⁰³	10 ⁰⁶	3 min
	2	4'	10 ⁰³	10 ⁰⁶	10 ⁰⁶	10 ²¹	15 min
	3	9'	10 ⁰⁸	10 ¹¹	10 ¹¹	10 ¹⁴	3 min
	4	4'	10 ⁰⁹	10 ¹⁴	10 ¹⁴	10 ²⁵	11 min

avg.
9 min
use h/c 3d4

SOIL AUGER FINDING _____
 TESTED BY *STW* _____
 REMARKS _____

STATION A TOM 21 2111