

APPLICATION

SEWAGE DISPOSAL TESTING

MARYLAND STATE DEPARTMENT OF HEALTH

HOWARD COUNTY

A 13397

P _____

ELLICOTT CITY

DISTRICT 3

DATE 12-8-67

TO: THE COUNTY HEALTH OFFICER
ELLICOTT CITY, MARYLAND

I, HEREBY, APPLY FOR THE NECESSARY TESTS IN ORDER TO CONSTRUCT OR RECONSTRUCT A SEWAGE DISPOSAL SYSTEM.

PROPERTY OWNER JAMES V. King, Sr.

ADDRESS 304 Enochson Rd., Simpsonville PHONE 286-2387

PROPERTY LOCATION

SUBDIVISION Kington LOT NO. 13

ROAD AND DESCRIPTION Trindolphia Rd. 4

Glenalg, Maryland

OCCUPANT _____ PHONE _____

PERSON TO CONSTRUCT SYSTEM _____

ADDRESS _____ PHONE _____

SIZE OF LOT 1 Acre (312' x 140') TYPE BLDG 3

IF NOT SINGLE RESIDENCE DESCRIBE _____

SIGNATURE OF APPLICANT JAMES V. King, Sr., /s/

APPROVED BY _____ FOR _____ DATE _____

REJECTED BY _____ FOR _____ DATE _____

HOLD PENDING FURTHER TESTS _____ DATE _____

REASONS FOR REJECTION OR HOLDING _____

THIS IS NOT A PERMIT


WILLIAMFIELD DRIVE

● Denotes location of Field Percolation tests

See insp. drawing for orientation OK for Septic System. D/00 8/29/75

Match Perc Notes?

PLOT PLAN TO ACCOMPANY BUILDING PERMIT APPLICATION
KINGSTON
 SECTION 11.3
 SELECTION DISTRICT HOWARD CO
 AUGUST 1, 1975
 SCALE

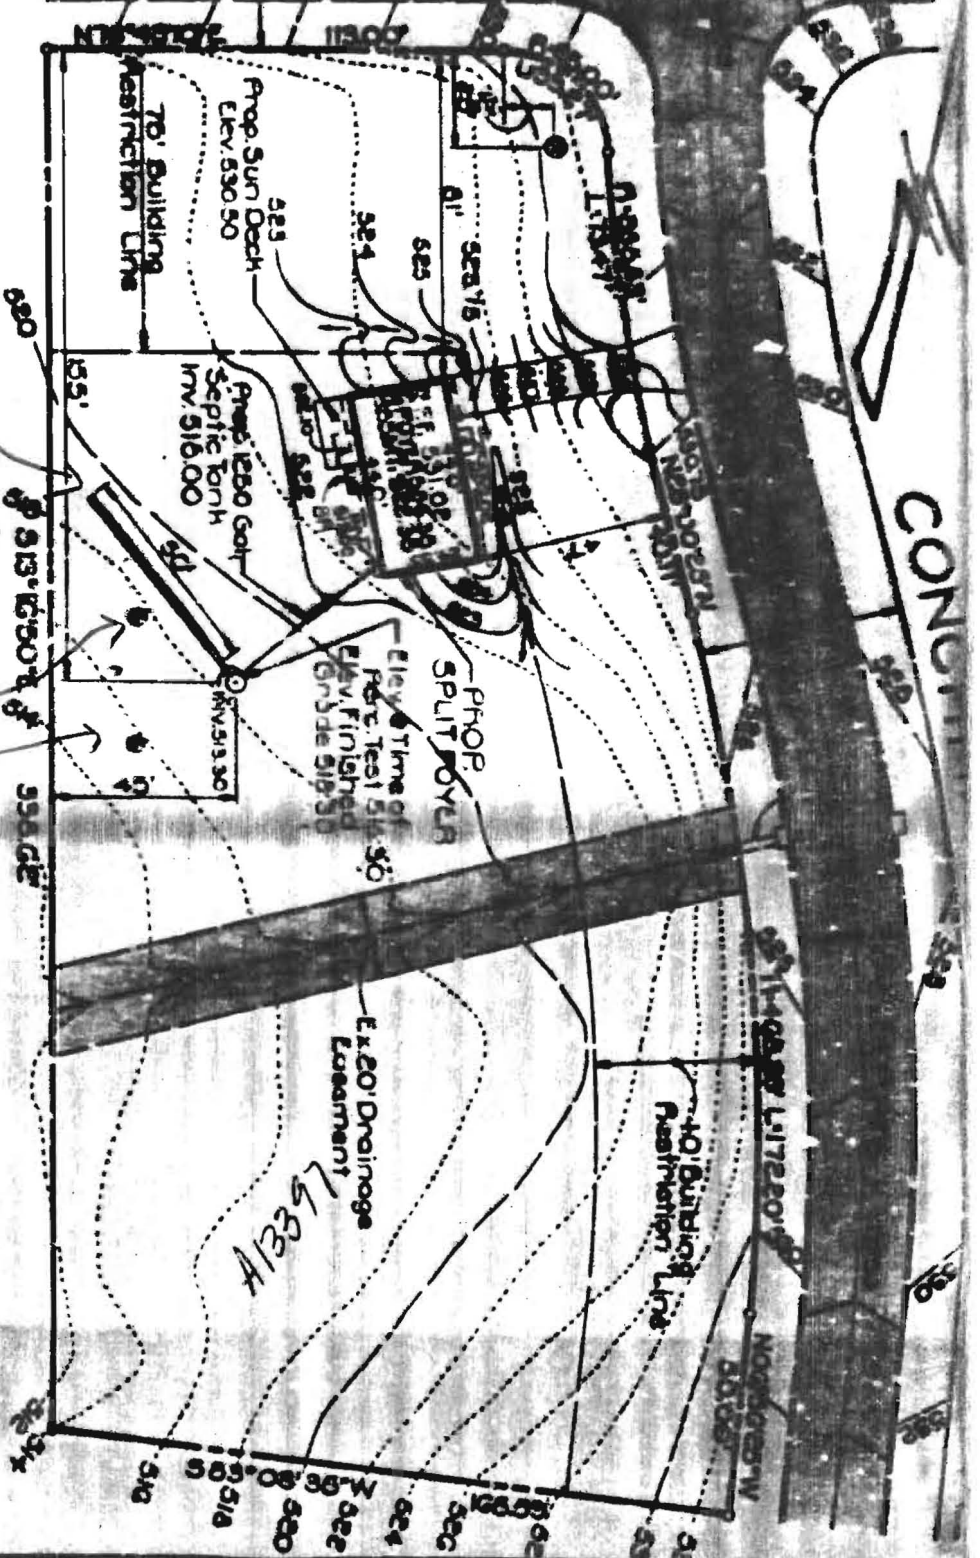

CONCRETE