

A 07831

THIS REPORT
MUST BE SUBMITTED
WITHIN 30 DAYS
AFTER COMPLETION
OF THE WELL

WELL COMPLETION REPORT *Howard County*

WELL DESCRIPTION

WELL LOG
State the kind of formations penetrated, their color, their depth, their thickness, and if water-bearing

CASING AND SCREEN RECORD
State the kind and size and position of casing, line, shoe, screen, and other accessories (if no casing used, give diameter of well).

	FEET	
	from	to
<i>Topsoil/Clay</i>	<i>0-5</i>	
<i>Clay/Sand</i>	<i>5-30</i>	
<i>Mica Sh. ST</i>	<i>35-60</i>	

	DIAM.	FEET
	(inches)	
<i>Black Steel</i>	<i>5 7/8</i>	<i>0-90</i>

Well No. *66-W-10*
Order _____
Address _____
Subdivision _____
Section _____ Lot _____

PUMPING TEST
Hours Pumped _____
Type of Pump Used _____
Pumping Rate _____
Gallons per Minute _____

WATER LEVEL
Distance from land surface to water:
Before Pumping _____
When Pumping _____

APPEARANCE OF WATER
Clear _____ Cloudy _____
Taste _____
Odor _____

Height of Casing Above Land Surface _____
PUMP INSTALLED
Type _____
Capacity _____
Gallons per Minute _____
Gallons per Hour _____
Pump Column Length _____

LOCATION OF WELL ON LOT
Show permanent structures such as building(s), septic tank, and/or other landmarks and indicate not less than 2 distances (measurements) to well.



66-W-10

Date Well Was Completed *10/11/65*


Well Driller *Frederick H. H. H.*
Signature *Frederick H. H. H.*

DRILLER

PROPERTY KNOWN AS: Lot 0
 MAP OF SECTION 3
 "HIGHLAND ACRES"
 5th ELECTION DISTRICT
 HOWARD COUNTY, MD

THIS PLAT CAN NOT BE USED TO ESTABLISH
 PROPERTY LINES OR CORNERS.

PLAT BOOK 9 F. 92

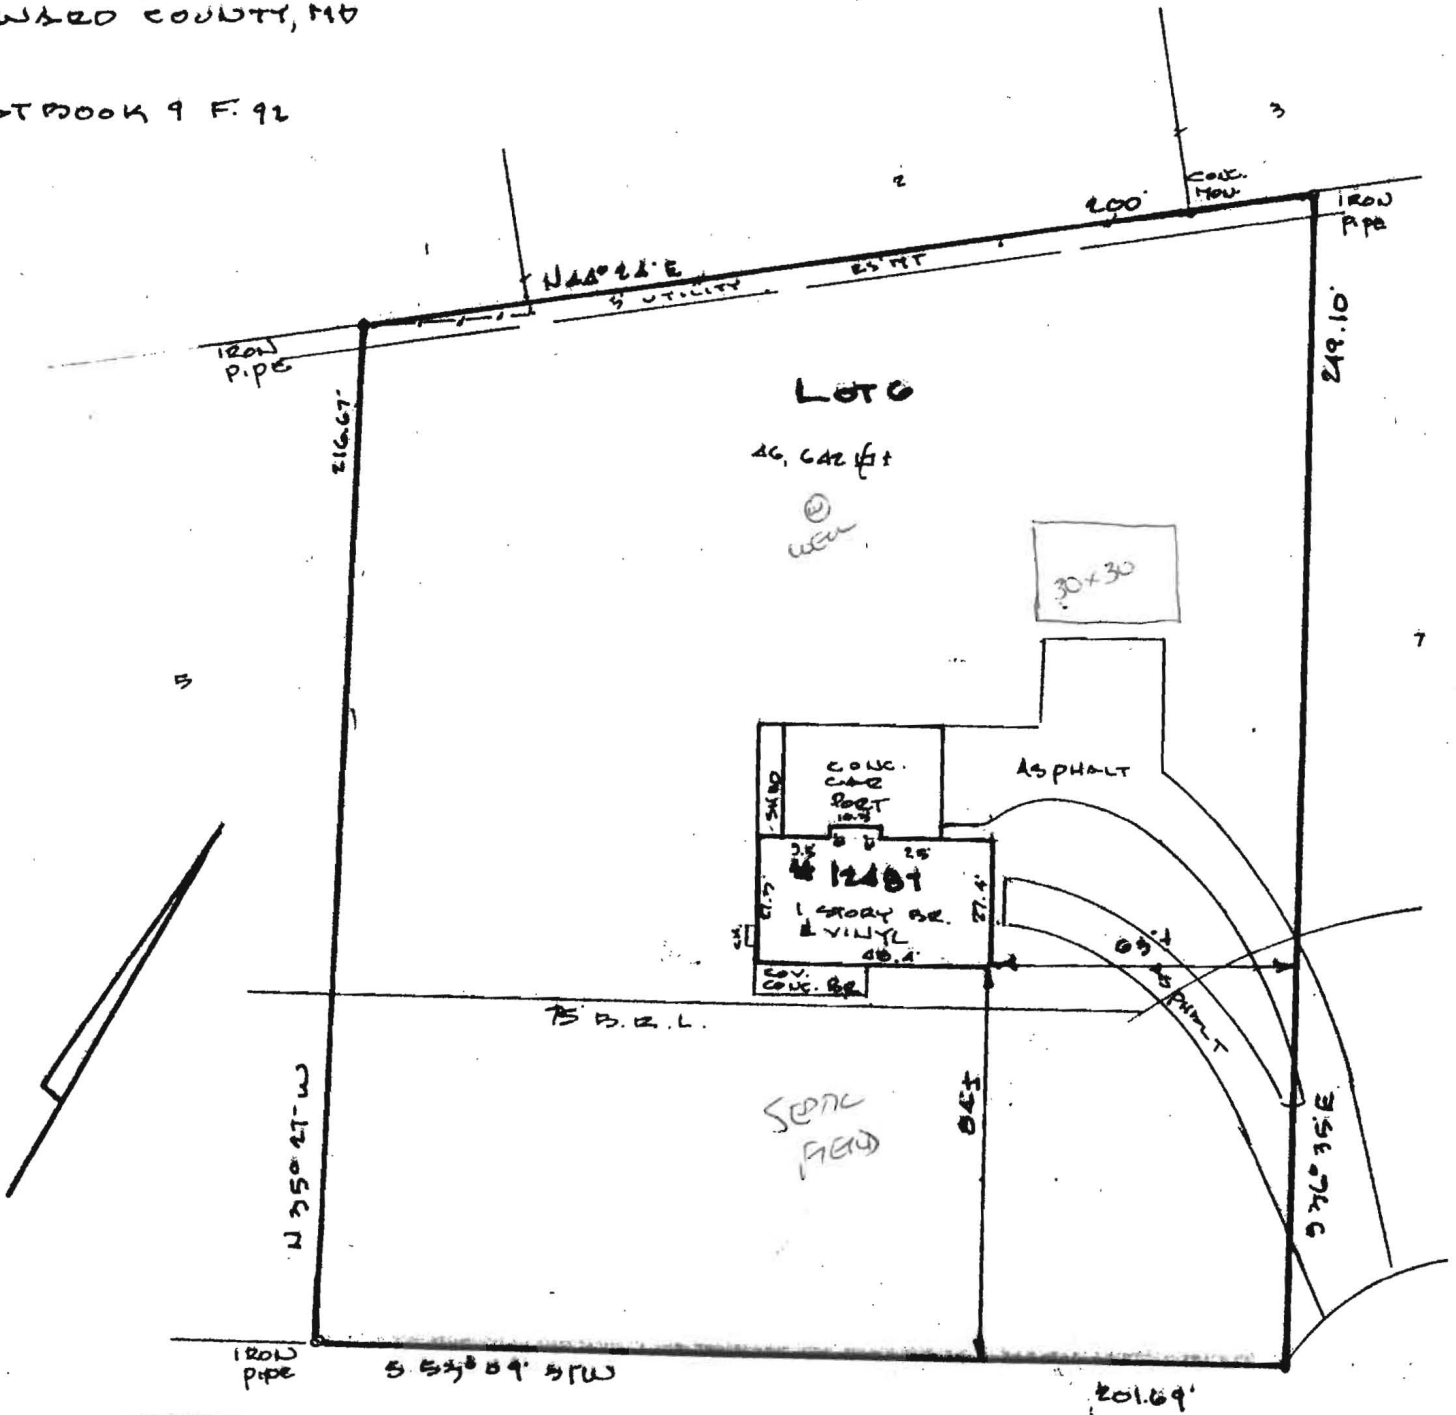

EAST NUGGET COURT
 50' HW



May 07, 2003

2003 MAY -8 PM 1:29

Howard County Health Department
3525 H Ellicott Mill Drive
Ellicott City, MD 21043

Dear Ms. Noonon:

As discussed on May 6, 2003, enclosed is the \$80 fee for keeping the existing well for outside water use at 12487 East Nugget Court, Highland, MD 20777. If you have any questions I can be reached at 301-902-1505(w) or 301-854-3993(h).

Thank you,

Melissa Frazier
Melissa Frazier



HOWARD COUNTY HEALTH DEPARTMENT

W5 18964

DATE
5 / 8 / 2003

Received From Melissa L Holtzman Frazier 301-854-3993

12487 East Nugget Ct, Highland MD 20777

For Well Permit

CASH
 CHECK
Same

NO. 4877 Eighty and 00/100 Dollars

\$ 80 | 00

Received By Mary L Brigg