

# APPLICATION

A 49402

10/18/02  
9:20

PERCOLATION TESTING  
per 7yok's request 10/18/02 2-46' trenches  
6-10' ← per KC  
4' stone  
2' wide

A 517933  
P \_\_\_\_\_  
DISTRICT 05  
DATE 9/25/02

HOWARD COUNTY HEALTH DEPARTMENT  
BUREAU OF ENVIRONMENTAL HEALTH  
3525-H ELLICOTT MILLS DRIVE/ELLICOTT CITY, MARYLAND 21043  
TELEPHONE: 313-2640

TO: THE COUNTY HEALTH OFFICER  
ELLICOTT CITY, MARYLAND

WANTS TO INSTALL 1,000 gal S.T.  
I HEREBY APPLY FOR THE NECESSARY TEST PRIOR TO APPLICATION FOR PERMIT TO CONSTRUCT (OR RECONSTRUCT) A SEWAGE DISPOSAL SYSTEM.

PROPERTY OWNER Peter C. and D. Susan Scheidt (Dr. + Mrs. Peter C. Scheidt)

ADDRESS 12730 Hall Shop Rd. PHONE 301-854-2439  
Highland, MD 20777

AGENT OR PROSPECTIVE BUYER N/A  
ADDRESS N/A PHONE N/A

PROPERTY LOCATION:

SUBDIVISION Paternal Gift Farm LOT NO. Existing Home  
ROAD AND DESCRIPTION Hall Shop Road

TAX MAP 4D PARCEL # 369 "R"

SIZE OF LOT 3.603 acres TYPE BLDG. Single Family  
(SINGLE FAMILY DWELLING OR COMMERCIAL)

THE SYSTEM INSTALLED UNDER THIS APPLICATION IS ACCEPTABLE ONLY UNTIL PUBLIC FACILITIES BECOME AVAILABLE. I FULLY UNDERSTAND THE FEE CONNECTED WITH THE FILING OF THIS PERC TEST APPLICATION IS NON-REFUNDABLE UNDER ANY CIRCUMSTANCES. I ALSO AGREE TO COMPLY WITH ALL M.O.S.H.A. REQUIREMENTS IN TESTING THIS LOT. D. Susan Scheidt  
(SIGNATURE OF APPLICANT)

APPROVED BY \_\_\_\_\_ FOR \_\_\_\_\_ DATE \_\_\_\_\_

DISAPPROVED BY \_\_\_\_\_ FOR \_\_\_\_\_ DATE \_\_\_\_\_

HOLD PENDING FURTHER TESTS \_\_\_\_\_

REASONS FOR REJECTION OR HOLDING \_\_\_\_\_

PERCOLATION TEST PLAT/PRELIMINARY PLAT - TITLE OR I.D. # \_\_\_\_\_ DATE \_\_\_\_\_

SITE DEVELOPMENT PLAN/FINAL PLAT - TITLE OR I.D. # \_\_\_\_\_ DATE \_\_\_\_\_

# THIS IS NOT A PERMIT

COUNTY #

SOIL PROFILE

0'


Strong Rd brn CL Lm

6'

Wk y brn tan Sand Massive Structure Trace fx

15 1/2'

(A)

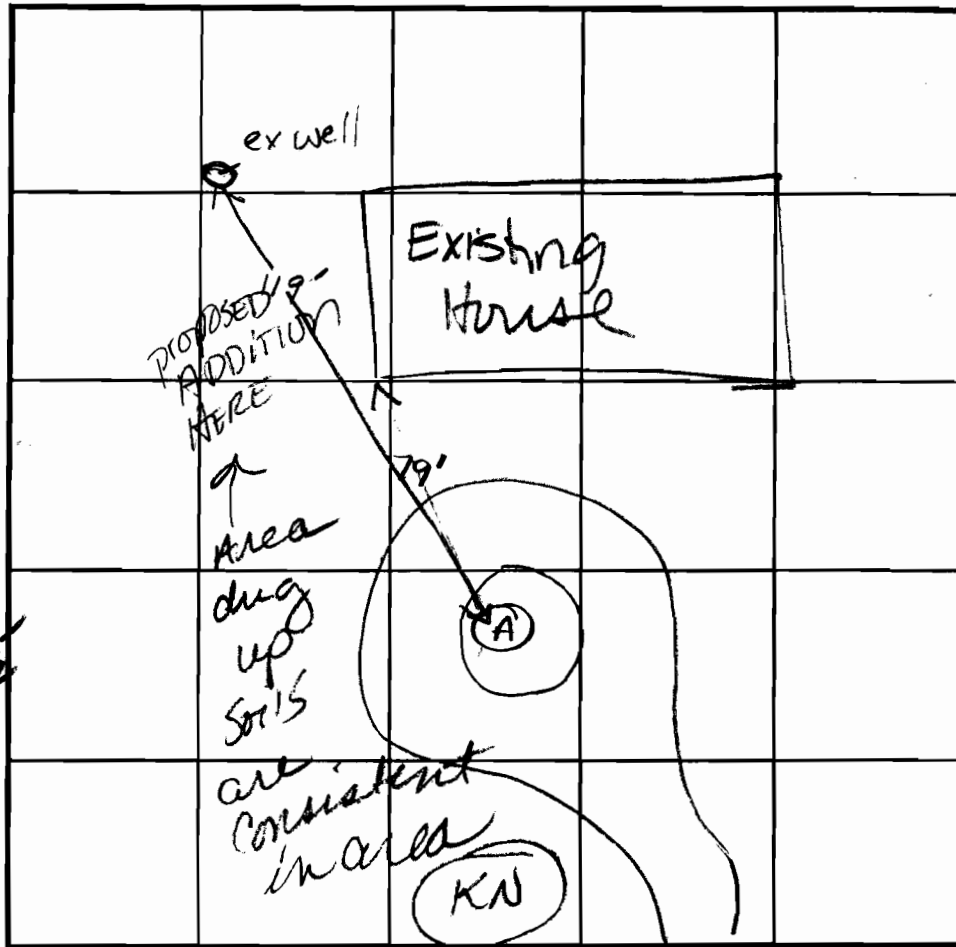

SOIL PROFILE

0'

INDICATE NORTH - NAME ADJOINING ROADWAY AS BASE LINE.

DATE	TEST NO.	DEPTH	PRE-WET		TEST - 1" DROP		TIME
			START	STOP	START	STOP	
10-18-02	(A)	6'	9:28:10	9:30:15	9:30:15	9:33:45	3 min

Only needs 1 trench but oversized to accommodate extra H<sub>2</sub>O usage for health / elder care necessities

REMARKS Soils consistent.

TYPE OF SOIL \_\_\_\_\_

TESTED BY Kaere ALSO PRESENT \_\_\_\_\_

TRENCH DESIGN DATA: AVERAGE PERCOLATION TIME 3 min TRENCH WIDTH \_\_\_\_\_

INLET DEPTH 0 MAXIMUM BOTTOM DEPTH 10 SQ. FT./BEDROOM 140'