

5/4/98
1500-4011C

APPLICATION

PERCOLATION TESTING

A 58576C

P _____

HOWARD COUNTY HEALTH DEPARTMENT
BUREAU OF ENVIRONMENTAL HEALTH
3525-H ELLICOTT MILLS DRIVE/ELLICOTT CITY, MARYLAND 21043
TELEPHONE: 343-2640

DISTRICT 5

DATE 7/23/97

TO: THE COUNTY HEALTH OFFICER
ELLICOTT CITY, MARYLAND

I HEREBY APPLY FOR THE NECESSARY TEST PRIOR TO APPLICATION FOR PERMIT TO CONSTRUCT (OR RECONSTRUCT) A SEWAGE DISPOSAL SYSTEM.

PROPERTY OWNER Christopher McGuinness

ADDRESS 9/0 E Winston 8528 Blounts Lane ELLICOTT MD 20759 PHONE 410-290-3870

AGENT OR PROSPECTIVE BUYER John Boender, Boender Inc

ADDRESS Po Box 267 W. Friendship Md 21784 PHONE 410 442 1280

PROPERTY LOCATION:

SUBDIVISION Adjoins Beaufort Pk 5001 LOT NO. _____

ROAD AND DESCRIPTION Blounts Lane Behind lot 473

TAX MAP 45 PARCEL # 53

SIZE OF LOT 1.3 Acre TYPE BLDG. SFD
(SINGLE FAMILY DWELLING OR COMMERCIAL)

THE SYSTEM INSTALLED UNDER THIS APPLICATION IS ACCEPTABLE ONLY UNTIL PUBLIC FACILITIES BECOME AVAILABLE. I FULLY UNDERSTAND THE FEE CONNECTED WITH THE FILING OF THIS PERC TEST APPLICATION IS NON-REFUNDABLE UNDER ANY CIRCUMSTANCES. I ALSO AGREE TO COMPLY WITH ALL M.O.S.H.A. REQUIREMENTS IN TESTING THIS LOT.

(SIGNATURE OF APPLICANT)

APPROVED BY _____ FOR _____ DATE _____

DISAPPROVED BY _____ FOR _____ DATE _____




HOLD PENDING FURTHER TESTS _____

REASONS FOR REJECTION OR HOLDING _____

PERCOLATION TEST PLAT/PRELIMINARY PLAT - TITLE OR I.D. # _____ DATE _____

SITE DEVELOPMENT PLAN/FINAL PLAT - TITLE OR I.D. # _____ DATE _____

THIS IS NOT A PERMIT

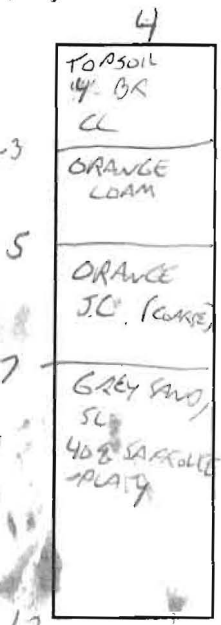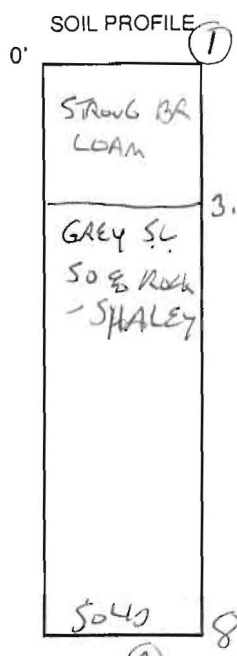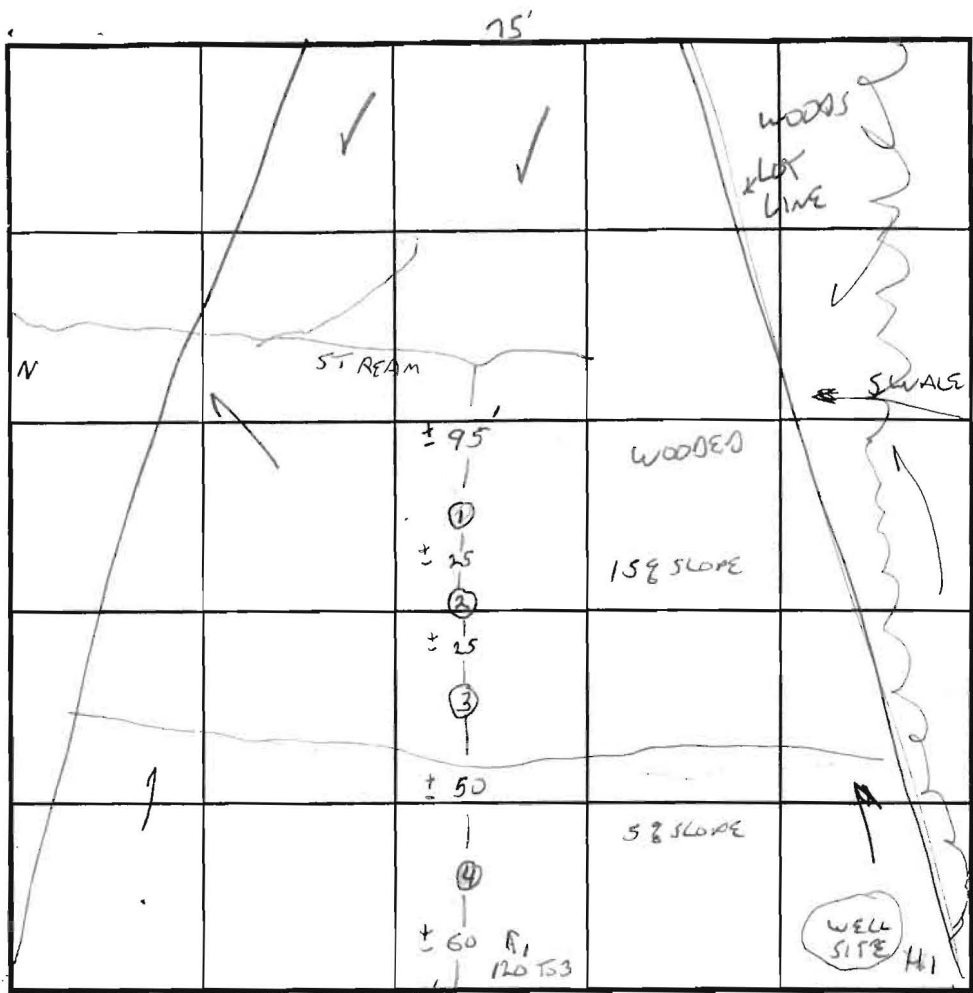

INDICATE NORTH - NAME ADJOINING ROADWAY AS BASE LINE. POLE →

LOT 4 POLE 30' ADJACENT LOT OR PLOT LOT 3

DATE	TEST NO.	DEPTH	PRE-WET		TEST - 1" DROP		TIME
			START	STOP	START	STOP	
5-4-98	1	8V	Rock				F
	2	7	Rock				F
	3	3.5 / 10" 8"	2:04			Slow	
		5.5	2:11 ⁵⁰	2:12 ⁴⁶	→	2:14:03	1:17
	4	6 / 12	2:46	2:47 ³⁰	→	2:49:40	1:10

COMPLETED TIME 1:94 1:282

REMARKS NORTH Boundary not known, PERCS NOT LAID OUT, WILL NEED ADDITIONAL

TYPE OF SOIL TESTING ONCE AREA IS LAID OUT, CHECK ADJACENT LOT AREAS LOT 3, 4

TESTED BY G. SAVAGE ALSO PRESENT JOHN SCHWEIDER, Fyck's

TRENCH DESIGN DATA: AVERAGE PERCOLATION TIME _____ TRENCH WIDTH _____

INLET DEPTH _____ MAXIMUM BOTTOM DEPTH _____ SQ. FT./BEDROOM _____