

PUB. SEWER STATUS VERIFIED BY _____

ISSUE DATE: _____

APPROVAL DATE: _____

PERMIT INDEXED

P _____

A 518990-D

ON-SITE SEWAGE DISPOSAL SYSTEM HOWARD COUNTY HEALTH DEPARTMENT BUREAU OF ENVIRONMENTAL HEALTH

04-334671

IS PERMITTED TO INSTALL ALTER

ADDRESS: _____ PHONE NUMBER: _____

SUBDIVISION: Gwenlee Estates LOT NUMBER: 3-D

ADDRESS: 3271 Gwenlee Circle PROPERTY OWNER: Benitez

SEPTIC TANK CAPACITY (GALLONS): _____

PUMP CHAMBER CAPACITY (GALLONS): _____

NUMBER OF BEDROOMS: _____

SQUARE FEET PER BEDROOM: _____

LINEAR FEET OF TRENCH REQUIRED: _____

TRENCHES:	Trench to be _____ feet wide. Inlet _____ feet below original grade. Bottom maximum depth _____ feet below original grade. Effective area begins at _____ feet below original grade. _____ feet of stone below distribution pipe.
LOCATION:	
PURPOSE:	

PLANS APPROVED: _____ DATE: _____

- NOTE: PERMIT VOID AFTER 2 YEARS
- NOTE: CONTRACTOR RESPONSIBLE FOR SCHEDULING A PRE-CONSTRUCTION INSPECTION FOR ALL INSTALLATIONS
- NOTE: WATERTIGHT SEPTIC TANKS REQUIRED
- NOTE: ALL PARTS OF SEPTIC SYSTEM SHALL BE 100 FEET FROM ANY WATER WELL
- NOTE: MANHOLE RISERS REQUIRED ON ALL SEPTIC TANKS AND PUMP CHAMBERS

NEITHER THE HOWARD COUNTY COUNCIL NOR THE HEALTH DEPARTMENT IS RESPONSIBLE FOR THE SUCCESSFUL OPERATION OF ANY SYSTEM PERMITTED RESPONSIBLE FOR OBTAINING FINAL APPROVAL ON THIS PERMIT

BUILDING PERMIT SIGNED AND RETURNED

CALL 410-313-2640 FOR INSPECTION OF SEPTIC SYSTEM

5-29-03 BOO M2151-DECK

7018 100 2

SEWAGE DISPOSAL SYSTEM

438121

MARYLAND STATE DEPARTMENT OF HEALTH

HOWARD COUNTY

ELLCOTT CITY

DISTRICT 2nd & 3rd

final
file good

INDEXED

DATE 4/18/77

Installers _____ IS PERMITTED TO INSTALL X ALTER _____

RES. Box 2281 Route 94, Woodbine, Md. PHONE 442-2280

SEWAGE DISPOSAL SYSTEM LOCATED AT _____

3791 GWENLEE CIRCLE

DIVISION Sanitation ROAD East side of Gwenlee Circle, 3D

PROPERTY OWNER Walter L. Spring

RES. Barnwoods Road, Glenwood, Md.

REQUIREMENTS 4 BED ROOMS

DRAIN FIELD _____ DEPTH _____ FEET, SURFACE AREA _____ SQ. FT.

SEWAGE PITS _____ ABSORBENT SIDE WALL AREA _____ SQ. FT.

SEPTIC TANK CAPACITY 1250 GALLONS

BLDG. PERMIT SIGNED AND RETURNED 4/6/77

Serial No. 31013

FOR GARAGE GRINDER, INCREASE DISPOSAL AREA AND TANK CAPACITY 50%.

OTHER: The trench (a) is to begin at a point 25 feet in from the right property line, 10 feet from the road, and 175 feet in from the road edge. The trench (a) will follow the contour of the land and be 2 feet wide, 18 feet deep, and contain 4 feet of stone. There will be a minimum of 175 sq. feet of sidewalk per bedroom. No trench is to exceed 75 feet in length and all trenches are to be connected in series, running parallel to each other, and spaced no closer than 20 feet, center to center.

NOTE: ALL PIPES FROM HOUSE TO DISPOSAL AREA MUST BE CASTIRON. PERMIT VOID AFTER THREE YEARS.

NOTE: INSTALL STAND-PIPE ON SEPTIC TANK. STAND-PIPES MUST BE 6 INCHES IN DIAMETER, CAST IRON, CONCRETE OR TANK COTTA ACCEPTED.


IS APPROVED BY Robert T. Massfield DATE 4/19/76

SEPTIC TANK AND DISTRIBUTION BOX WITH WATER BEFORE CALLING FOR AN INSPECTION. COVER NO WORK UNTIL INSPECTED AND APPROVED.

NEITHER THE HOWARD COUNTY COMMISSIONERS NOR THE HEALTH DEPARTMENT IS RESPONSIBLE FOR THE SUCCESSFUL OPERATION OF ANY SYSTEM.

BLDG. PERMIT SIGNED AND RETURNED 4/6/77
Serial No. 70101

1977

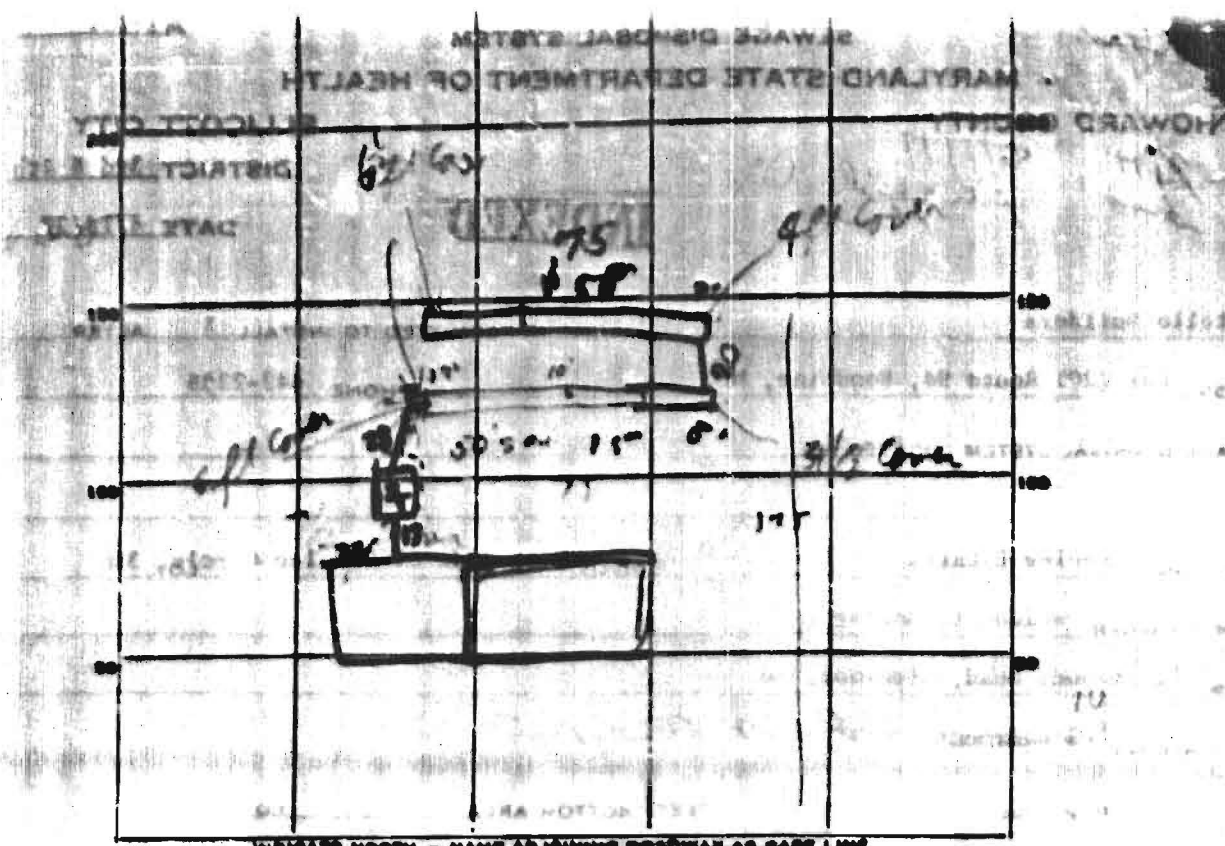

INDICATE NORTH - NAME ADJOINING SIDEWAY AS BASE LINE.

CARD No _____
 TANK LEVEL _____ CLEANOUTS ST
 DISTRIBUTION BOX LEVEL N.A.
 FIELD DEPTH 10' 0\"/>

WORKS OK to bring pipe into high part of ditch at City
Don't keep bottom of trench level OK to lay stone
in first 1/4' of trench OK to lay stone in trench
2009 4/12/77 1/2" gravel in trench to 6' below grade 10'
377 - DITCHES ARE BETWEEN 10 FT & 13 FT 1100 FT
OVER IS 4 FT 6\"/>

SYSTEM APPROVED 4/1/77 INSPECTOR [Signature]