

1 81789
 DATE WELL COMPLETED 3/14/73
 DEPTH OF WELL 120
 PERMIT NO. FROM "PERMIT TO DRILL WELL" 490
 COUNTY NUMBER 42
 DRILLERS IDENTIFICATION NO. 42

OWNER: *Malcolm C. ...*
 STREET OR RFD: *9252 ...*
 POST OFFICE: *...*

WELL LOG

STATE THE KIND OF FORMATIONS PENETRATED, THEIR COLOR, DEPTH, THICKNESS AND IF WATER BEARING

DESCRIPTION (USE ADDITIONAL SHEETS IF NECESSARY)	FEET		CHECK IF WATER BEARING
	FROM	TO	
<i>...</i>	0	70	
<i>...</i>	70	100	
<i>...</i>	100	140	

ROUTING RECORD

WELL HAS BEEN ROUTED (CIRCLE APPROPRIATE BOX) Y N

TYPE OF ROUTING MATERIAL (CIRCLE BOX) C M B C

CEMENT 48 58 GYPSUMITE CLAY 48 48

NO. OF BAGS 12 NO. OF POUNDS 120

GALLONS OF WATER

DEPTH OF GROUT SEAL (TO NEAREST FOOT)
 FROM 0 FT. TO 47 FT.
 (ENTIRE 6 IN FROM SURFACE)

CASING RECORD

(INSERT APPROPRIATE CODE BELOW)

STEEL CONCRETE
 PLASTIC OTHER

MAIN CASING TYPE: UO O1 O2 S1 S2 S3 S4 S5 S6 S7

MINOR CASING TYPE: UO O1 O2 S1 S2 S3 S4 S5 S6 S7

MINOR DIAMETER (NEAREST INCH) 6 TOTAL DEPTH OF MAIN CASING (NEAREST FOOT) 17

OTHER CASING (IF USED)

DIAMETER (INCH) FROM TO

SCREEN TYPE OR OPEN HOLE

SCREEN RECORD

(INSERT APPROPRIATE CODE BELOW)

STEEL BRASS OR BRONZE OPEN HOLE
 PLASTIC OTHER

DEPTH (NEAREST WHOLE FOOT)
 FROM TO

EACH SCREEN: 1, 2, 3

SCREEN 1: 11, 15, 17, 21
 SCREEN 2: 23, 24, 26, 30, 32, 36
 SCREEN 3: 38, 39, 41, 45, 47, 51

SLIT SIZE 1, 2, 3

PUMPING TEST

HOURS PUMPED (TO NEAREST HOUR) 2

PUMPING RATE (GALLONS PER MINUTE TO NEAREST GALLON) 30

WATER LEVEL (DISTANCE FROM LAND SURFACE)
 BEFORE PUMPING 7' (NEAREST FOOT)
 WHEN PUMPING 140' (NEAREST FOOT)

TYPE OF PUMP USED (CIRCLE APPROPRIATE BOX) (FOR PUMPING TEST)

AIR P PISTON T TURBINE
 C CENTRIFUGAL R ROTARY O OTHER (SEE CODE BELOW)
 J JET S SUBMERSIBLE


PUMP INSTALLED

TYPE OF PUMP (WRITE APPROPRIATE LETTER OR BOX - SEE ABOVE: A, C, J, P, R, O, T, S) 29

DRILLER WILL INSTALL PUMP (CIRCLE APPROPRIATE BOX) YES NO

CAPACITY:
 GALLONS PER MINUTE (TO NEAREST GALLON) 31 35
 PUMP HORSE POWER 27 31
 PUMP COLUMN LENGTH (NEAREST FOOT) 49 47

CASING HEIGHT (CIRCLE APPROPRIATE BOX AND ENTER CASING HEIGHT)
 ABOVE LAND SURFACE
 BELOW LAND SURFACE (NEAREST FOOT) 49 51

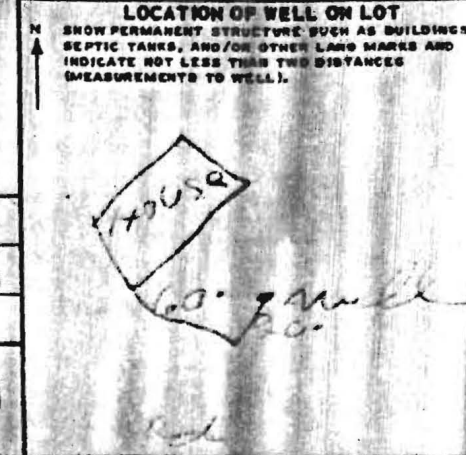

CIRCLE APPROPRIATE BOXES

A WELL WAS ABANDONED AND SEALED WHEN THIS WELL WAS COMPLETED

E ELECTRIC LOG OBTAINED

P TEST WELL CONVERTED TO PRODUCTION WELL

I HEREBY CERTIFY THAT I HAVE COMPLIED WITH ALL CONDITIONS STATED ON THE ABOVE-CAPTIONED "PERMIT TO DRILL WELL", AND THAT INFORMATION CONTAINED IN THIS REPORT IS TRUE, ACCURATE, AND COMPLETE TO THE BEST OF MY KNOWLEDGE, INFORMATION AND BELIEF.

DRILLERS NAME: *...*

(PLEASE PRINT) *...*

SIGNATURE: *...*

DIAMETER OF SCREEN (NEAREST INCH) FROM TO

GRAVEL PACK

IF WELL DRILLED WAS A FLOWING WELL (CIRCLE BOX) Y N

DWP USE ONLY (NOT TO BE FILLED IN BY DRILLER)

TELESCOPE CASING T 73 72

LOG INDICATOR W Q 74 75 76

OTHER DATA AVAILABLE