

6/17/03 11am Layout

PUB. SEWER STATUS VERIFIED BY NA SRM

ISSUE DATE: 6/11/2003

PERMIT

P 519008

APPROVAL DATE: 6/17/03

INDEXED

A REPAIR

ON-SITE SEWAGE DISPOSAL SYSTEM HOWARD COUNTY HEALTH DEPARTMENT BUREAU OF ENVIRONMENTAL HEALTH

05-346878

Hatfields Equipment IS PERMITTED TO INSTALL ALTER

ADDRESS: 13785 Burntwoods Rd, Glenelg PHONE NUMBER: 410-531-6773

SUBDIVISION: _____ LOT NUMBER: _____

ADDRESS: 4987 Green Bridge Road PROPERTY OWNER: David & Carolyn Rowe

SEPTIC TANK CAPACITY (GALLONS): ~~1250~~ 1500

PUMP CHAMBER CAPACITY (GALLONS): N/A

NUMBER OF BEDROOMS: 4

SQUARE FEET PER BEDROOM: _____

LINEAR FEET OF TRENCH REQUIRED: _____

TRENCHES:	Trench to be _____ feet wide. Inlet _____ feet below original grade. Bottom maximum depth _____ feet below original grade. Effective area begins at _____ feet below original grade. _____ feet of stone below distribution pipe.
LOCATION:	System should be installed so that there is adequate clearance from the proposed house.
PURPOSE:	In support of building permit for the new house. Call for inspection when ground is opened.

PLANS APPROVED: Brian Baker DATE: 6/6/03

- NOTE: PERMIT VOID AFTER 2 YEARS
- NOTE: CONTRACTOR RESPONSIBLE FOR SCHEDULING A PRE-CONSTRUCTION INSPECTION FOR ALL INSTALLATIONS
- NOTE: WATERTIGHT SEPTIC TANKS REQUIRED
- NOTE: ALL PARTS OF SEPTIC SYSTEM SHALL BE 100 FEET FROM ANY WATER WELL
- NOTE: MANHOLE RISERS REQUIRED ON ALL SEPTIC TANKS AND PUMP CHAMBERS

NEITHER THE HOWARD COUNTY COUNCIL NOR THE HEALTH DEPARTMENT IS RESPONSIBLE FOR THE SUCCESSFUL OPERATION OF ANY SYSTEM PERMITTED. PERMITTEE RESPONSIBLE FOR OBTAINING FINAL APPROVAL ON THIS PERMIT. CALL 410-313-2640 FOR INSPECTION OF SEPTIC SYSTEM

BUILDING PERMIT SIGNED AND RETURNED


6903 800 141727 - 2 Bdrm Addition

519008

NOT TO SCALE

WOODS

INDEXED

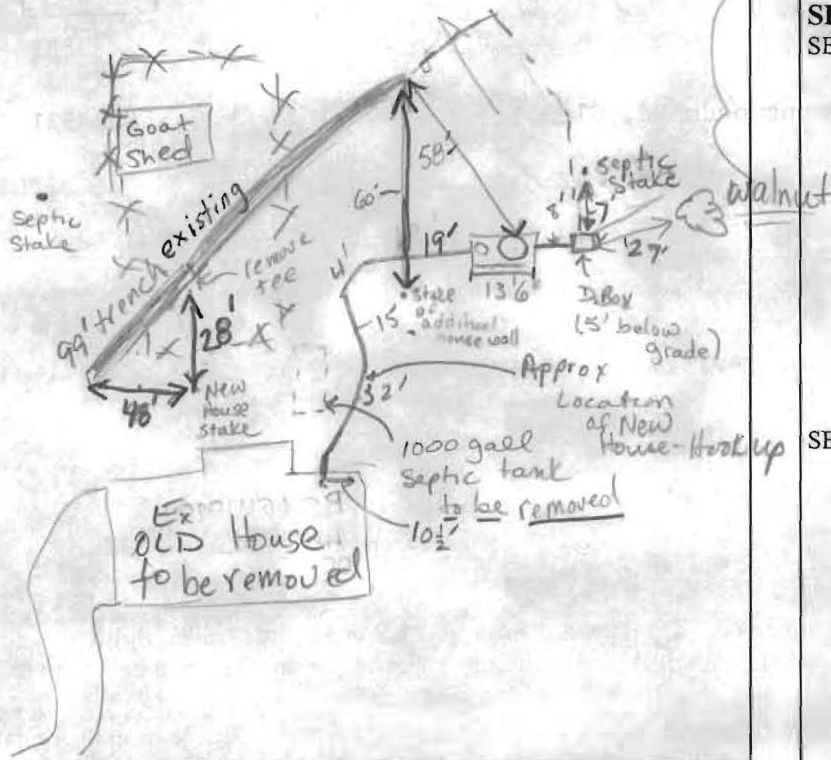

Green Bridge

ROAD

existing:

TRENCH/DRAINFIELD DATA		
WIDTH	INLET	BOTTOM
3	5 1/2	?
NUMBER OF TRENCHES		1
TOTAL LENGTH		100'
ABSORPTION AREA		?
DISTRIBUTION BOX LEVEL		yes
DISTRIBUTION BOX BAFFLE		yes
DISTRIBUTION BOX PORT		No

SEPTIC TANK DATA	
SEPTIC TANK 1 LEVEL	yes
CAPACITY	1500 GAL
SEAM LOC	Top
TANK LID DEPTH	30-36"
BAFFLES	yes
BAFFLE FILTER	No
MANHOLE LOC	back
6" PORT LOC	front
WATERTIGHT TEST	No
SEPTIC TANK 2 LEVEL	N/A
CAPACITY	_____ GAL
SEAM LOC	_____
TANK LID DEPTH	_____
BAFFLES	_____
BAFFLE FILTER	_____
MANHOLE LOC	_____
6" PORT LOC	_____
WATERTIGHT TEST	_____

PRE-CONSTRUCTION 6/17/03 Installed 1500 gallon S.T. Existing system functioning properly. Owners said not upsizing to 4 bedrooms - maintaining 3; distance of septic trench ~28' from new house wall closest to SPA. Owner said old hand-dug well in back was cemented.

(KN)

BUILDING PERMIT SIGNED AND RETURNED

FINAL INSPECTOR Raele Norman DATE OF APPROVAL 6/17/03