

MARYLAND DEPARTMENT OF THE ENVIRONMENT, WATER MANAGEMENT ADMINISTRATION  
 2500 BROENING HIGHWAY, BALTIMORE, MARYLAND 21224, (410) 631-3784

\*\*\*\*\*  
 WATER WELL ABANDONMENT-SEALING REPORT FORM  
 \*\*\*\*\*

SUBMIT COPIES OF COMPLETED FORM TO:

- \* COUNTY ENVIRONMENT AGENCY (contact MDE, WMA if address needed)
- \* WELL OWNER
- \* MDE, WATER MANAGEMENT ADMINISTRATION, WELL PROGRAM

DATE WELL ABANDONED: 8-27-04 (month/day/year)

\* PERMIT NUMBER OF ABANDONED WELL (if any) none - -

\* PERMIT NUMBER OF REPLACEMENT WELL none - -


\* PERSON ABANDONING WELL: Joseph H. Mayne

WELL DRILLERS LICENSE NUMBER: 024  
 CIRCLE: MWD/MSD/MGD

\* OWNER'S NAME: Ida Hines

SITE LOCATION MAP

\* WELL LOCATION:  
 COUNTY: Howard  
 NEAREST TOWN: Savage  
 TAX MAP \_\_\_\_\_ BLOCK \_\_\_\_\_ PARCEL \_\_\_\_\_  
 SUBDIVISION: \_\_\_\_\_  
 SECTION: \_\_\_\_\_ LOT: \_\_\_\_\_  
 NEAREST ROAD: 10752 Scaggsville Rd

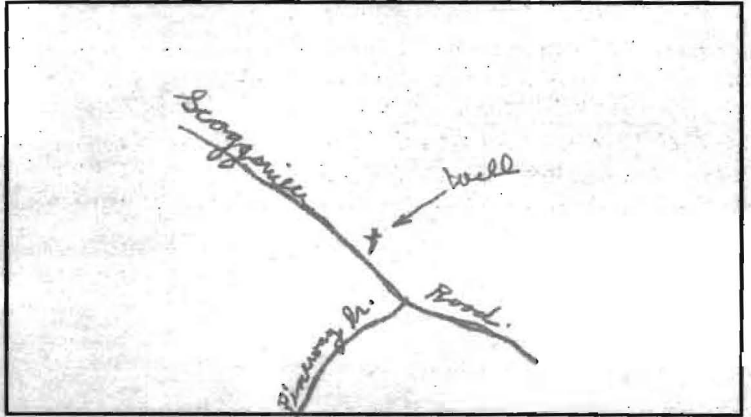

\* TYPE OF WELL BEING ABANDONED:

- DRILLED  JETTED
- BORED/AUGERED  HAND DUG
- OTHER (specify) \_\_\_\_\_

\* USE CODE:

- DOMESTIC  MUNICIPAL/PUBLIC
- IRRIGATION  INDUSTRIAL
- TEST/OBSERVATION  GEOTHERMAL

\* TYPE OF CASING:

- STEEL  PLASTIC
- CONCRETE  OTHER (specify) \_\_\_\_\_

\* SIZE OF CASING: 5.5 INCHES IN DIAMETER

\* DEPTH OF WELL: 100 FEET DEEP

\* WAS ANY CASING REMOVED?  YES  NO  
 if yes, length removed, in feet: \_\_\_\_\_

\* WAS CASING RIPPED OR PERFORATED?  YES  NO

LOG OF SEALING MATERIAL

| MATERIAL                | FEET |     |
|-------------------------|------|-----|
|                         | FROM | TO  |
| Cement + gravel mixed - | 0    | 100 |
| VOLUME OF MATERIAL USED |      |     |
|                         |      |     |

SIGNATURE-MASTER WELL DRILLER OR SUPERVISING SANITARIAN: Joseph H. Mayne LICENSE # 024 CIRCLE ONE MWD/MSD/MGD DATE 8-30-04