


A# 07450

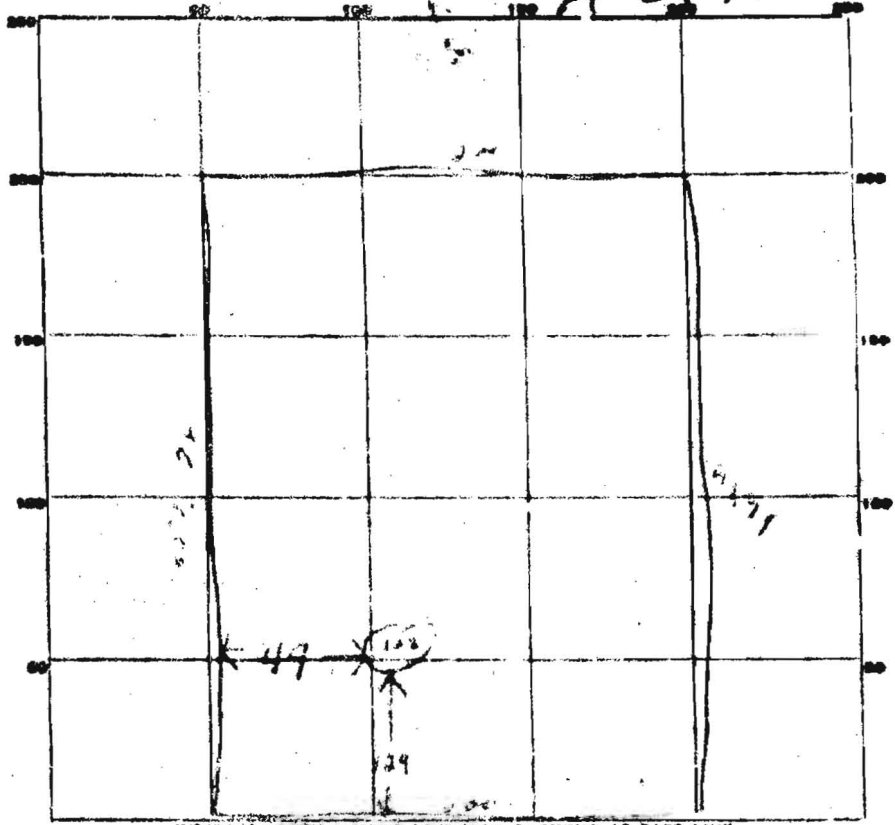

INDICATE NORTH - NAME ADJOINING ROADWAY AS BASE LINE.

Sampled

DATE	TEST NO.	DEPTH	PRE-WET		TEST - 1" DROP		TIME
			START	STOP	START	STOP	
9/24/47	1	108	1022	1025	1025	1038	13:30
	2	54	1022	1027	1027	1035	9:00

SOIL AUGER FINDING _____

TESTED BY *Rich 10-2-63*

REMARKS _____

ALSO PRESENT *C. H. ...* LOT NO. *9-1-1*