

APPLICATION

A 18716

P _____

SEWAGE DISPOSAL TESTING

MARYLAND STATE DEPARTMENT OF HEALTH

HOWARD COUNTY

ELLICOTT CITY

DISTRICT 3

DATE 8/12/69

TO: THE COUNTY HEALTH OFFICER
ELLICOTT CITY, MARYLAND

I, HEREBY, APPLY FOR THE NECESSARY TESTS IN ORDER TO CONSTRUCT (OR RECONSTRUCT) A SEWAGE DISPOSAL SYSTEM.

PROPERTY OWNER Mark A. Wakefield, Jr.

ADDRESS 231 Chatham Rd., Ellicott City, Md. PHONE HO 5-1345

PROPERTY LOCATION:

SUBDIVISION Woodmark, Inc. LOT NO. 47, Blk. B, Sec. 6

ROAD AND DESCRIPTION Benson Branch Road

OCCUPANT _____ PHONE _____

PERSON TO CONSTRUCT SYSTEM _____

ADDRESS _____ PHONE _____

SIZE OF LOT 160' x 235' x 155' x 290' TYPE BLDG. 3 of 4
NUMBER OF BEDROOMS

IF NOT SINGLE RESIDENCE DESCRIBE _____

SIGNATURE OF APPLICANT /s/ Mark A. Wakefield, Jr.

APPROVED BY _____ FOR _____ DATE _____
(KIND OF SYSTEM)

REJECTED BY _____ FOR _____ DATE _____
(KIND OF SYSTEM)

HOLD PENDING FURTHER TESTS _____ DATE _____


REASONS FOR REJECTION OR HOLDING _____

THIS IS NOT A PERMIT

Permit Columbus
 12/10/69

APPLICATION

Some change in lot
 lines filed
 not needed
 because
 hole not affected
 by shift RH

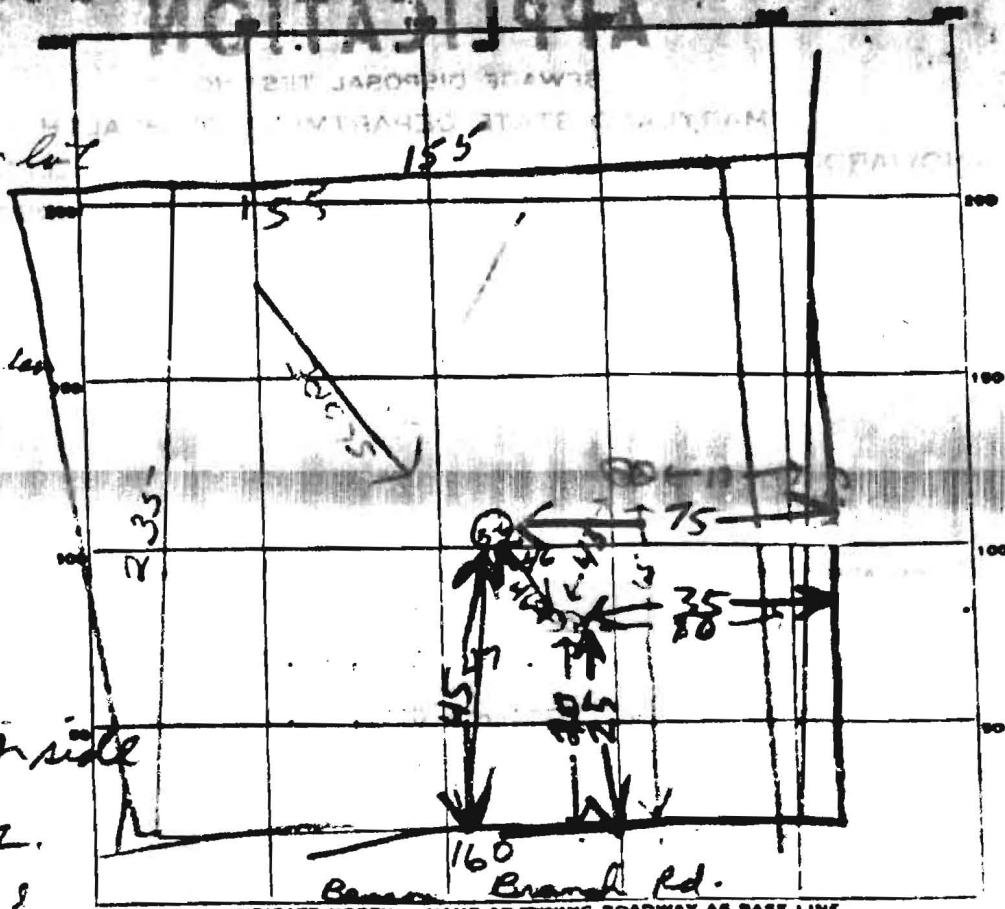

INDICATE NORTH. - NAME ADJOINING ROADWAY AS BASE LINE.

12/18/69

Slight
 change inside
 lot lines.
 Front line
 almost same

as tested 10/10/69
 chart 7
 RH

DATE	TEST NO.	DEPTH	PRE-WET		TEST - 1" DROP		TIME
			START	STOP	START	STOP	
10/10/69	1	4 1/2 ft	1 30	1 31	1 31	1 32	1 min
	2	9 1/2 ft	1 35	1 33	1 33	1 39	6 min
	3	8 1/2 ft	1 40	1 48	1 48	2 00	12 min
	4	4 ft	1 41	1 57	1 57	2nd inch Quartz	
	5	10'	9 44	9 48	9 48	9 53	5 min
	6	4 1/2'	9 44	9 49	9 49	9 56	7 min

11/15/69
 JT

SOIL AUGER FINDING

TESTED BY R. Turner

REMARKS Need another hole.

5 min
 10 min
 15 min