

WELL NO. 8389
 DATE WELL COMPLETED 6-26-73 DEPTH OF WELL 240
 PERMIT NO. FROM "PERMIT TO DRILL WELL" 111-73-0918
 DRILLER'S IDENTIFICATION NO. 42

OWNER Denise Woodmark FIRST NAME
47 STREET OR RFD. POST OFFICE Edgewater

WELL LOG

STATE THE KIND OF FORMATIONS PENETRATED, THEIR COLOR, DEPTH, THICKNESS AND IF WATER BEARING

DESCRIPTION (USE ADDITIONAL SHEETS IF NECESSARY)	FEET		CHECK IF WATER BEARING
	FROM	TO	
<u>0-2</u>	<u>0</u>	<u>2</u>	
<u>2-21</u>	<u>2</u>	<u>21</u>	
<u>21-240</u>	<u>21</u>	<u>240</u>	

GROUTING RECORD

WELL HAS BEEN GROUTED (CIRCLE APPROPRIATE BOX) Y N

TYPE OF GROUTING MATERIAL (CIRCLE NO.)
 CEMENT 44 45
 BENTONITE CLAY 46 47

NO. OF BAGS 8 NO. OF POUNDS 504

GALLONS OF WATER 50

DEPTH OF GROUT SEAL (TO NEAREST FOOT)
 FROM 0 FT. TO 28 FT.
 (ENTER 0 IF FROM SURFACE)

PUMPING TEST

1 2 3 (SEQ. NO.)

HOURS PUMPED (TO NEAREST HOUR) 2

PUMPING RATE (GALLONS PER MINUTE TO NEAREST GALLON) 5

NET MEASURE PUMPING RATE _____

WATER LEVEL (DISTANCE FROM LAND SURFACE)
 BEFORE PUMPING 28 INCHES
 WHEN PUMPING 47 INCHES

TYPE OF PUMPED USED (CIRCLE APPROPRIATE BOX)
 AIR PISTON TURBINE
 CENTRIFUGAL ROTARY OTHER (DESCRIBE BELOW)
 JET SUBMERSIBLE

CASING RECORD

MAIN CASING TYPE B1 STEEL C1 CONCRETE
 P1 PLASTIC D1 OTHER

NOMINAL DIAMETER TOP (MAIN) CASING (NEAREST INCH) 6

TOTAL DEPTH OF MAIN CASING (NEAREST FOOT) _____

OTHER CASING (IF USED)

TYPE	DIAMETER (INCH)	DEPTH (FEET) FROM TO
A		
C		
H		
M		
S		
N		

SCREEN RECORD

SCREEN TYPE OR OPEN HOLE (CIRCLE APPROPRIATE CODE BELOW)

S1 STEEL B1 BRASS OR BRONZE H1 HO P1 PLASTIC O1 OTHER

DEPTH (NEAREST WHOLE FOOT)

1 2 3 (SEQ. NO.)

DEPTH (FEET)	FROM	TO
1	<u>8</u>	<u>21</u>
2	<u>23</u>	<u>30</u>
3	<u>38</u>	<u>51</u>

SLOT SIZE 1. _____ 2. _____ 3. _____

PUMP INSTALLED

TYPE OF PUMP (WRITE APPROPRIATE LETTER IN BOX - SEE ABOVE) A, C, J, P, R, T, S


DRILLER WILL INSTALL PUMP (CIRCLE APPROPRIATE BOX) YES NO

CAPACITY:
 GALLONS PER MINUTE (TO NEAREST GALLON) _____

PUMP HORSE POWER _____

PUMP COLUMN LENGTH (NEAREST FOOT) _____

CASING HEIGHT (CIRCLE APPROPRIATE BOX AND ENTER CASING HEIGHT)
 ABOVE } LAND SURFACE
 BELOW } NEAREST FOOT

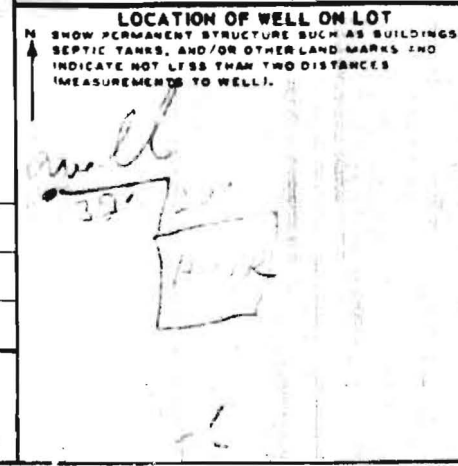

CIRCLE APPROPRIATE BOXES

A WELL WAS ABANDONED AND SEALED WHEN THIS WELL WAS COMPLETED

E ELECTRIC LOG OBTAINED

P TEST WELL CONVERTED TO PRODUCTION WELL

HEREBY CERTIFY THAT I HAVE COMPLIED WITH ALL CONDITIONS STATED ON THE ABOVE-CAPTIONED "PERMIT TO DRILL WELL", AND THAT INFORMATION CONTAINED IN THIS REPORT IS TRUE, ACCURATE, AND COMPLETE TO THE BEST OF MY KNOWLEDGE, INFORMATION AND BELIEF.

DRILLER'S NAME _____

PLEASE PRINT _____

SIGNATURE _____

DIAMETER OF SCREEN _____ (NEAREST INCH)
 FROM _____ TO _____

TRAVEL PACK _____

IF WELL DRILLED WAS A FLOWING WELL (CIRCLE BOX) 60 F

DWP USE ONLY (NOT TO BE FILLED IN BY DRILLER)
 TELESCOPE CASING 70 72 74 75 76
 LOG INDICATOR _____ OTHER DATA AVAILABLE _____

*6-29-73
 30' casing
 26' open
 8' improvement
 of top*

Also set new

D. Box w/ dial-a-flow
speed levelers to test

old Drywell rest.

— Steve

