

PUB. SEWER STATUS VERIFIED BY _____

ISSUE DATE: _____

APPROVAL DATE: _____

PERMIT INDEXED

P 519049-G

A Re-indexed

ON-SITE SEWAGE DISPOSAL SYSTEM HOWARD COUNTY HEALTH DEPARTMENT BUREAU OF ENVIRONMENTAL HEALTH

04-331060

IS PERMITTED TO INSTALL ALTER

ADDRESS: _____ PHONE NUMBER: _____

SUBDIVISION: River Farms LOT NUMBER: 12

ADDRESS: 2520 Daisy Road PROPERTY OWNER: Jean Riley

SEPTIC TANK CAPACITY (GALLONS): _____

PUMP CHAMBER CAPACITY (GALLONS): _____

NUMBER OF BEDROOMS: _____

SQUARE FEET PER BEDROOM: _____

LINEAR FEET OF TRENCH REQUIRED: _____

TRENCHES:	Trench to be _____ feet wide. Inlet _____ feet below original grade. Bottom maximum depth _____ feet below original grade. Effective area begins at _____ feet below original grade. _____ feet of stone below distribution pipe.
LOCATION:	
PURPOSE:	File re-indexed.

PLANS APPROVED: _____ DATE: _____

- NOTE: PERMIT VOID AFTER 2 YEARS
- NOTE: CONTRACTOR RESPONSIBLE FOR SCHEDULING A PRE-CONSTRUCTION INSPECTION FOR ALL INSTALLATIONS
- NOTE: WATERTIGHT SEPTIC TANKS REQUIRED
- NOTE: ALL PARTS OF SEPTIC SYSTEM SHALL BE 100 FEET FROM ANY WATER WELL
- NOTE: MANHOLE RISERS REQUIRED ON ALL SEPTIC TANKS AND PUMP CHAMBERS

**NEITHER THE HOWARD COUNTY COUNCIL NOR THE HEALTH DEPARTMENT IS
RESPONSIBLE FOR THE SUCCESSFUL OPERATION OF ANY SYSTEM
PERMITTEE RESPONSIBLE FOR OBTAINING FINAL APPROVAL ON THIS PERMIT
CALL 410-313-2640 FOR INSPECTION OF SEPTIC SYSTEM**

P519049-G

9/21/72
9/21/72
9/21/72
10/6/72
File

INDEXED

Final OK
K. Town

PERMIT

SEWAGE DISPOSAL SYSTEM

P. 16796

A. 15241

MARYLAND STATE DEPARTMENT OF HEALTH

HOWARD COUNTY

ELLICOTT CITY

DISTRICT 4

DATE 2/29/72

Robert E. Snapp

IS PERMITTED TO INSTALL ALTER

ADDRESS 29641 Ridge Rd., Damascus, Md.

PHONE 253-2857

A SEWAGE DISPOSAL SYSTEM LOCATED AT

SUBDIVISION River Farms, Inc.

2920
ROAD Daisy Rd. (See Appl. LOT 12
for better directions)

PROPERTY OWNER James Wheeler

ADDRESS

SPECIFICATIONS 3 Bedrooms

DRAIN FIELD DEPTH FEET. BOTTOM AREA SQ. FT.

SEEPAGE PITS ABSORBENT SIDE WALL AREA SQ. FT.

SEPTIC TANK CAPACITY 1200 GALLONS

FOR GARBAGE GRINDER, INCREASE DISPOSAL AREA 22% & TANK CAPACITY 25%.

OTHER Dry Wells - Dig each pit 16 ft. sq. Set block and top for 12 ft. diameter & fill in rest of pit with gravel. Each dry well to have 6 ft. effective depth below inlet inlet pipe 1 ft. below grade. Max. depth permitted for dry wells is 10 ft. below original grade. IF WATER BPT CALL HEALTH DEPT. Place each dry well 171 ft. from edge of Daisy Rd. with one dry well 75 ft. from right side line and second dry well 40 ft. from right side line as seen when facing lot from Daisy Rd. Dry Wells to be connected in series. Alright to put in trench 40 ft. long 9 ft. deep - 5 ft. of gravel under pipe Cell for inspection of trench before gravel is installed.

NOTE: ALL PIPE FROM HOUSE TO SEPTIC TANK MUST BE CAST IRON.

PLANS APPROVED BY D. W. Monaghan

DATE 5/21/70

PERMIT VOID AFTER THREE YEARS


FILL SEPTIC TANK AND DISTRIBUTION BOX WITH WATER BEFORE CALLING FOR AN INSPECTION. COVER NO WORK UNTIL INSPECTED AND APPROVED.

NOTE: INSTALL STAND PIPE ON SEPTIC TANK AND DRY WELLS

NEITHER THE HOWARD COUNTY COMMISSIONERS NOR THE HEALTH DEPARTMENT IS RESPONSIBLE FOR THE SUCCESSFUL OPERATION OF ANY SYSTEM.

9/21/72 - 16 ft sq set block top for 12 ft diameter & fill in rest of pit with gravel. Each dry well to have 6 ft effective depth below inlet pipe 1 ft below grade. Max depth permitted for dry wells is 10 ft below original grade. IF WATER BPT CALL HEALTH DEPT. Place each dry well 171 ft from edge of Daisy Rd. with one dry well 75 ft from right side line and second dry well 40 ft from right side line as seen when facing lot from Daisy Rd. Dry Wells to be connected in series. Alright to put in trench 40 ft long 9 ft deep - 5 ft of gravel under pipe Cell for inspection of trench before gravel is installed.

34
32
6

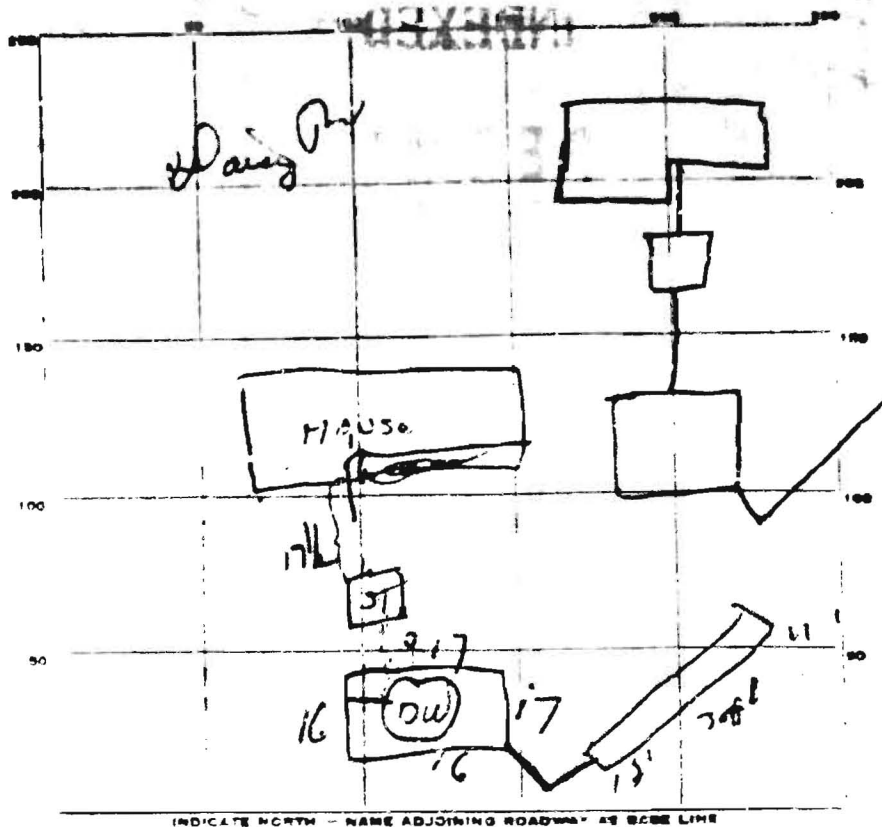

PERMIT CARD _____

SEPTIC TANK LEVEL OK

CLEANOUTS ~~XXXXXXXXXX~~

DISTRIBUTION BOX LEVEL _____

TILE FIELD DEPTH 10' FT TRENCH WIDTH 24"

GRAVEL DEPTH 8" IN. TOTAL LENGTH 30 FT.

NUMBER OF TRENCHES 1 bedroom 480 sq ft

SEEPAGE PTS. INSIDE DIAMETER 66 FT. DEPTH BELOW INLET 2 FT.

ABSORBENT AREA 462 SQ. FT.

REMARKS 9/15/72 OK to put gravel in trench DW

9/24/72 Cleanouts base on ST + DW (HIS) need plugs

10/6/72 Cleanouts connected to tank + DW.

DATE SYSTEM APPROVED 10/6/72

INSPECTOR K.T.