

APPLICATION

A 25284

P _____

SEWAGE DISPOSAL TESTING

MARYLAND STATE DEPARTMENT OF HEALTH

HOWARD COUNTY

ELLICOTT CITY

DISTRICT 4

DATE 5/18/70

TO: THE COUNTY HEALTH OFFICER
ELLICOTT CITY, MARYLAND

I, HEREBY, APPLY FOR THE NECESSARY TESTS IN ORDER TO CONSTRUCT (OR RECONSTRUCT) A SEWAGE DISPOSAL SYSTEM.

PROPERTY OWNER River Farms, Inc.

ADDRESS Ellicott City, Maryland PHONE _____

PROPERTY LOCATION:

SUBDIVISION River Farms, Inc. LOT NO. 12

ROAD AND DESCRIPTION Daisy Road - (North of intersection Daisy Rd. & EA Warfield Rd.) - use Rt. 144 - follow Daisy Road past A. E. Mullinix Rd. - approx. 1700' past A. E. Mullinix Rd. HALLOWELL

OCCUPANT _____ PHONE SIGN

PERSON TO CONSTRUCT SYSTEM _____

ADDRESS _____ PHONE _____

SIZE OF LOT 4.347 acres TYPE BLDG 3 or 4

IF NOT SINGLE RESIDENCE DESCRIBE _____ (Single Fmly. Dwlg.)

SIGNATURE OF APPLICANT JAMES ROSS WHEELER 588-6864

APPROVED BY [Signature] FOR [Signature] (2) DATE 5-21-70


REJECTED BY _____ FOR _____ DATE _____

HOLD PENDING FURTHER TESTS _____ DATE _____

REASONS FOR REJECTION OR HOLDING _____

THIS IS NOT A PERMIT

14521 A
9

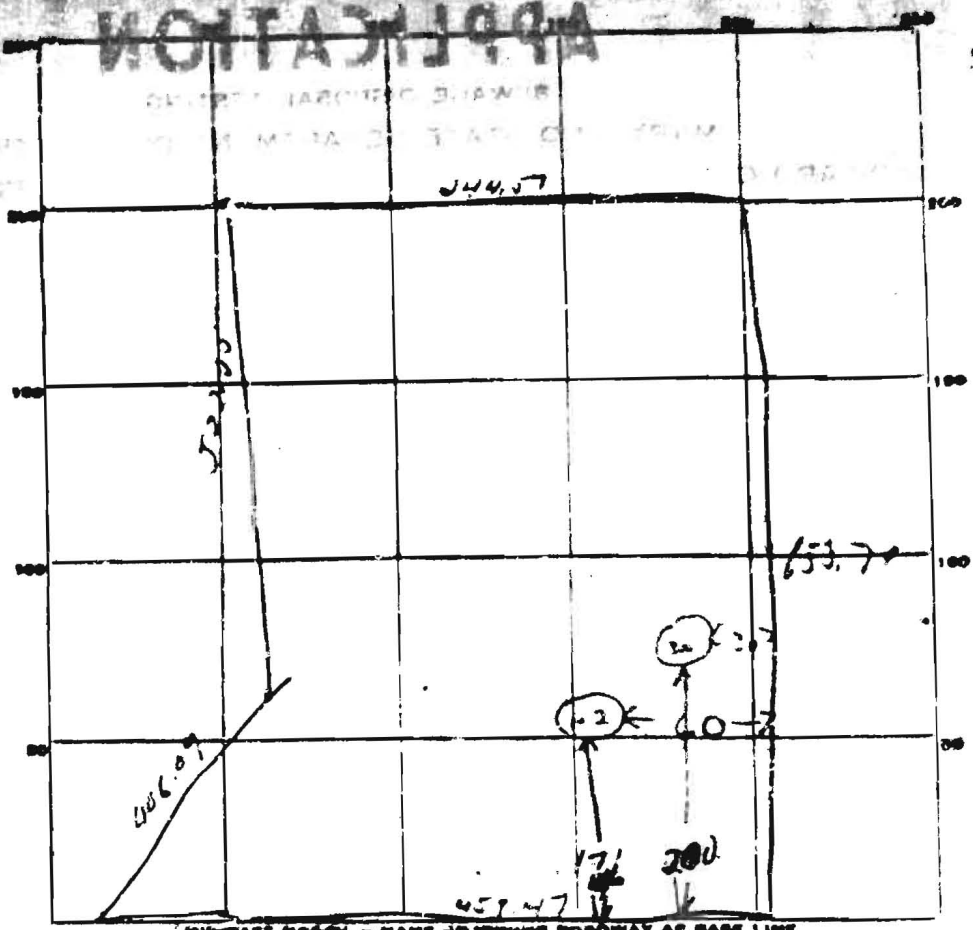

INDICATE NORTH - NAME ADJOINING ROADWAY AS BASE LINE.
Denny Road

DATE	TEST NO.	DEPTH	WET		TEST - 1" DROP		TIME	
			START	STOP	START	STOP		
3/21/38	1	9.0	2 08	2 18	2 18	2 35	17 min	
	2	4.0	2 07	2 15	2 15	2 30	15 min	
	3	19.0	2 14	2 28	2 28	2 55	27 min	
	4	" "	not taken - same type soil					


SOIL AUGER FINDING _____
 TESTED BY D.M.
 REMARKS _____

LOT # 12

RIVER FARMS INC.
DAISY, MD.



1712241

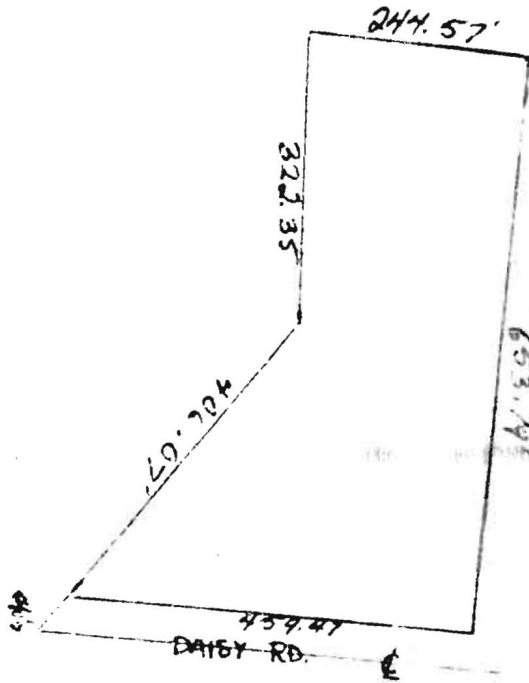

JAMES P WHEELER
2104 HILDAROSE DR # 5
SILVER SPRING MD 20902
SPS 6864

