

# HOWARD COUNTY PERMIT APPLICATION

**PERMIT NUMBER**

B000142804

Building Address 2520 Daisy Rd  
Woodburn 21797

Property Owner's Name Jean Riley  
 Address 2520 Daisy Rd

Suite/Apt. #: \_\_\_\_\_ SDP/WP/Petition #: \_\_\_\_\_

City Woodburn State MD Zip Code 21797

Census Tract 604002 Subdivision Rob Woodfield

Home Phone 410-707-4434 Work Phone \_\_\_\_\_

Section \_\_\_\_\_ Area \_\_\_\_\_ Lot 12 River

Applicant's Name & Mailing Address, (if other than stated hereon):  
Jeremy Clancy

Tax Map 13 Parcel 93 Grid 12 Farms

6401 Golden Triangle Dr

Zoning R-350 Map Coordinates 86A Lot size 4391 Δ

Greenbelt MD 20770

Existing Use SFD

Phone 301-273-1016 Fax 301-273-0211

Proposed Use SFD w/ Sunroom

Contractor Company Willard Energy Corp

Estimated Construction Cost \$ 35,000

Contact Person Jeremy Clancy

Description of Work Cond. A 22x25 Sunroom

Address 6401 Golden Triangle Dr

on new concrete slab w/ footers

City Greenbelt State MD Zip Code 20770

License No. 330107

Phone 301-273-1016 Fax \_\_\_\_\_

Occupant or Tenant Jean Riley

Engineer or Architect Company \_\_\_\_\_

Contact Name Jeremy Clancy

Contact Person Same as Cont.

Address 2520 Daisy Rd

Address \_\_\_\_\_

City Woodburn State MD Zip Code 21797

City \_\_\_\_\_ State \_\_\_\_\_ Zip Code \_\_\_\_\_

Phone 410-707-4434 Fax \_\_\_\_\_

Phone \_\_\_\_\_ Fax \_\_\_\_\_

**BUILDING DESCRIPTION - COMMERCIAL**

**BUILDING DESCRIPTION - RESIDENTIAL**

Building Characteristics

Utilities

Building Characteristics

Utilities

Height: \_\_\_\_\_  
 No. of stories: \_\_\_\_\_  
 Gross area, sq. ft. per floor: \_\_\_\_\_  
 Use group: \_\_\_\_\_  
 Construction type:  
 Reinforced Concrete  
 Structural Steel  
 Masonry  
 Wood Frame  
 State Certified Modular

Water Supply:  
 Public  
 Private  
 Sewage Disposal:  
 Public  
 Private  
 Electric Yes  No   
 Gas Yes  No   
 Heating System:  
 Electric  Oil   
 Natural Gas   
 Propane Gas   
 Sprinkler system: N/A   
 Full  
 Partial  
 Other Suppression  
 # of Heads

SF Dwelling  SF Townhouse   
 Depth Width  
 1st floor: 27 22  
 2nd floor: 5504  
 Basement:  
 Finished Basement  Unfinished Basement   
 Crawl space  Slab on Grade   
 No. of Bedrooms: \_\_\_\_\_  
 Multi-family dwellings:  
 No. of efficiency units: \_\_\_\_\_  
 No. of 1 BR units: \_\_\_\_\_  
 No. of 2 BR units: \_\_\_\_\_  
 No. of 3 BR units: \_\_\_\_\_  
 Other Structure: Sunroom  
 Dimensions: \_\_\_\_\_  
 Footings: \_\_\_\_\_  
 Roof: \_\_\_\_\_  
 State Certified Modular  
 Manufactured Home

Water Supply:  
 Public  
 Private  
 Sewage Disposal:  
 Public  
 Private  
 Electric Yes  No   
 Gas Yes  No   
 Heating System:  
 Electric  Oil   
 Natural Gas   
 Propane Gas   
 Sprinkler system: N/A   
 NFPA #13D  
 NFPA #13R  
 Other:

THE UNDERSIGNED HEREBY CERTIFIES AND AGREES AS FOLLOWS: (1) THAT HE/SHE IS AUTHORIZED TO MAKE THIS APPLICATION; (2) THAT THE INFORMATION IS CORRECT; (3) THAT HE/SHE WILL COMPLY WITH ALL REGULATIONS OF HOWARD COUNTY WHICH ARE APPLICABLE THERETO; (4) THAT HE/SHE WILL PERFORM NO WORK ON THE ABOVE REFERENCED PROPERTY NOT SPECIFICALLY DESCRIBED IN THIS APPLICATION; (5) THAT HE/SHE GRANTS COUNTY OFFICIALS THE RIGHT TO ENTER ONTO THIS PROPERTY FOR THE PURPOSE OF INSPECTING THE WORK PERMITTED AND POSTING NOTICES.

Applicant's Signature: [Signature]

Print Name Jeremy Clancy  
 Date 7/2/03

Title/Company MR 7/2/03


Checks payable to: **DIRECTOR OF FINANCE OF HOWARD COUNTY**  
 \*\* PLEASE WRITE NEATLY AND LEGIBLY. \*\*  
 - FOR OFFICE USE ONLY -

PROP. SUN PORCH OK  
MR 7/2/03

RECEIVED

JUL 02 2003

HOWARD COUNTY HEALTH DEPT.  
BUREAU OF ENVIRONMENTAL HEALTH

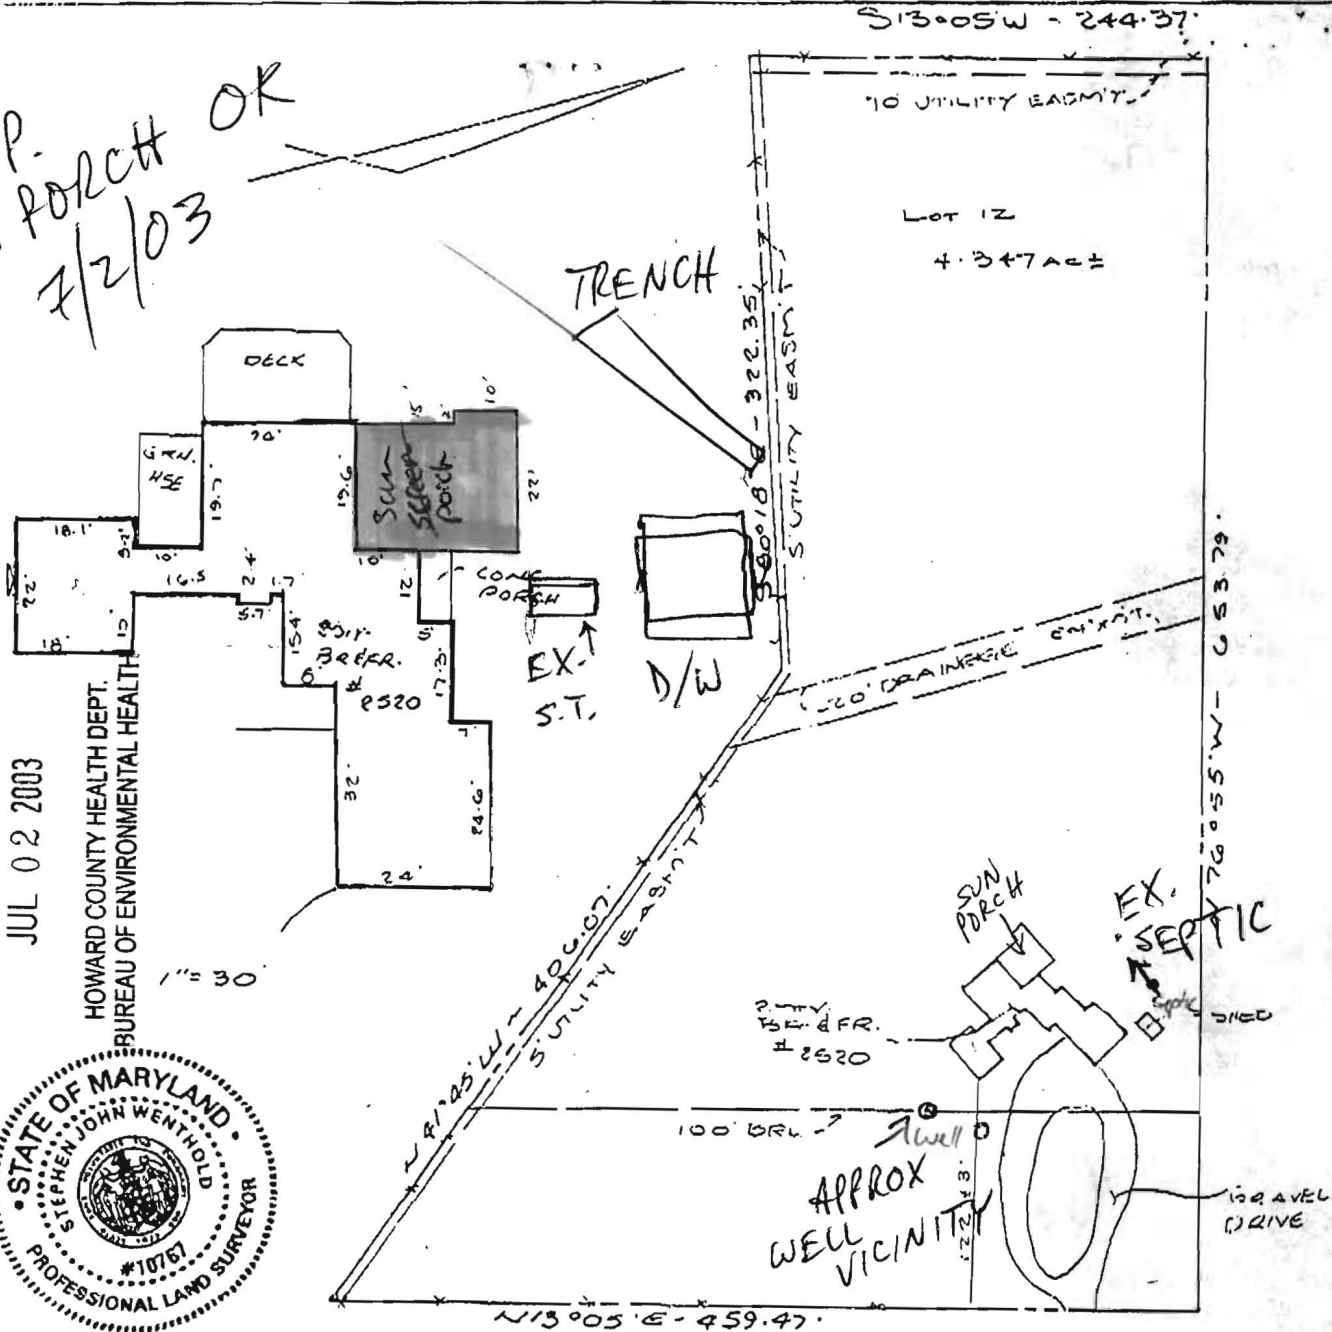

Date: 6-5-03  
Plat Book: 8  
Plat No.: 93  
Work Order: 03-2852  
Address: 2520 DAISY ROAD  
District: 4  
Jurisdiction: HOWARD COUNTY, MD

Scale: 1"=100' Dwn: SJW  
NO TITLE REPORT FURNISHED

Surveyor's Certification

I hereby certify that the survey shown hereon is correct to the best of my knowledge and that, unless noted otherwise, it has been prepared utilizing description of record. This survey is not a boundary survey and the location of existence of property corners is neither guaranteed nor implied. Fence lines if shown, are approximate in location. This property does not lie within a 100 year flood plain according to FEMA insurance maps as interpreted by the originator unless otherwise shown hereon. Building restriction lines shown are as per available information and are subject to the interpretation of the originator.

*Stephen J. Wenthold*

LOCATION DRAWING  
LOT 12  
RIVER FARMS  
SECTION 1

NOTE: This plat is of benefit to a consumer only insofar as it is required by a lender or a title insurance company or its agent in connection with contemplated transfer, financing or refinancing. This plat is not to be relied upon for the establishment or location of fences, garages, buildings, or other existing or future improvements. This plat does not provide for the accurate identification of property boundary lines, but such identification may not be required for the



Meridian Surveys, Inc.  
811 Russell Avenue  
Suite #303  
Gaithersburg, MD 20879  
(301) 721-9400