

*Permit*

# APPLICATION

A 29011

SEWAGE DISPOSAL TESTING

STATE OF MARYLAND - DEPARTMENT OF HEALTH AND MENTAL HYGIENE

P \_\_\_\_\_

HOWARD COUNTY HEALTH DEPARTMENT  
ENVIRONMENTAL HEALTH SERVICES  
P.O. BOX 476 ELLICOTT, MARYLAND 21043  
TELEPHONE: 992-2330

DISTRICT 5th

*⊗ See attached sheet for specs.*

DATE 10/11/78

TO: THE COUNTY HEALTH OFFICER  
ELLICOTT CITY, MARYLAND

I, HEREBY, APPLY FOR THE NECESSARY TEST IN ORDER TO CONSTRUCT (OR RECONSTRUCT) A SEWAGE DISPOSAL SYSTEM

PROPERTY OWNER Archie W. Broadwater David J. Buscher

ADDRESS 5435 Broadwater Lane, Clarksville, Md. 21029 PHONE 593-9243  
Silver Spring, Md 20901

PROPERTY LOCATION

SUBDIVISION Broadwater Estates LOT NO. 2

ROAD AND DESCRIPTION off Broadwater Lane 5673 Chamblis Drive

SIZE OF LOT 3.0 acres m/1 TYPE BLDG. 3 or 4 bedrooms

THE SYSTEM INSTALLED UNDER THIS APPLICATION IS ACCEPTABLE ONLY UNTIL PUBLIC FACILITIES BECOME AVAILABLE.

I FULLY UNDERSTAND THE FEE CONNECTED WITH THE FILING OF THIS PERC TEST APPLICATION IS NON-REFUNDABLE UNDER

ANY CIRCUMSTANCES.

SIGNATURE OF APPLICANT /s/ Jack T. Gibson

APPROVED BY C. B. Streaker FOR ⊗ Dry Well 4' x 10' + French DATE 12/31/79

REJECTED BY \_\_\_\_\_ FOR \_\_\_\_\_ DATE \_\_\_\_\_

HOLD PENDING FURTHER TESTS \_\_\_\_\_ DATE \_\_\_\_\_



REASONS FOR REJECTION OR HOLDING \_\_\_\_\_

BLDG. PERMIT SIGNED  
AND RETURNED 7/25/84  
Serial # 60814 SF10.

# THIS IS NOT A PERMIT

# 2

SOIL PROFILE

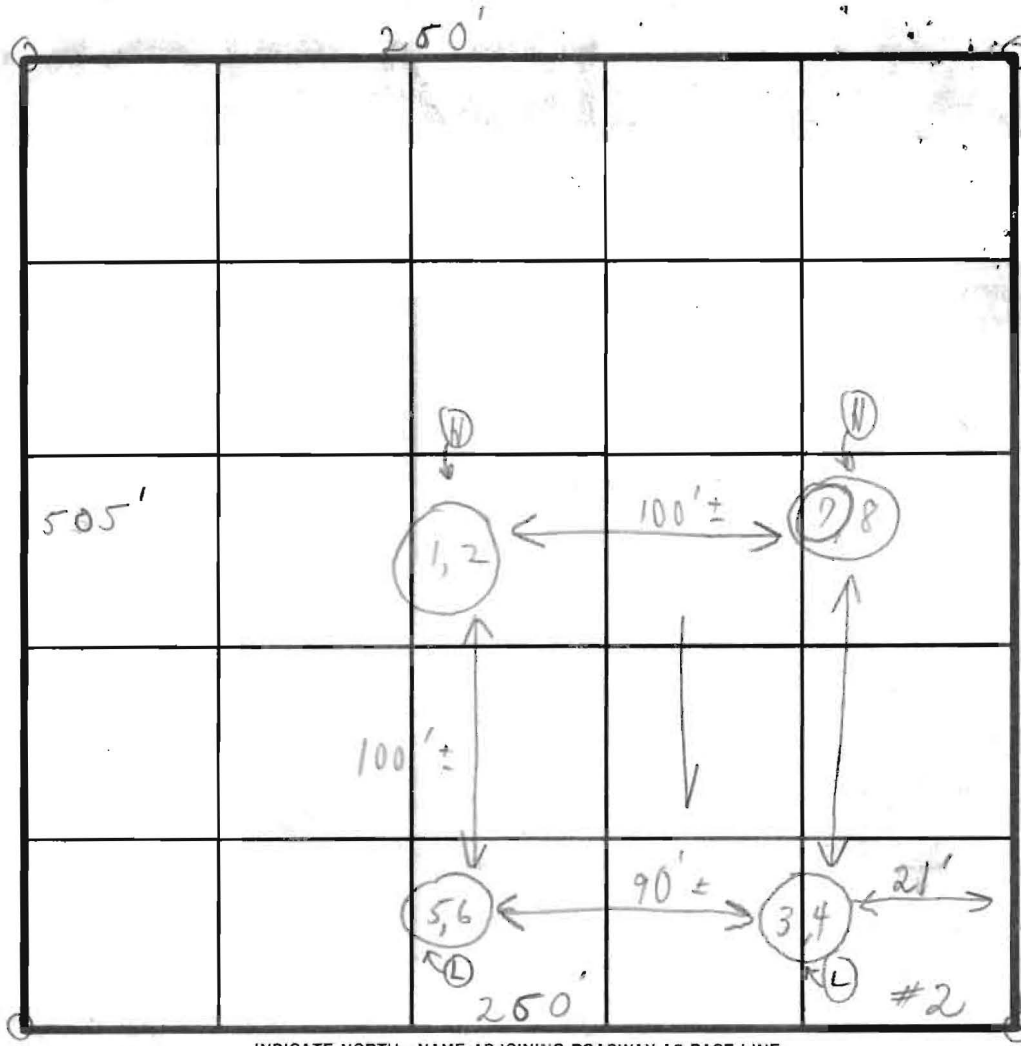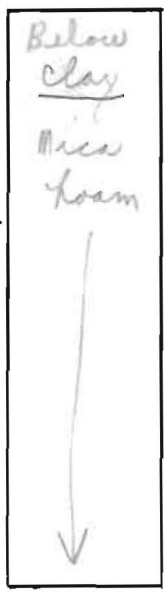

Field site  
Tests per stake

INDICATE NORTH - NAME ADJOINING ROADWAY AS BASE LINE.

← Unnamed Road →

DATE	TEST NO.	DEPTH	PRE-WET		TEST - 1" DROP		TIME
			START	STOP	START	STOP	
11/22/78	1(?)	4'	10:33	10:35	10:35	10:37	1 1/2 min
	Ⓜ 2	9 1/2'	10:34	10:38	10:38	10:45	7 min
	3	4'	10:10	10:13	10:13	10:18	5 min
	Ⓛ 4	9'	10:11	10:18	10:18	10:29	11 min
	5	4 1/2'	10:21	10:23	10:23	10:25	2 min
	Ⓛ 6	9'	10:23	10:26	10:26	10:30	4 min
	Ⓡ 7	6'	10:40	10:42	10:42	10:44	2 min
	Ⓜ 8	9 1/2'	10:43	10:46	10:46	10:53	7 min

13' deep {  
12' deep {  
12' deep {  
12 1/2' deep {  
met 3 1/2' 4 1/2' mat. 10

REMARKS Tests in high grass (1 lot only)

TYPE OF SOIL

TESTED BY C. B. only ALSO PRESENT { 3 of 11/20; 11/24/78