

July 18, 1984

Mr. David J. Buscher
428 Belton Road
Silver Spring, Maryland 20901

RE: Building Permit Application
Serial Number 60014

Dear Mr. Buscher:

This office has received the above referenced building permit application, but cannot sign-off our approval until a more detailed site plan is received and reviewed.

I have enclosed information useful in preparing this plan.

If you have any questions regarding this matter, please call me at 992-2330.

Very truly yours,



Frank Skinner, Director
Water and Sewerage Program

FS:jr

Enclosures

cc: Bureau of Licenses, Inspections and Permits

7/20/84 T.C. E Mr. Buscher re. Acker. Homej Reg'd. FS

PLAT MAP


OWNER
DAVID J. BUSCHER
428 BELTOW RD
S. S. M D 20901
(301) 593-9243

259.61 ft

506.89 ft

510.46 ft

7/18/84
Sketch completed
F. J.

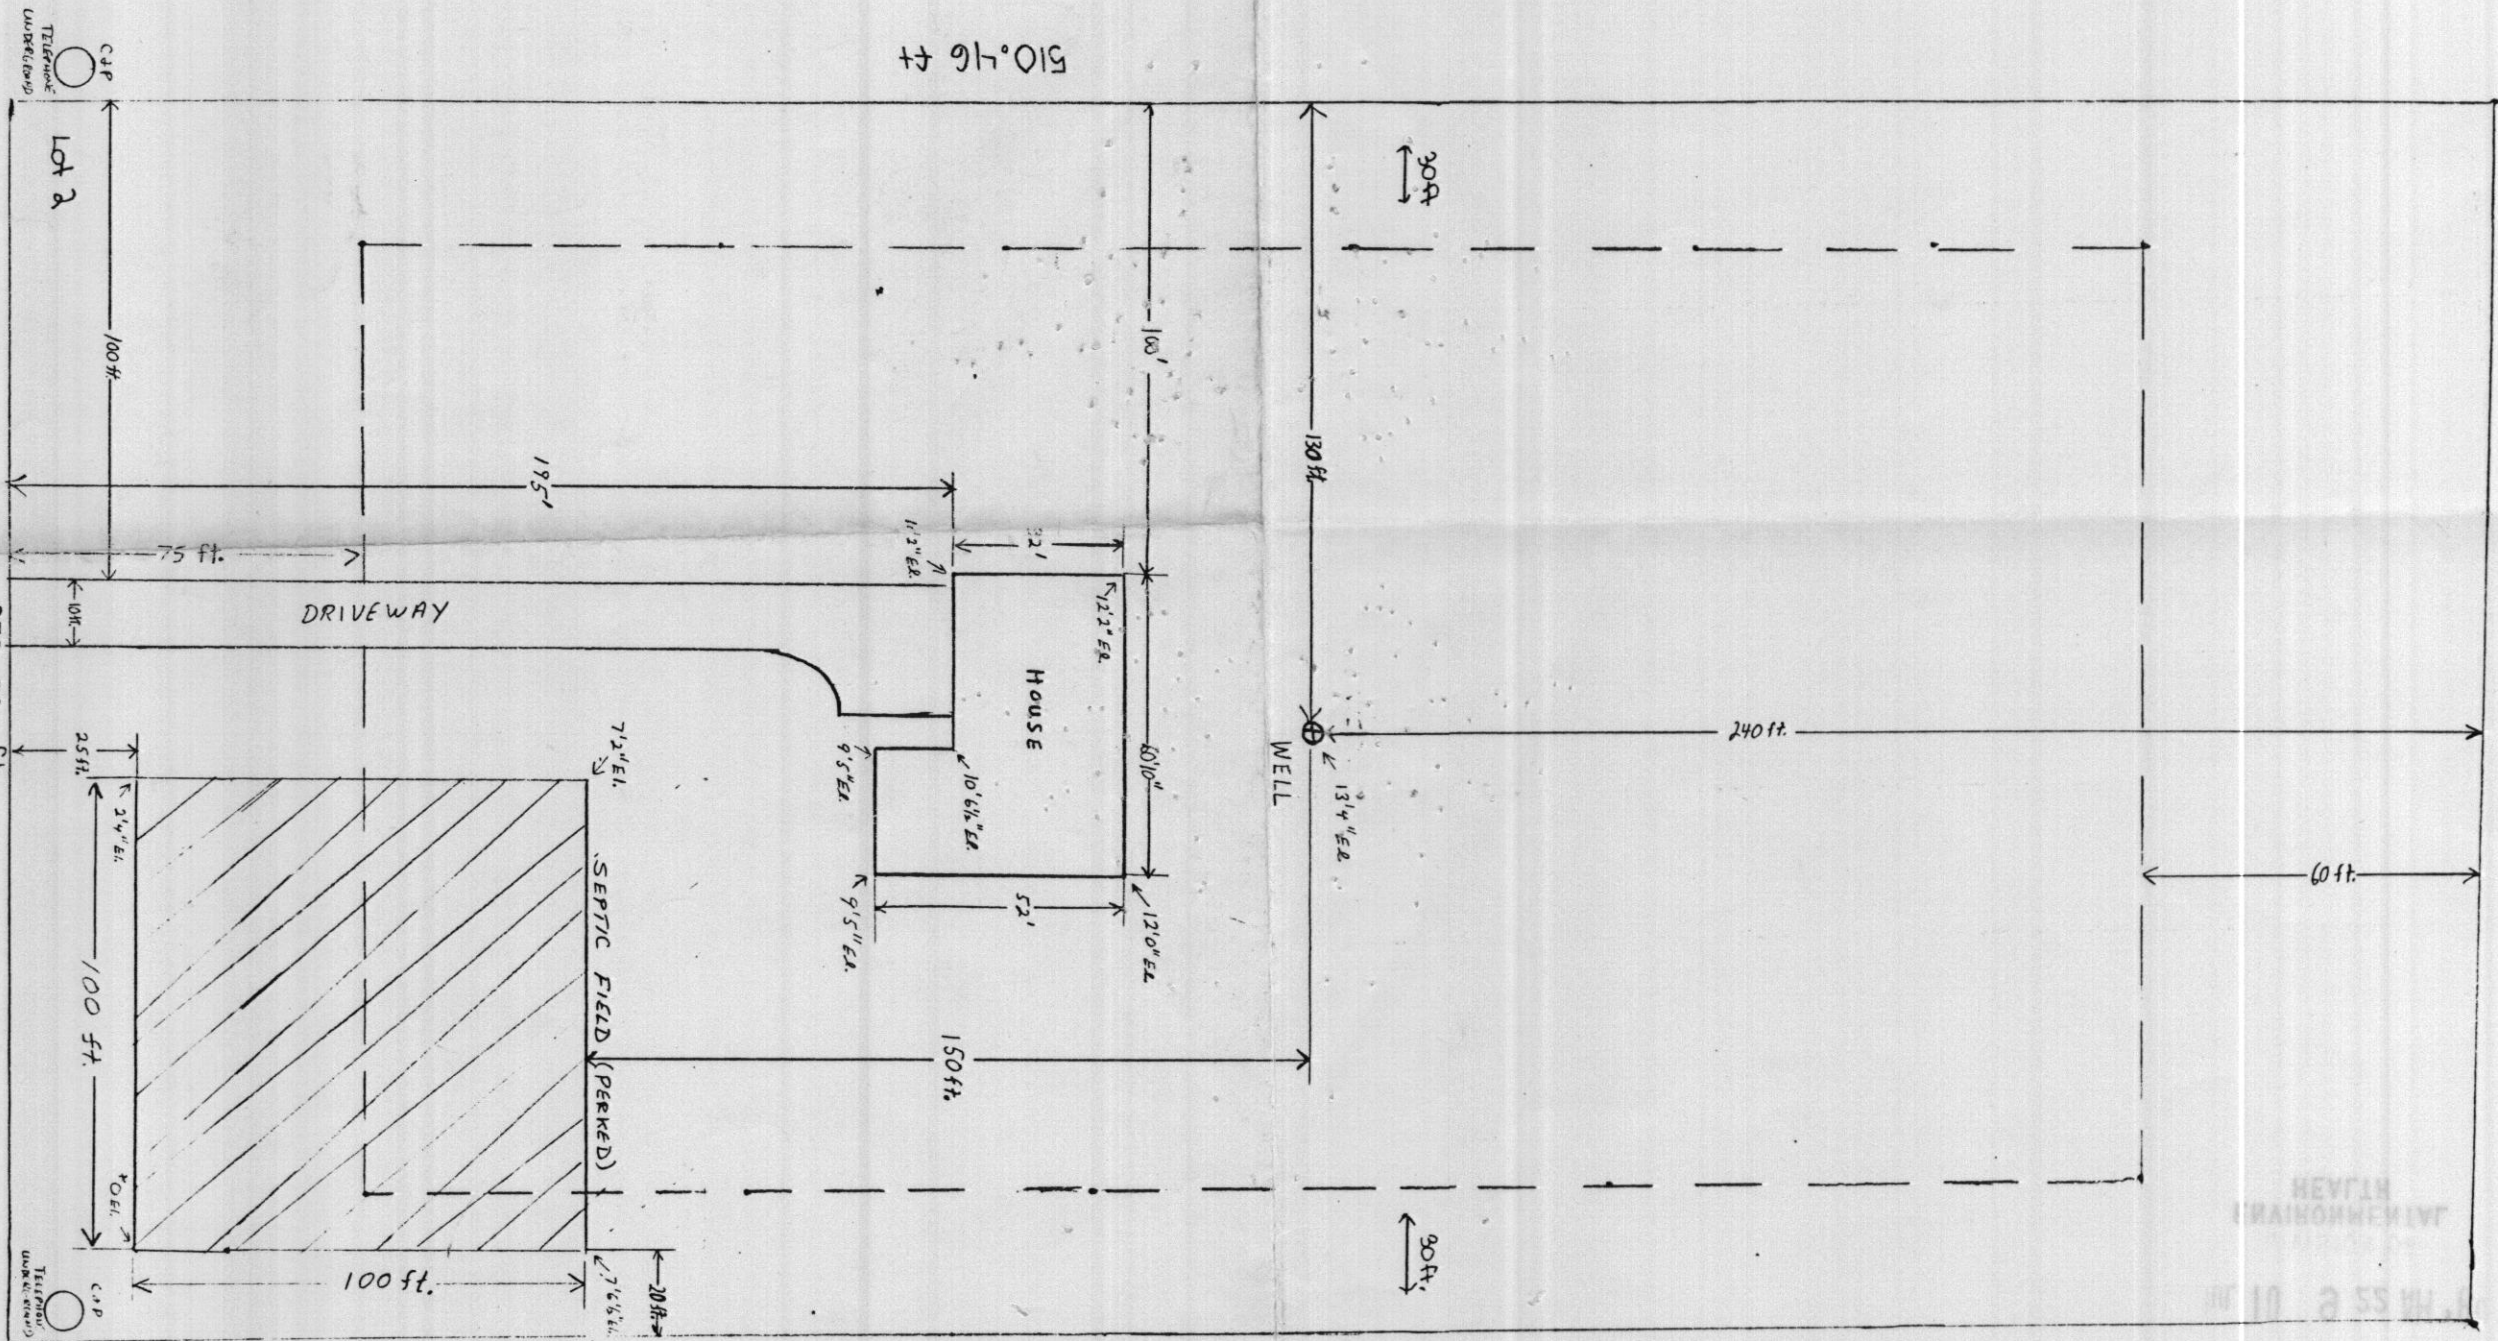

GAS
ELECTR.
CABLE
SERVICE

* ALL ELEVATIONS RELATIVE TO THIS POINT *

5673 DRIVE
CHAMBLIS
CLARKSVILLE, MARYLAND
LOT 2 BROADWATER ESTATES




PLAT MAP

BUILDING PERMIT
60014

OWNER
DAVID J. BUSCHER
428 BELTON RD
S. C. MD 20901
201-373-8243

259.61 ft

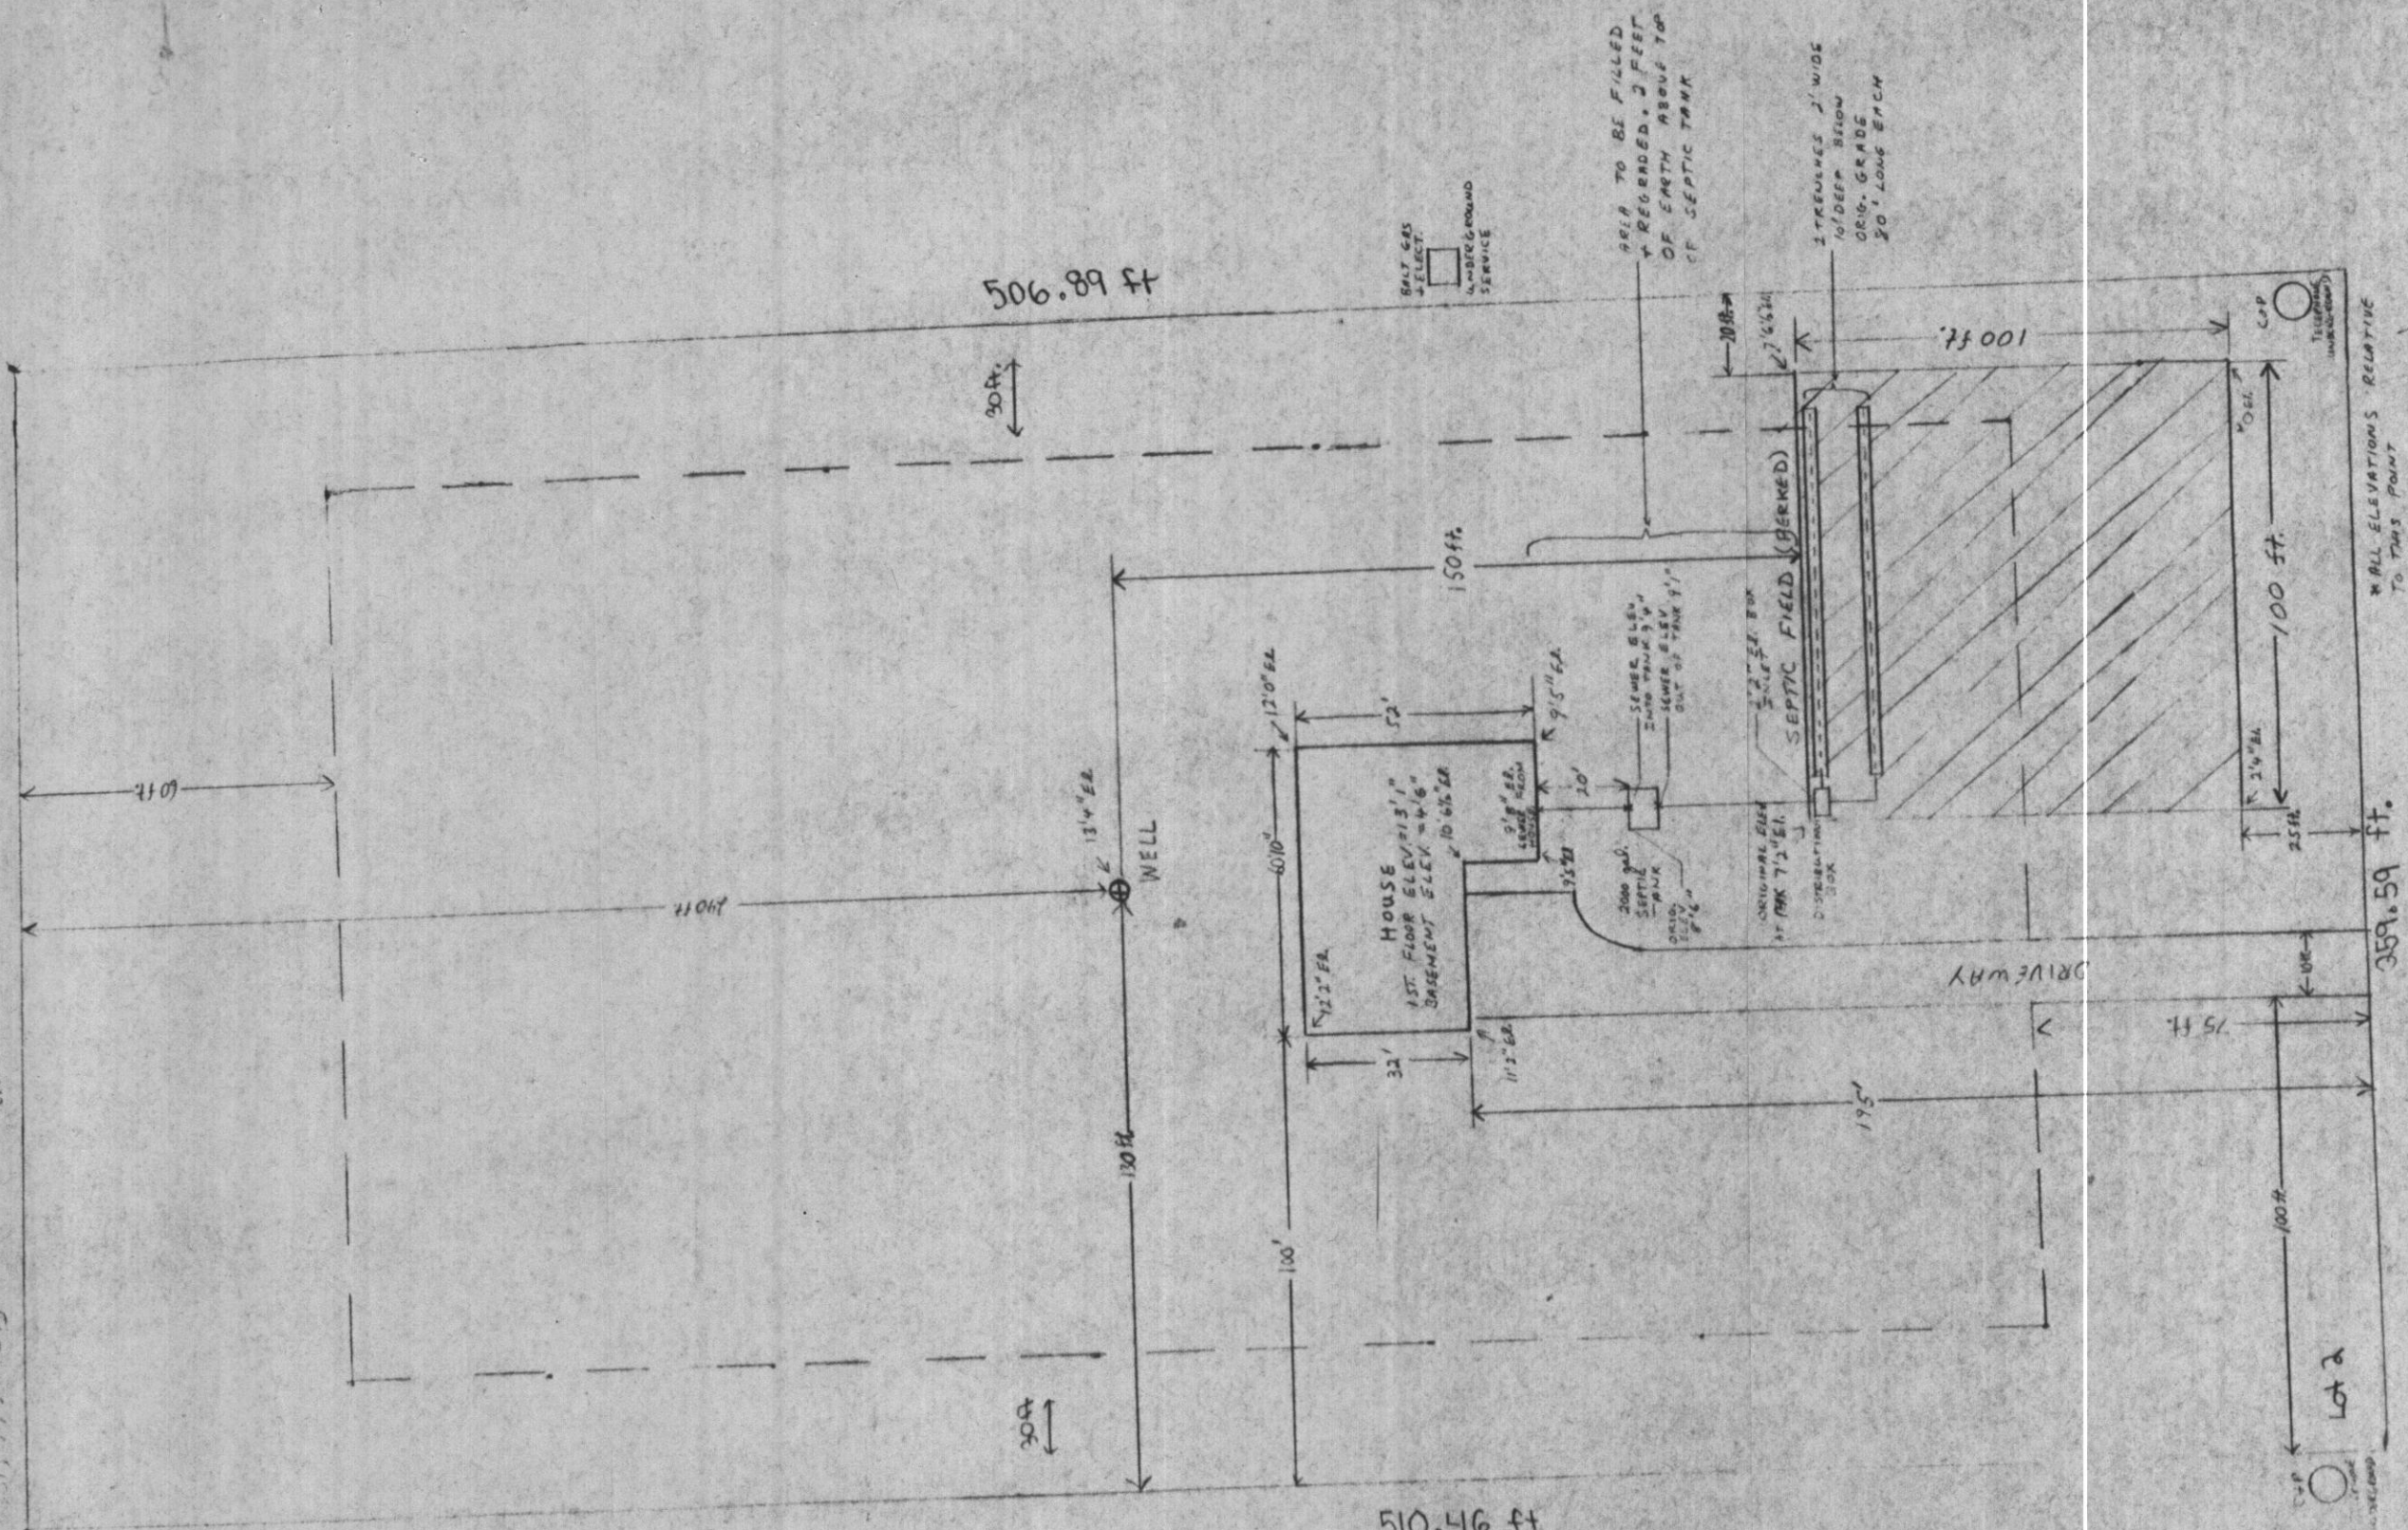

5673
CHAMBLIS DRIVE
CLARKSVILLE, MARYLAND
LOT 2 BROADWATER ESTATES

