

DAVE & LAURETTA
BUSCHER
5673 CHAMBLIS DR.
CLARKSVILLE, MD.
21029


Henry Monroe Builders Inc
Custom Home Builders
5682 Chamblis Drive
Clarksville, Maryland 21029
301-854-0750
301-980-8778

7/17/03
OK SRK

BOD 143065

5/8/03

POOL HOUSE
PROPOSED
CONST.
OK SRK

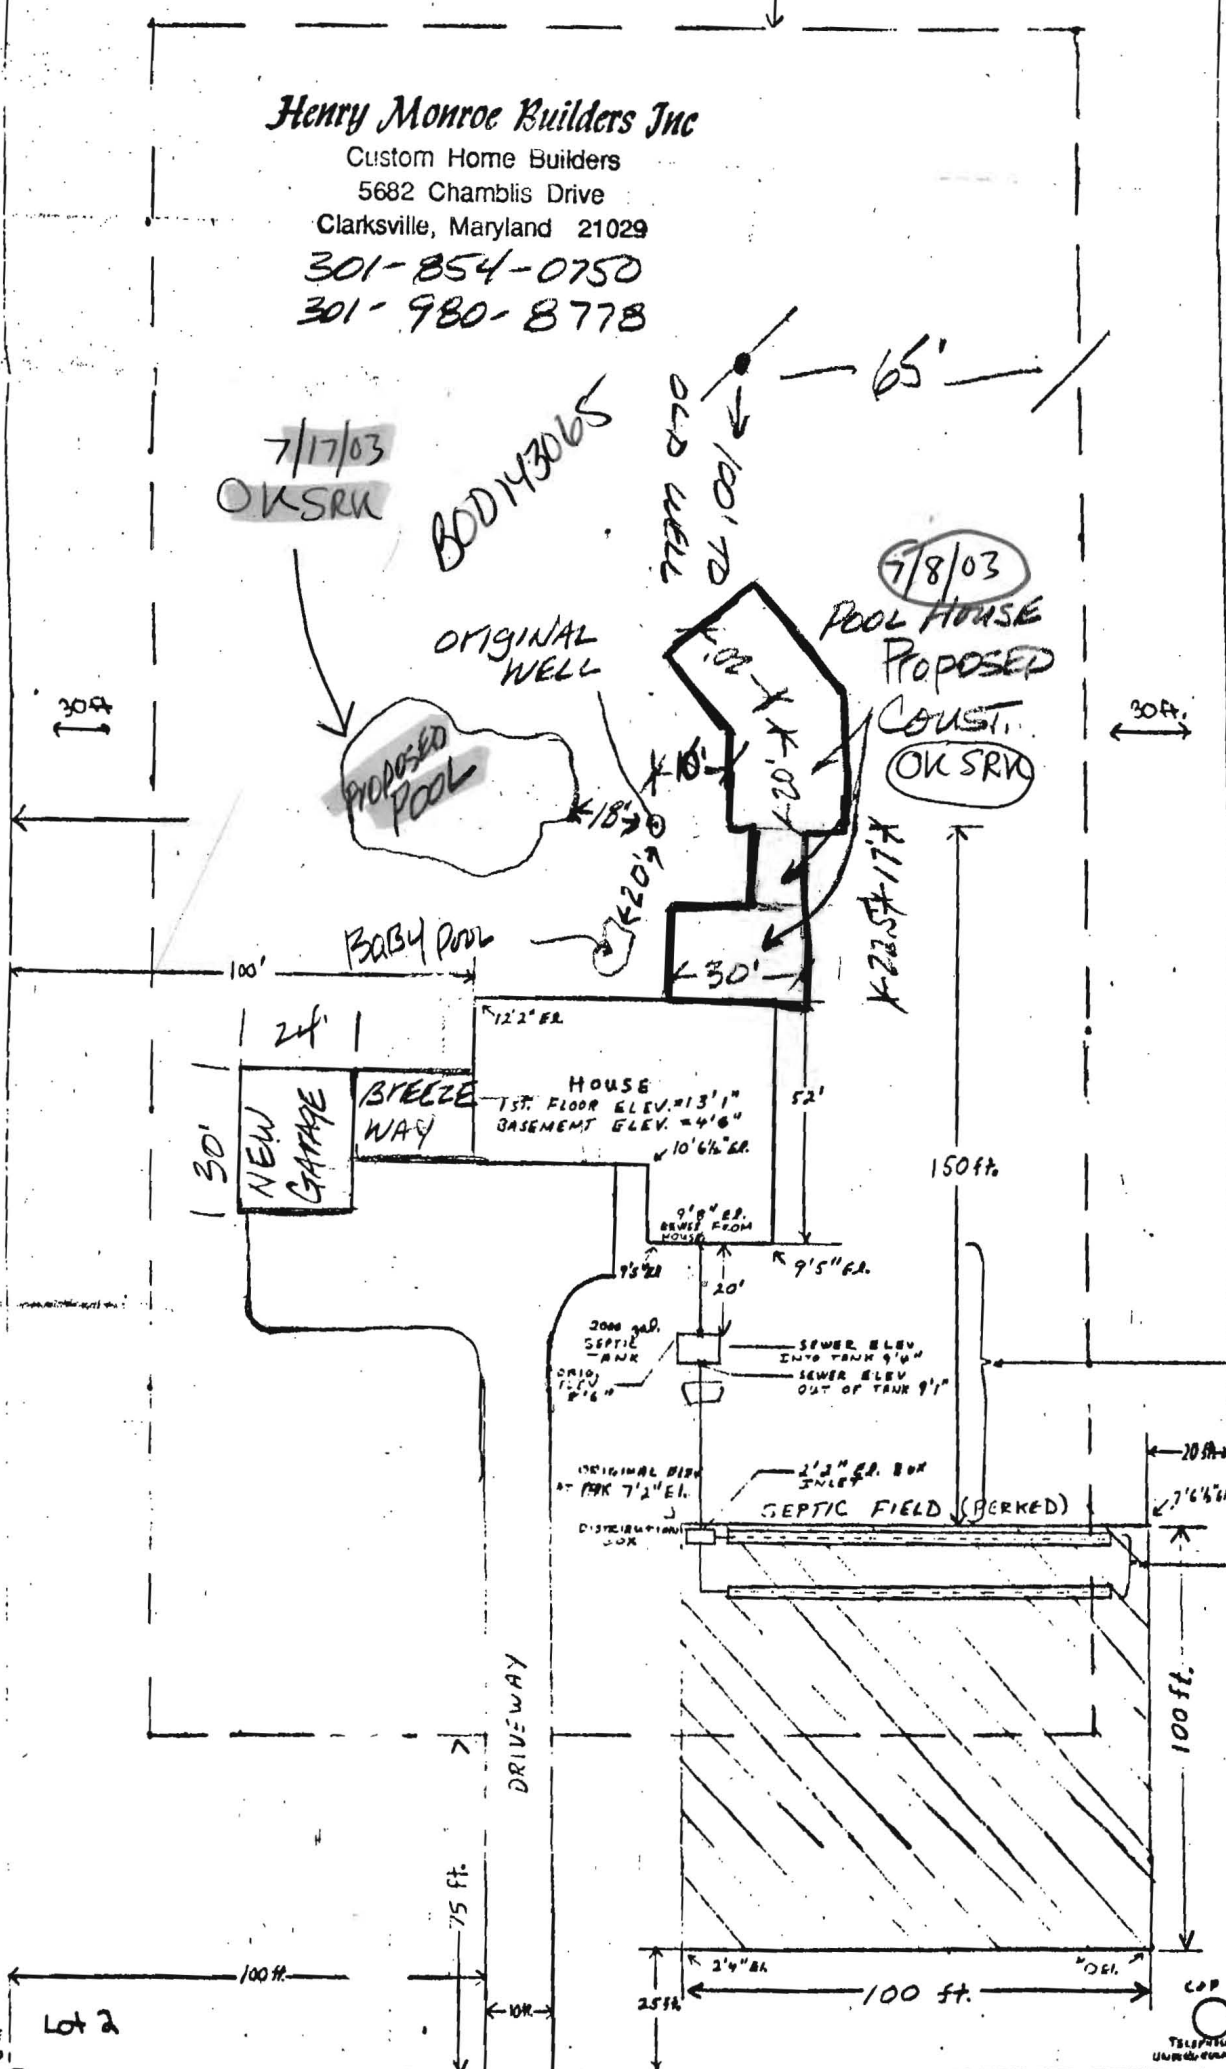

510.416 FT

506.89 FT

SOFT GAS + ELECT.
UNDERGROUND SERVICE

AREA + REG.
OF GAS
SP. SET

3' STR.
10' DEC.
ORIG.
30' L

COF


Lot 2

COF
TELEPHONE
UNDERGROUND

359.59 ft.

* ALL ELEVATIONS RELATIVE
TO THIS POINT

5673

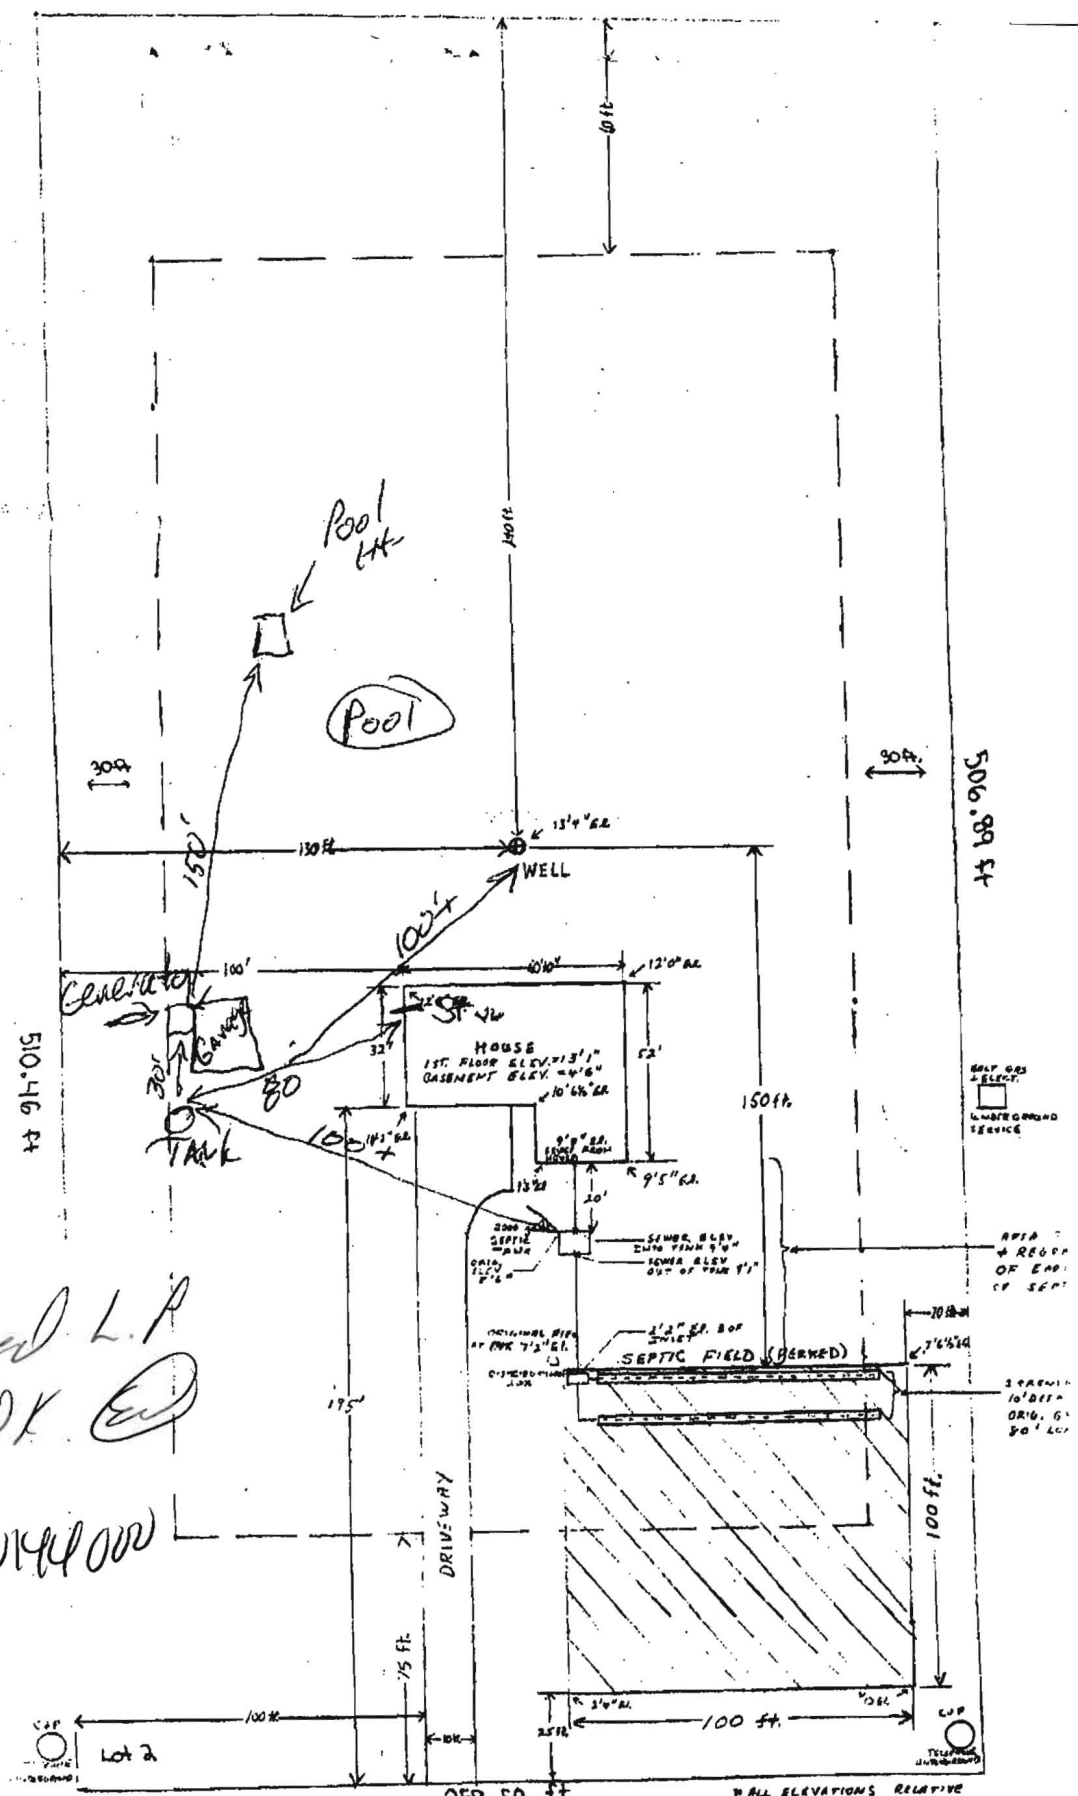


9/16/03
 Proposed L.P
 Tank OK. (E)

BOUYKOR

5673
 CHAMBLIS DRIVE
 CLARKSVILLE, MARYLAND
 LOT 2 BROADWATER ESTATES

B00142816

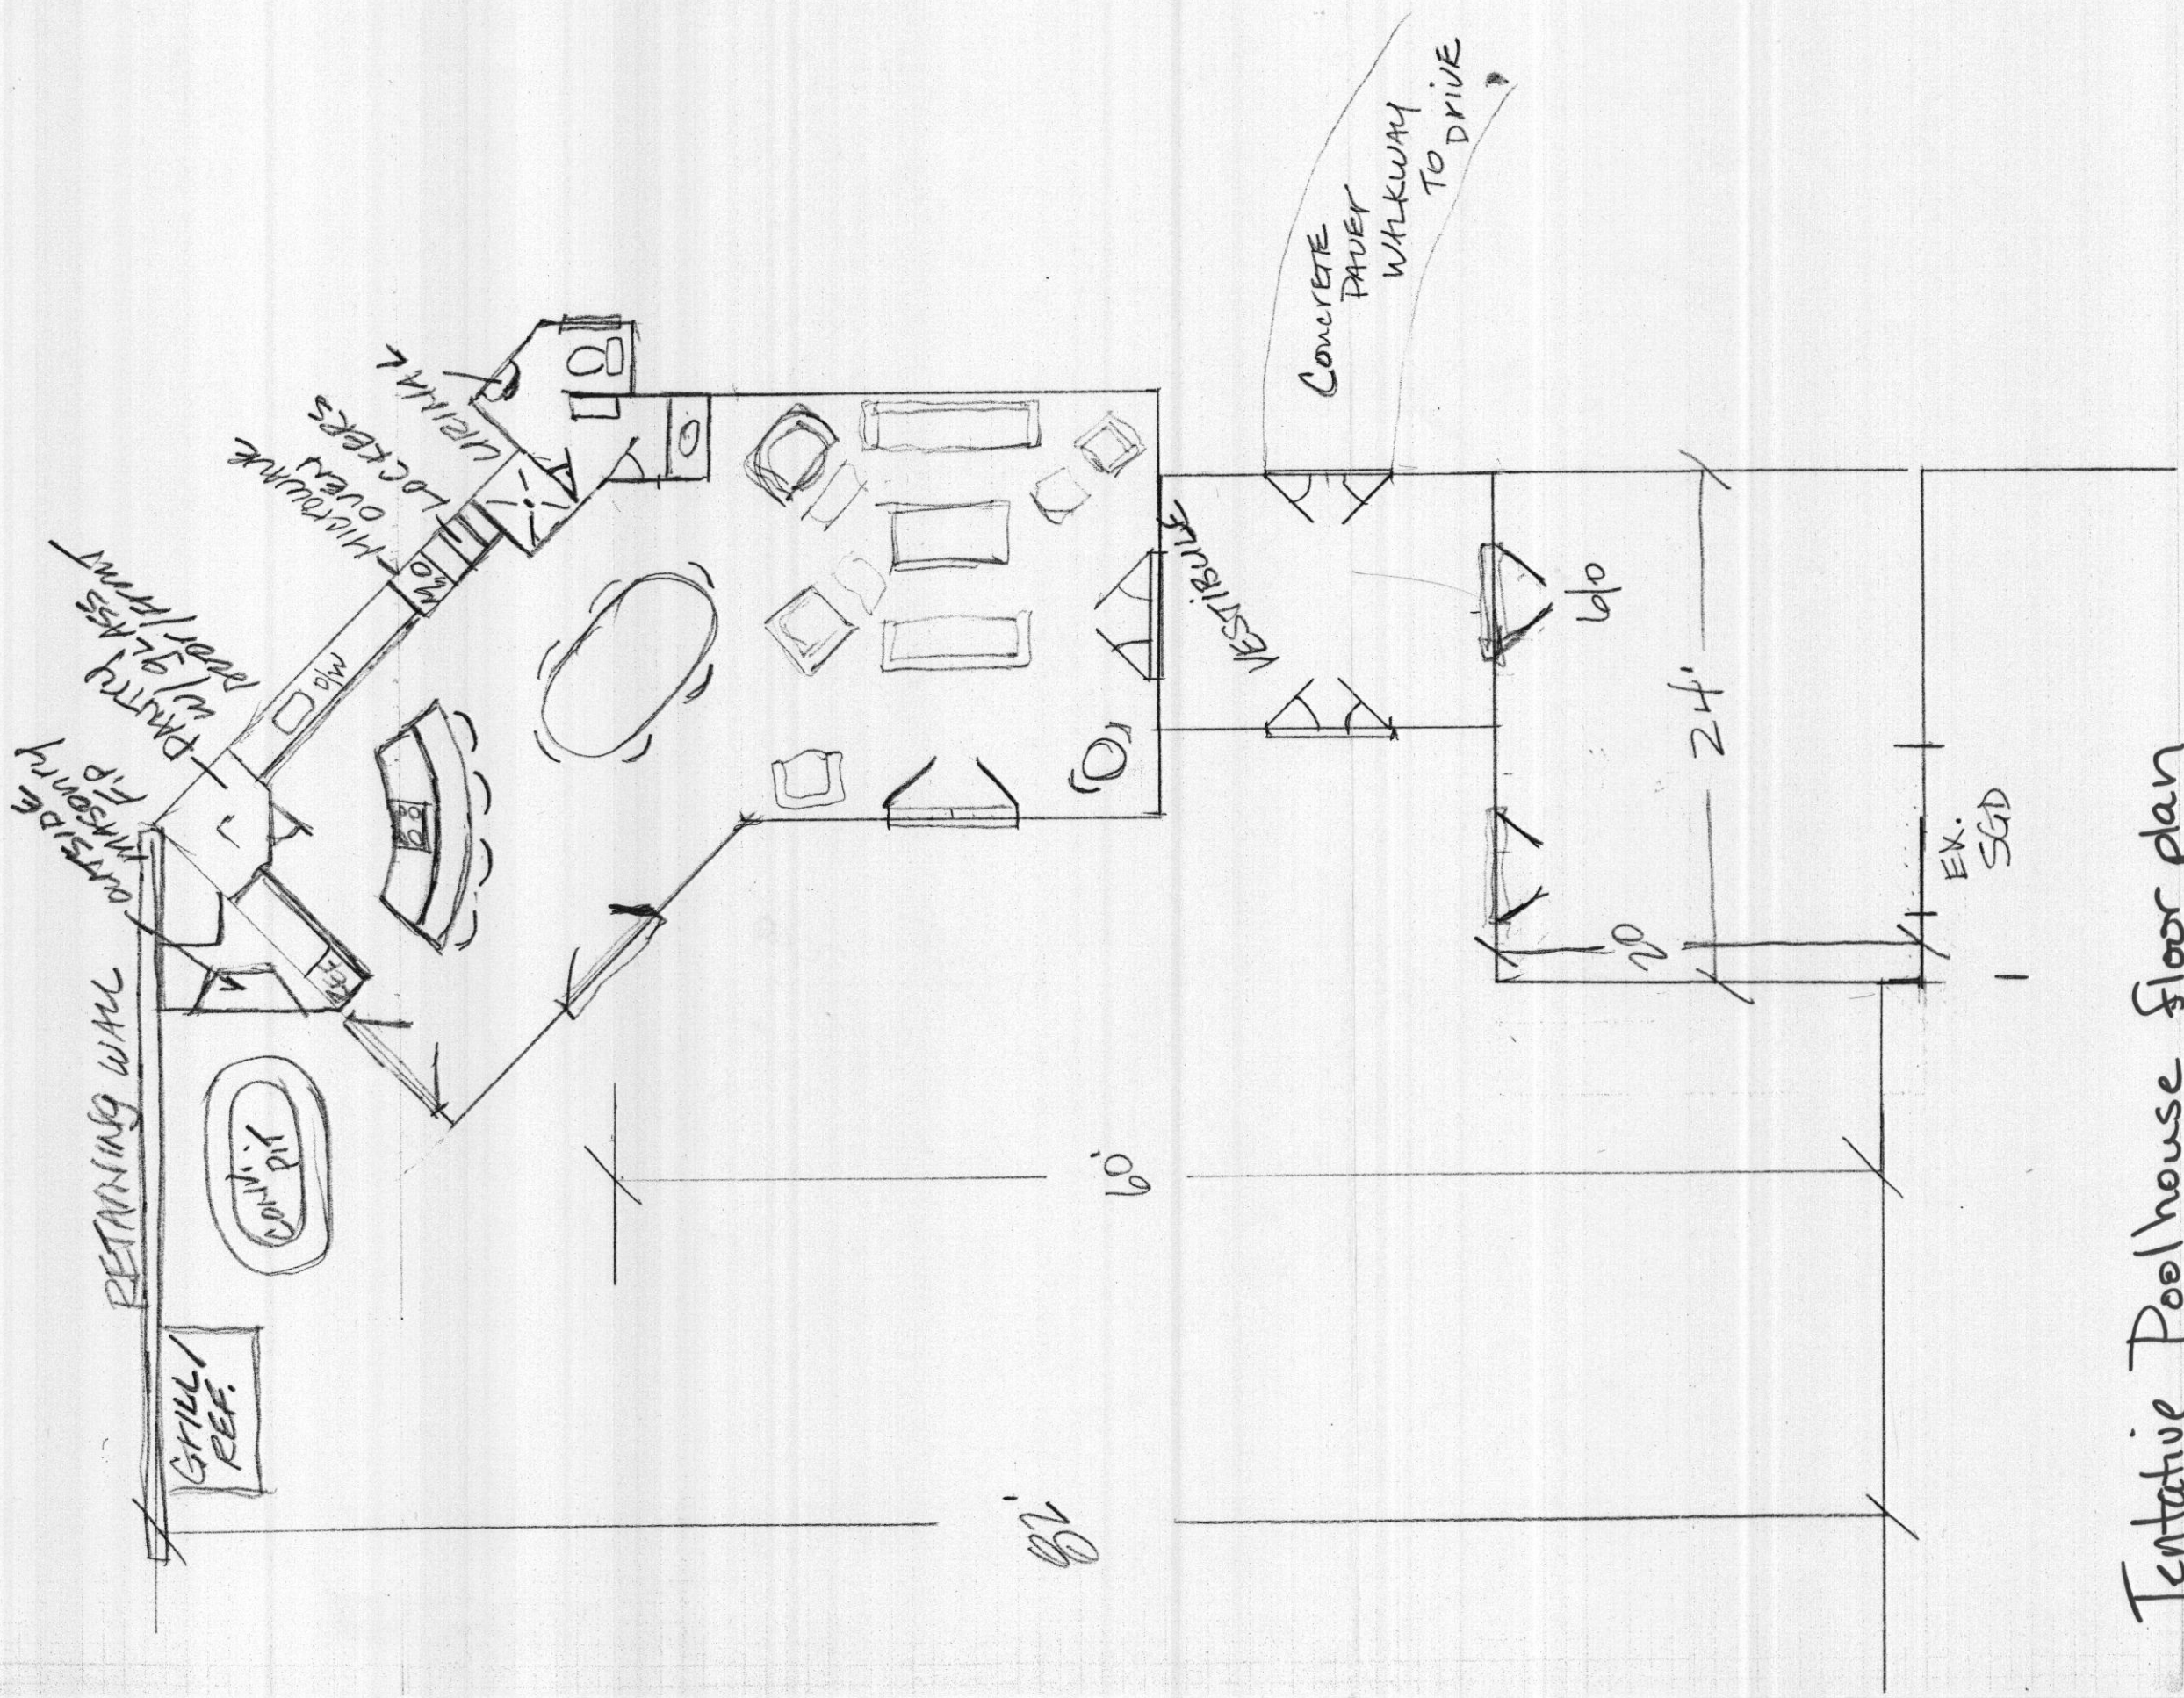

Tentative Poolhouse floor plan