

5/5/04 - 10:30

5/6/04 2-2:30

PUB. SEWER STATUS VERIFIED BY \_\_\_\_\_

ISSUE DATE: 3/9/2004

# PERMIT

P 520084

APPROVAL DATE: 5/7/04

## INDEXED

A 519060-UPGRADE

### ON-SITE SEWAGE DISPOSAL SYSTEM HOWARD COUNTY HEALTH DEPARTMENT BUREAU OF ENVIRONMENTAL HEALTH

02-190702

Louis Charles Dibartolomeo, Jr. IS PERMITTED TO INSTALL  ALTER

ADDRESS: 8595 Old Frederick Rd, Ellicott City PHONE NUMBER: 410-596-8741

SUBDIVISION: \_\_\_\_\_ LOT NUMBER: TM 18, P. 7

ADDRESS: 8595 Old Frederick Road PROPERTY OWNER: Louis Dibartolomeo

SEPTIC TANK CAPACITY (GALLONS): 1500

PUMP CHAMBER CAPACITY (GALLONS): \_\_\_\_\_

NUMBER OF BEDROOMS: 5

SQUARE FEET PER BEDROOM: 180

LINEAR FEET OF TRENCH REQUIRED: 300

TRENCHES:	Trench to be 3.0 feet wide. Inlet 3.5 feet below original grade. Bottom maximum depth 5.5 feet below original grade. Effective area begins at 5.0 feet below original grade. 2.0 feet of stone below distribution pipe.
LOCATION:	Install distribution box as close as possible to existing drywell. Run trenches on contour to front of lot.
PURPOSE:	Pump and collapse existing tank and drywell. Owner likely to request (2) 1000-gallon tanks. <i>In support of B00146937</i>

PLANS APPROVED: MER DATE: 12/4/03

- NOTE: PERMIT VOID AFTER 2 YEARS
- NOTE: CONTRACTOR RESPONSIBLE FOR SCHEDULING A PRE-CONSTRUCTION INSPECTION FOR ALL INSTALLATIONS
- NOTE: WATERTIGHT SEPTIC TANKS REQUIRED
- NOTE: ALL PARTS OF SEPTIC SYSTEM SHALL BE 100 FEET FROM ANY WATER WELL
- NOTE: MANHOLE RISERS REQUIRED ON ALL SEPTIC TANKS AND PUMP CHAMBERS

**NEITHER THE HOWARD COUNTY COUNCIL NOR THE HEALTH DEPARTMENT IS RESPONSIBLE FOR THE SUCCESSFUL OPERATION OF ANY SYSTEM PERMITTEE RESPONSIBLE FOR OBTAINING FINAL APPROVAL ON THIS PERMIT CALL 410-313-2640 FOR INSPECTION OF SEPTIC SYSTEM**


### BUILDING PERMIT SIGNED AND RETURNED

*5/24/2004 B00146937 2BR, 1BATH, UNFINISHED BASEMENT  
8/24/04 B0015251-FINISH BASEMENT*

A 519060

# Old Frederick Road

NOT TO SCALE

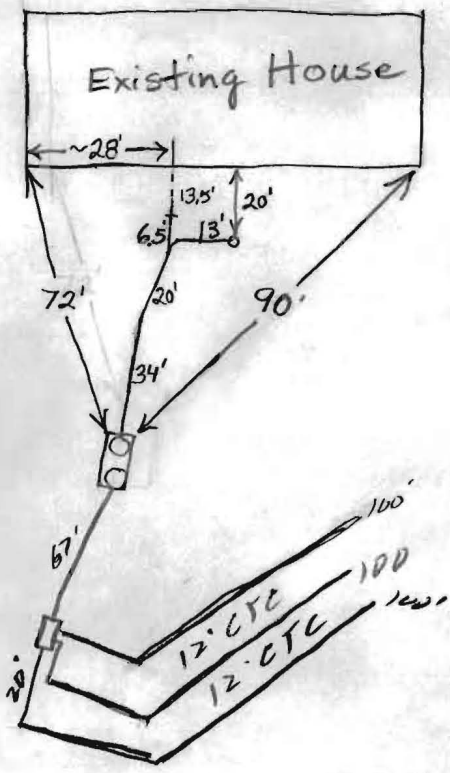

ROAD

TRENCH/DRAINFIELD DATA		
WIDTH	INLET	BOTTOM
3	3.5	5.5
NUMBER OF TRENCHES	3	
TOTAL LENGTH	300	
ABSORPTION AREA	900	
DISTRIBUTION BOX LEVEL	✓	
DISTRIBUTION BOX BAFFLE	✓	
DISTRIBUTION BOX PORT	-	

SEPTIC TANK DATA	
SEPTIC TANK 1 LEVEL	✓
CAPACITY	2000 GAL
SEAM LOC	Top
TANK LID DEPTH	2'
BAFFLES	✓
BAFFLE FILTER	No
MANHOLE LOC	Front+Back
6" PORT LOC	None
WATERTIGHT TEST	No
SEPTIC TANK 2 LEVEL	N/A
CAPACITY	GAL
SEAM LOC	
TANK LID DEPTH	
BAFFLES	
BAFFLE FILTER	
MANHOLE LOC	
6" PORT LOC	
WATERTIGHT TEST	

PRE-CONSTRUCTION 5/5/04 Tank set. Baffles need to be installed.  
 Old septic tank and drywell pumped out. Location of top  
 INSTALLATION trench laid out. Contractor to call office if  
 any problems laying out rest of system. Have to relocate  
 pile of firewood in septic easement, (BB)  
 5/6/04 - Old S.T. & P.W. abandoned. 2 trenches installed  
 OK to cover (SD) 5/7/04 - OK to cover all work so

BUILDING PERMIT SIGNED AND RETURNED

FINAL INSPECTOR [Signature] DATE OF APPROVAL 5/7/04